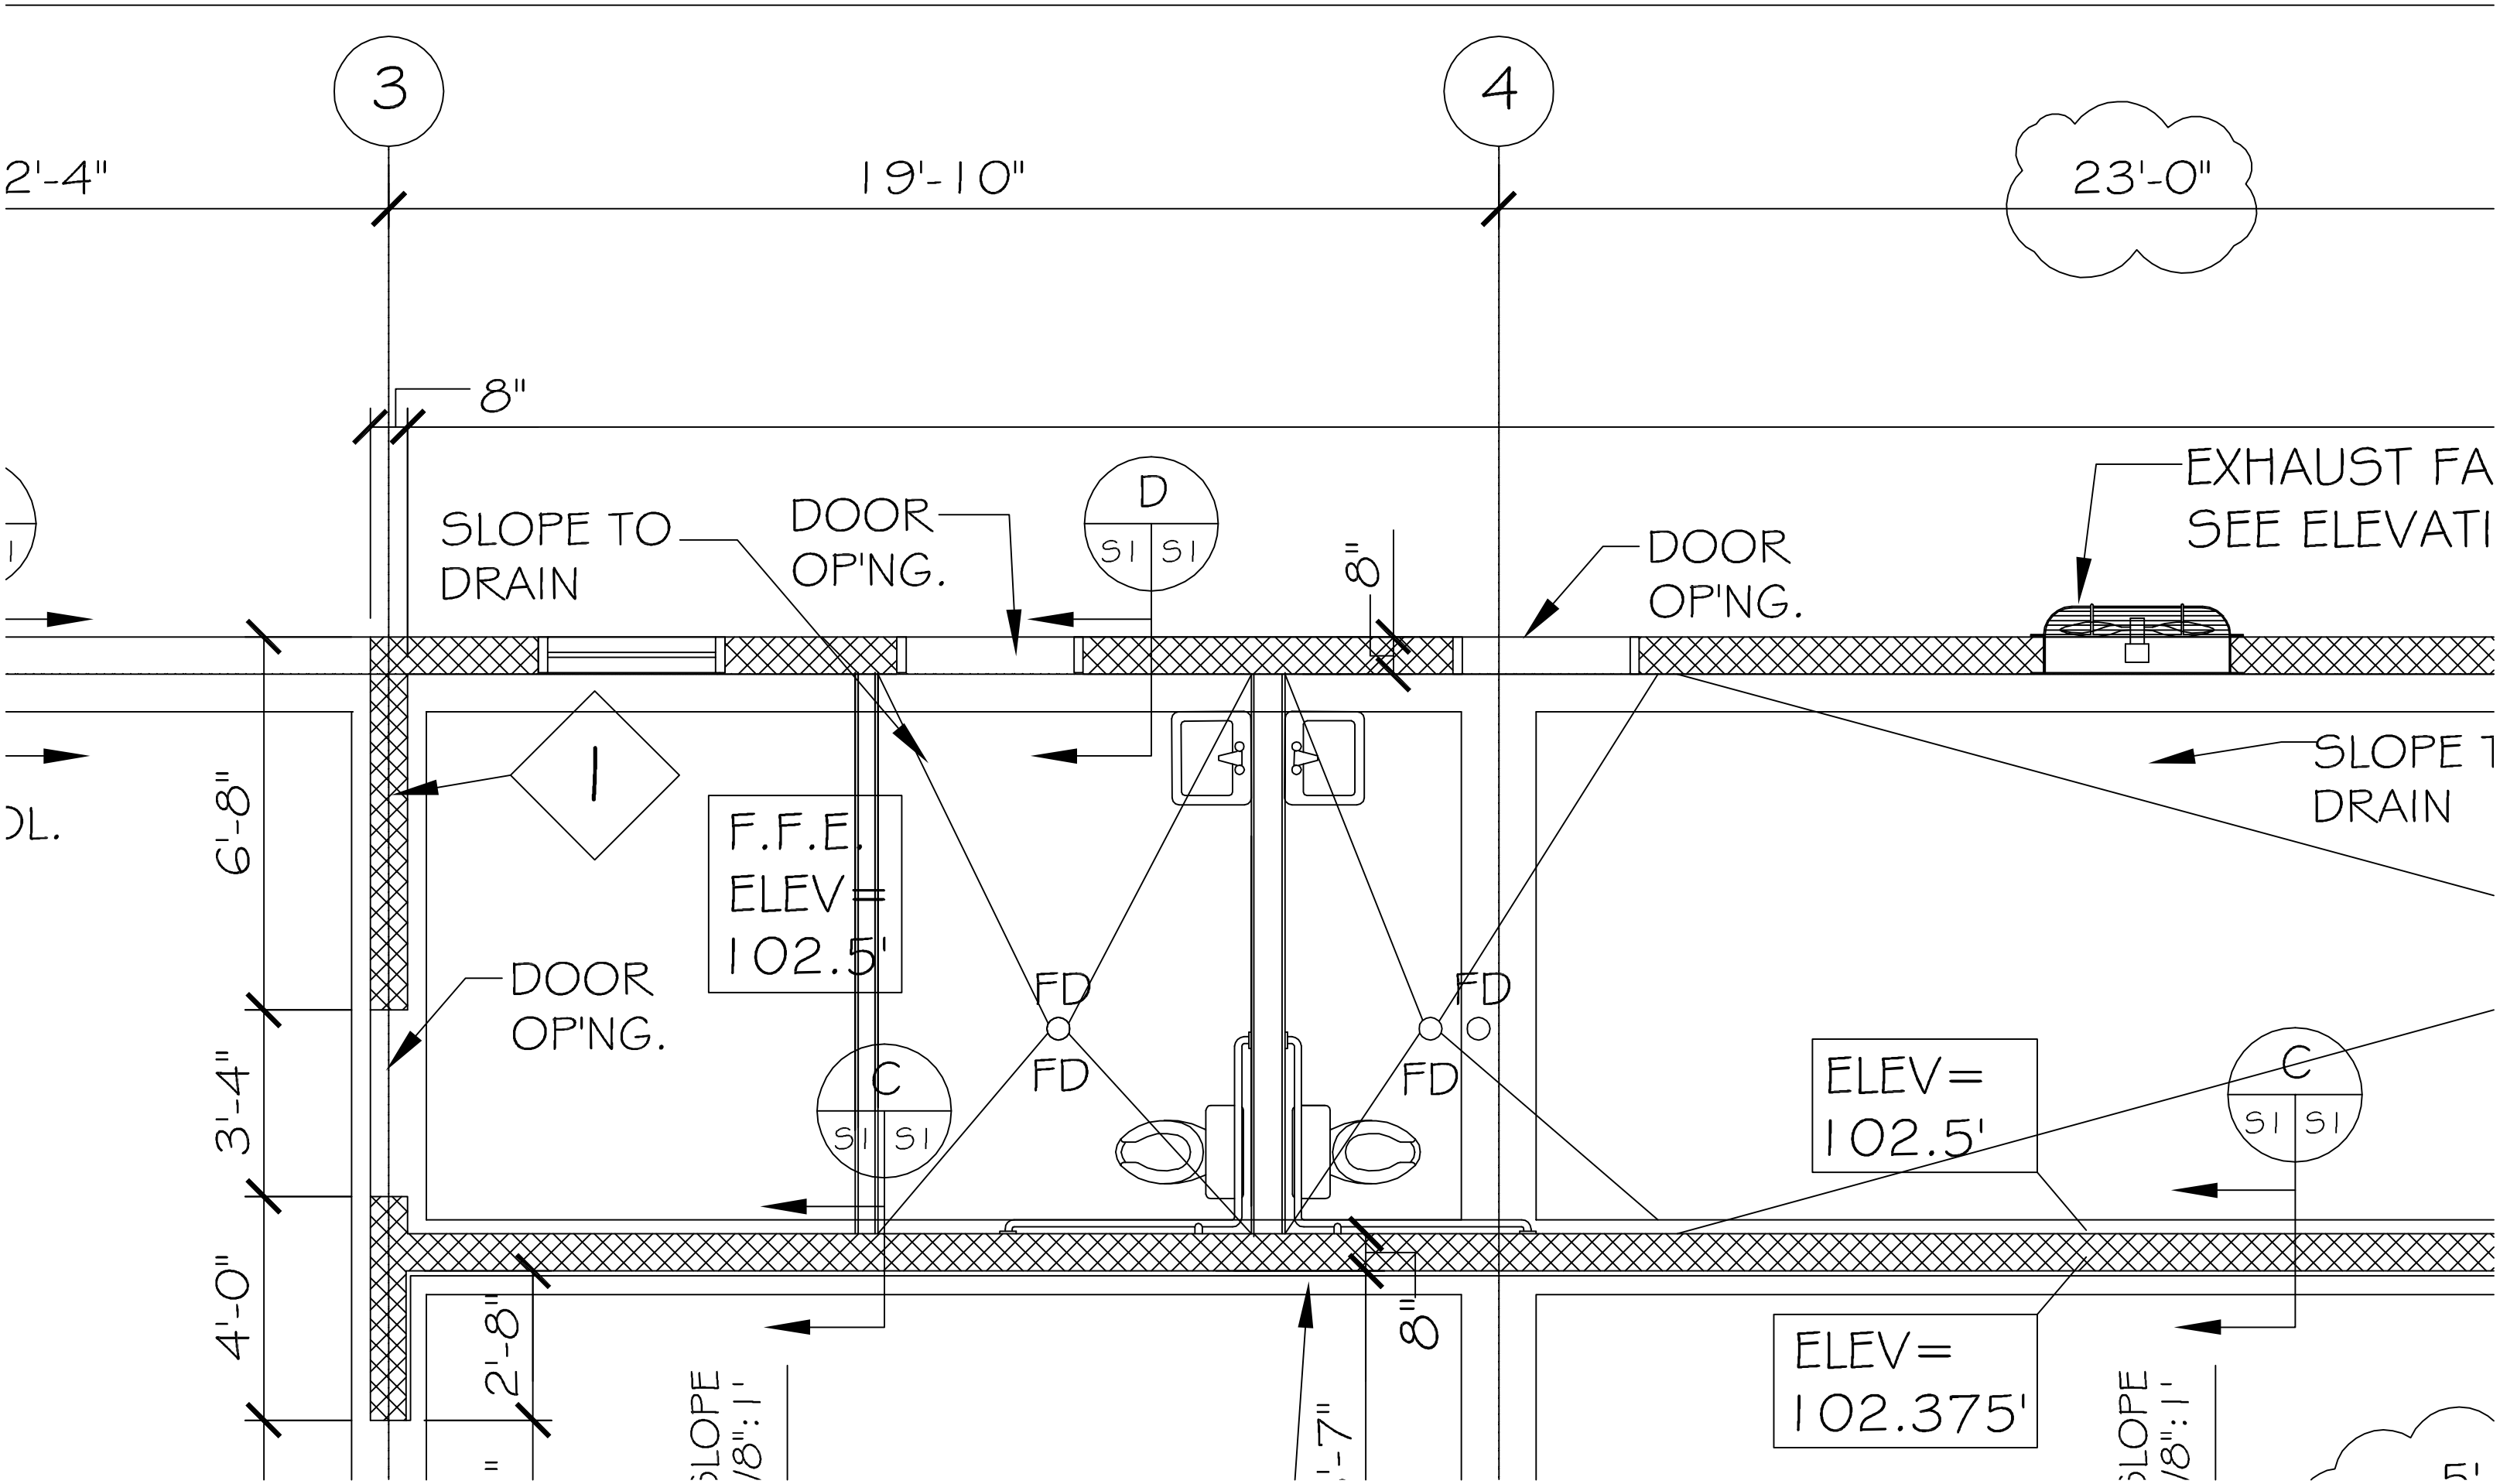
3
4
2'-4"
19'-10"
23'-0"
8"
SLOPE TO DRAIN
DOOR OP'NG.
D
S1 S1
8"
DOOR OP'NG.
EXHAUST FA
SEE ELEVATI
SLOPE T
DRAIN
1
F.F.E. ELEV= 102.5'
DOOR OP'NG.
FD
FD
FD
FD
C
S1 S1
ELEV= 102.5'
C
S1 S1
6'-8"
3'-4"
4'-0"
2'-8"
8"
ELEV= 102.375'
SLOPE 1/8":1'
SLOPE 1/8":1'