


* CONCRETE STRENGTH IS 4,800 PSI @ 28 DAYS
* STRUCTURE JOINTS TO BE SEALED WITH FLAT BUTYL SEALANT (CONSEAL)
* REINFORCEMENT STEEL MEETS HS-20 LOADING REQUIREMENTS

PUMP DATA
DUPLEX GRINDER PUMPS
40 GPM @ 40 TDH
WITH 2 H.P. 3750 R.P.M. MOTORS
ZOELLER 840

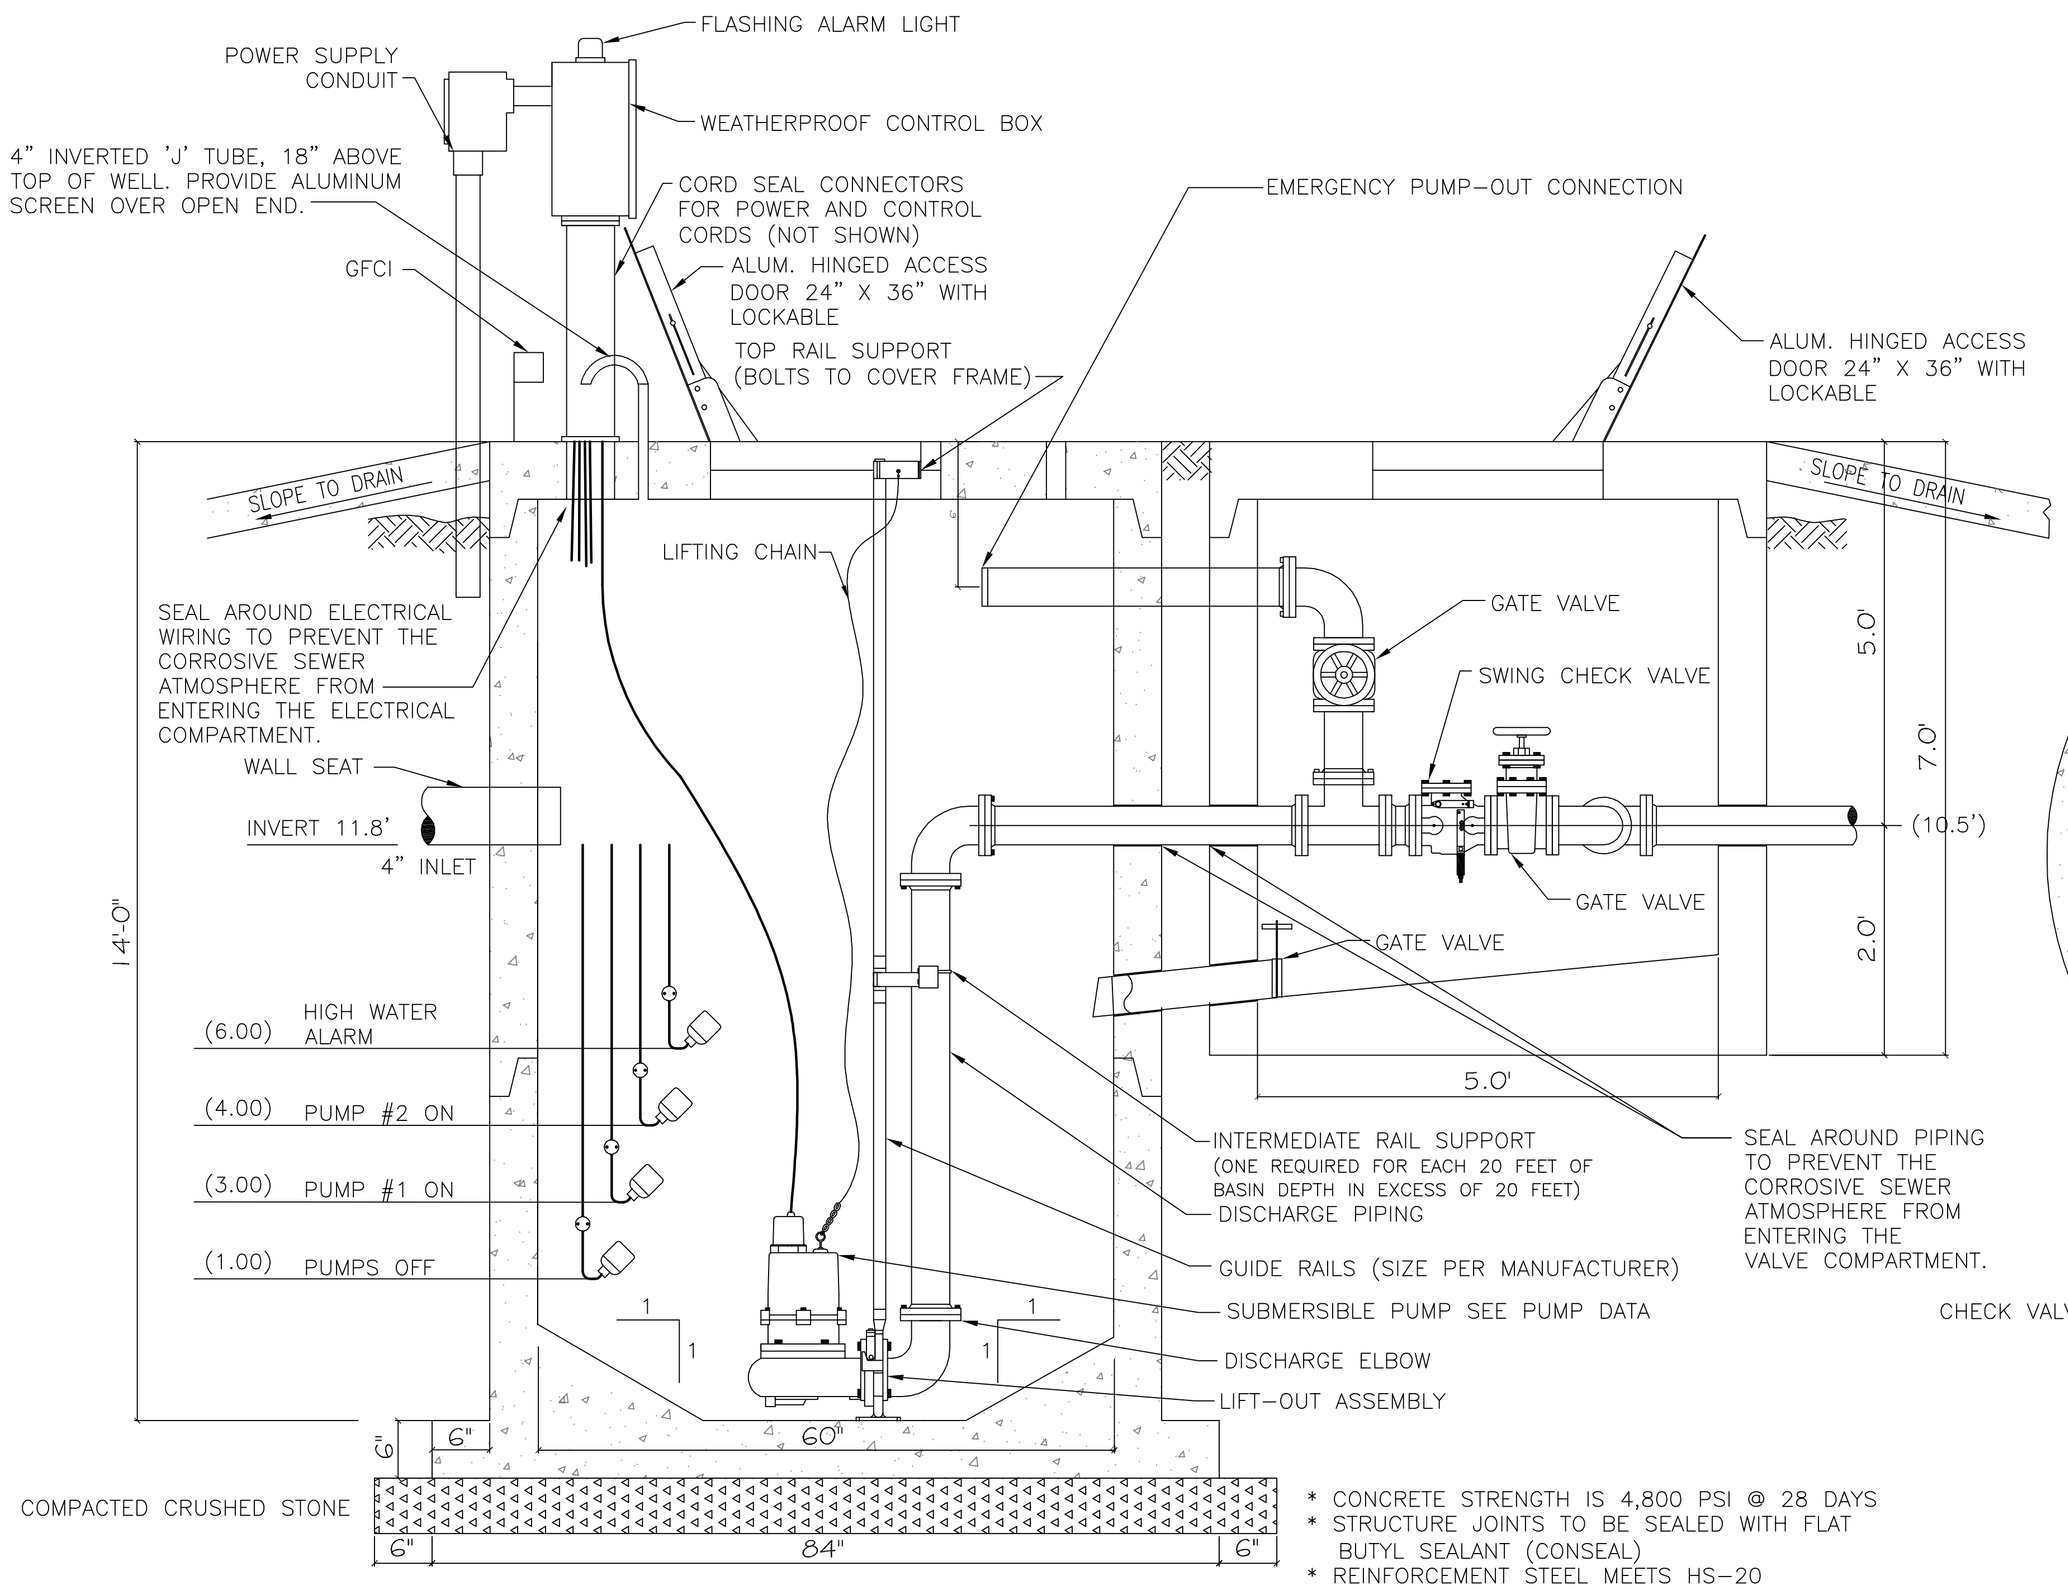


# DUPLEX LIFT STATION DETAIL

NOT TO SCALE

AS-BUILT
07-5-16

DAMMON ENGINEERING, INC.
Architects & Engineers
dammonengineering.com
dammon@bellsouth.net
PHONE: 985-641-5932
FAX: 985-641-5950
CHIEF ENGINEER: BRIAN MISTICH, P.E.
CHIEF ARCHITECT: KEVIN KINCHEN
554 OLD SPANISH TRAIL
SLIDELL, LA 70458

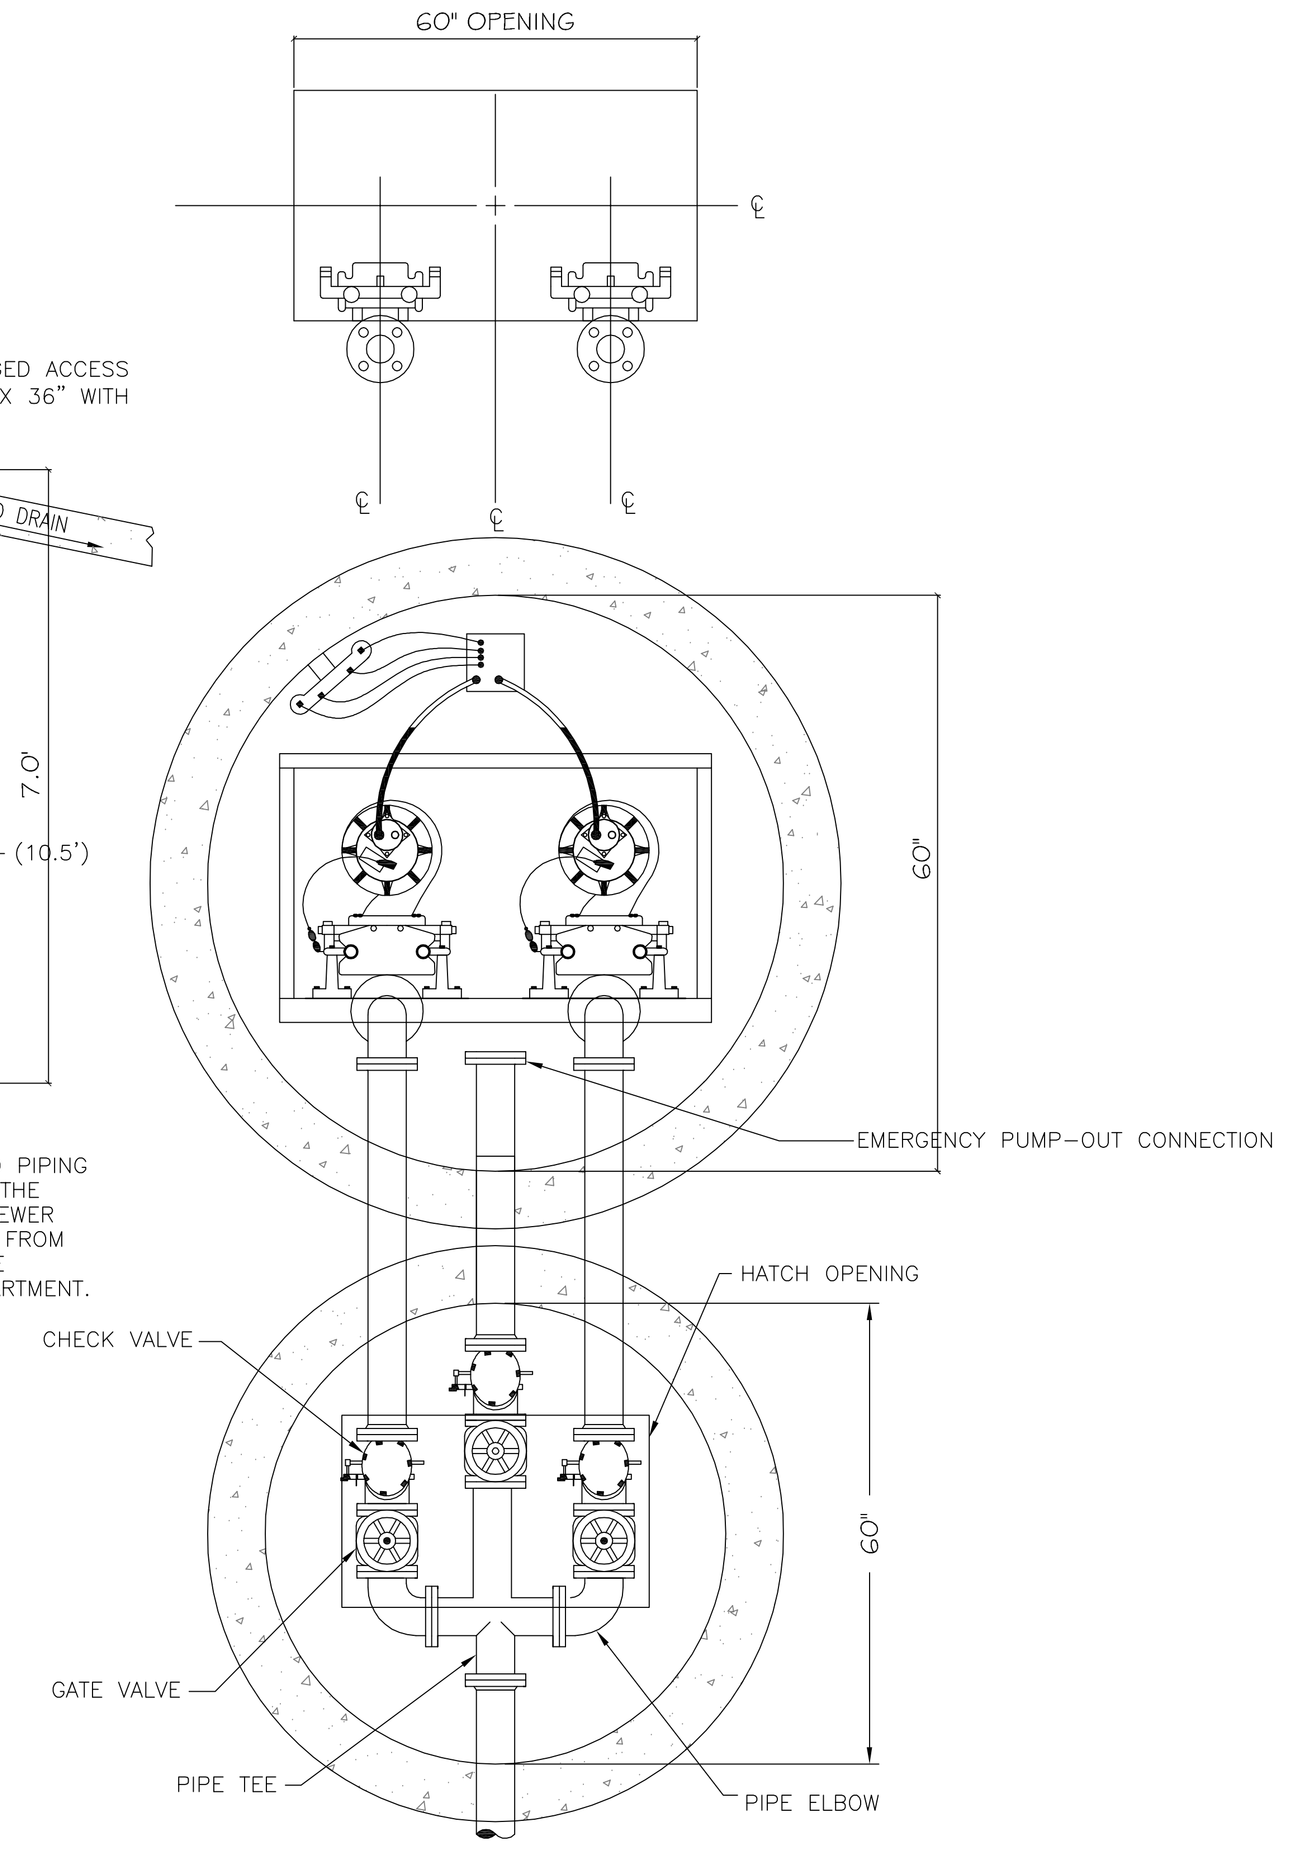DREAMLAND MOBILE HOME PARK
ALLIE ESSENCE LANE
NICHOLSON, MISSISSIPPI

The above drawings and specifications, designs and plans are the property of Dammon Engineering, Inc. and shall not be loaned, copied or used in any manner for any purpose whatsoever without the written permission of Dammon Engineering, Inc. They are not to be changed or altered in any manner except by Dammon Engineering. Visual contact with these drawings and specifications shall constitute prima facie evidence of acceptance of these restrictions.

JOB No: 2182
DATE: 05-19-2014
DRAWN BY: CKD
CHECKED BY: BM

REVISIONS
# DESCRIPTION | DATE

SEWER LIFT STATION

SHEET No: 03 OF 04

C2A