


FREMAUX AVENUE

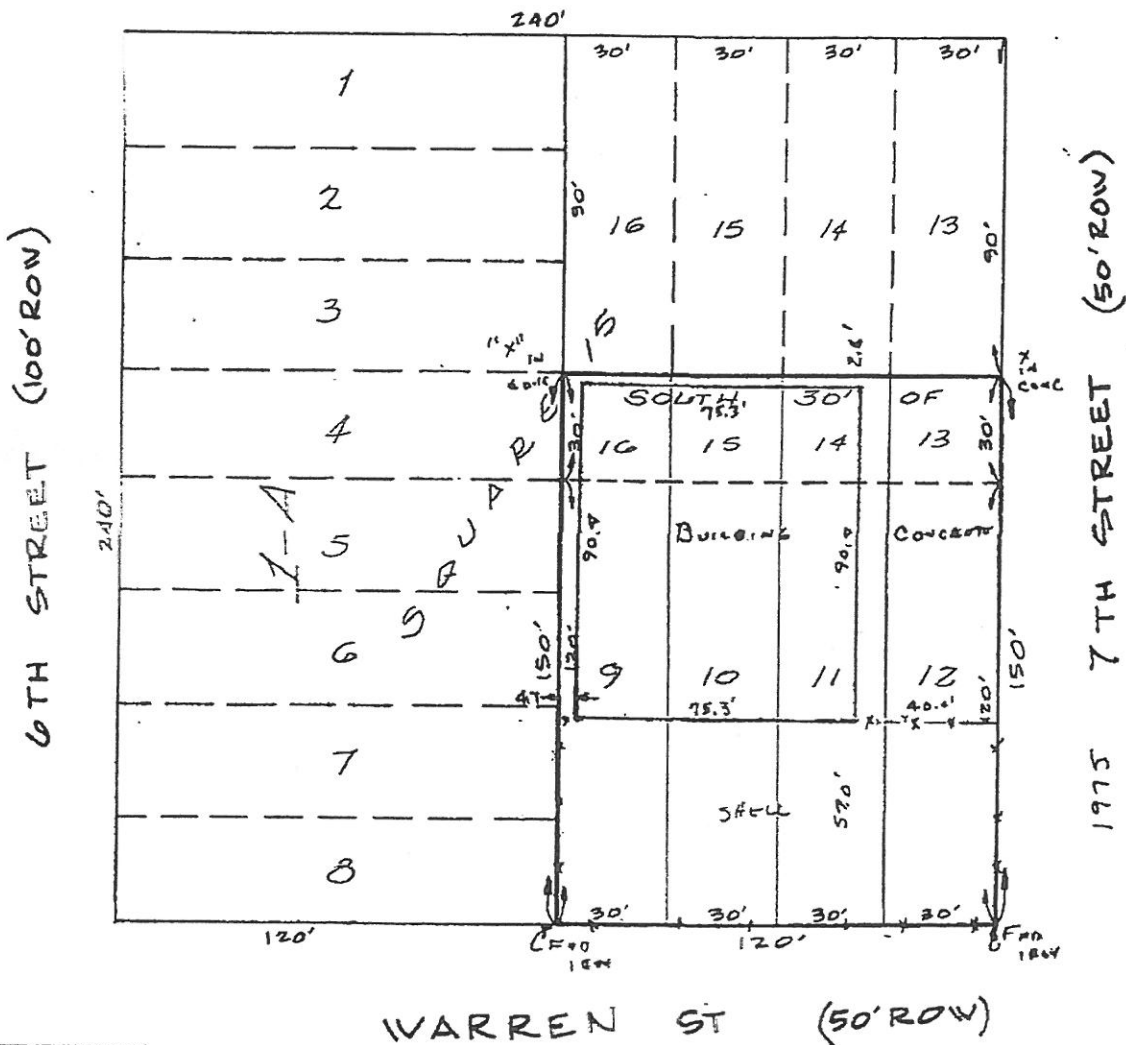

Scale: 1" = 50'

FLOOD ZONE A-4

Survey Map

of  
lots 9, 10, 11, 12 AND SOUTH 30' OF LOTS 13, 14, 15 & 16 PINE PARK PLACE S/O

City of Slidell,  
 St. Tammany Parish, Louisiana


for  
**RENLEY F. PENNINGTON JR. &  
 LARRY E. PENNINGTON**



Survey Number: 49799  
 Date: 29 DEC. 1989  
 Revision:

This Survey is Certified  
 True and Correct by  
  
 Ivan M. Borgen  
 No. 686

FREMAUX AVENUE

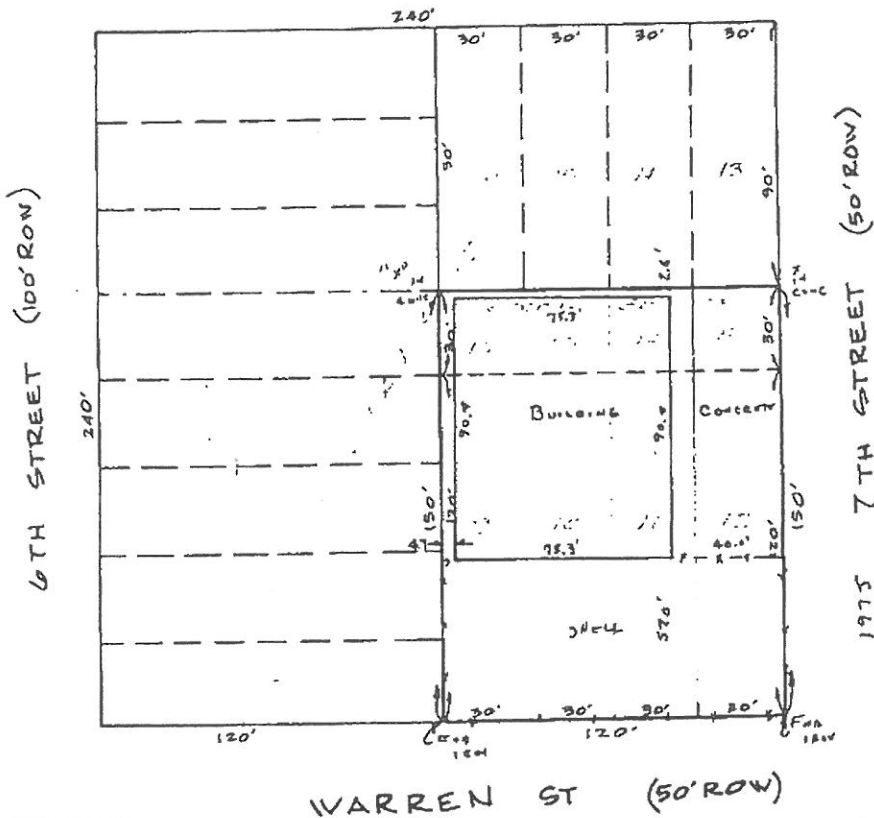

Scale: 1

Flood Zone A-4

Survey Map

of  
lots 9, 10, 11, 12 AND SOUTH 30' OF LOTS 13, 14, 15 & 16 PINE PARK PLACE S/O  
 in

City of Slidell,  
 St. Tammany Parish, Louisiana

for  
RENLEY F. PENNINGTON JR. &  
LARRY E. PENNINGTON



Survey Number: 49799  
 Date: 29 DEC. 1989  
 Revision:

This Survey is Certified  
 True and Correct by  
  
 Ivan M. Borgen  
 No. 686