


ONE HOUR ASSY
TWO HOUR ASSY

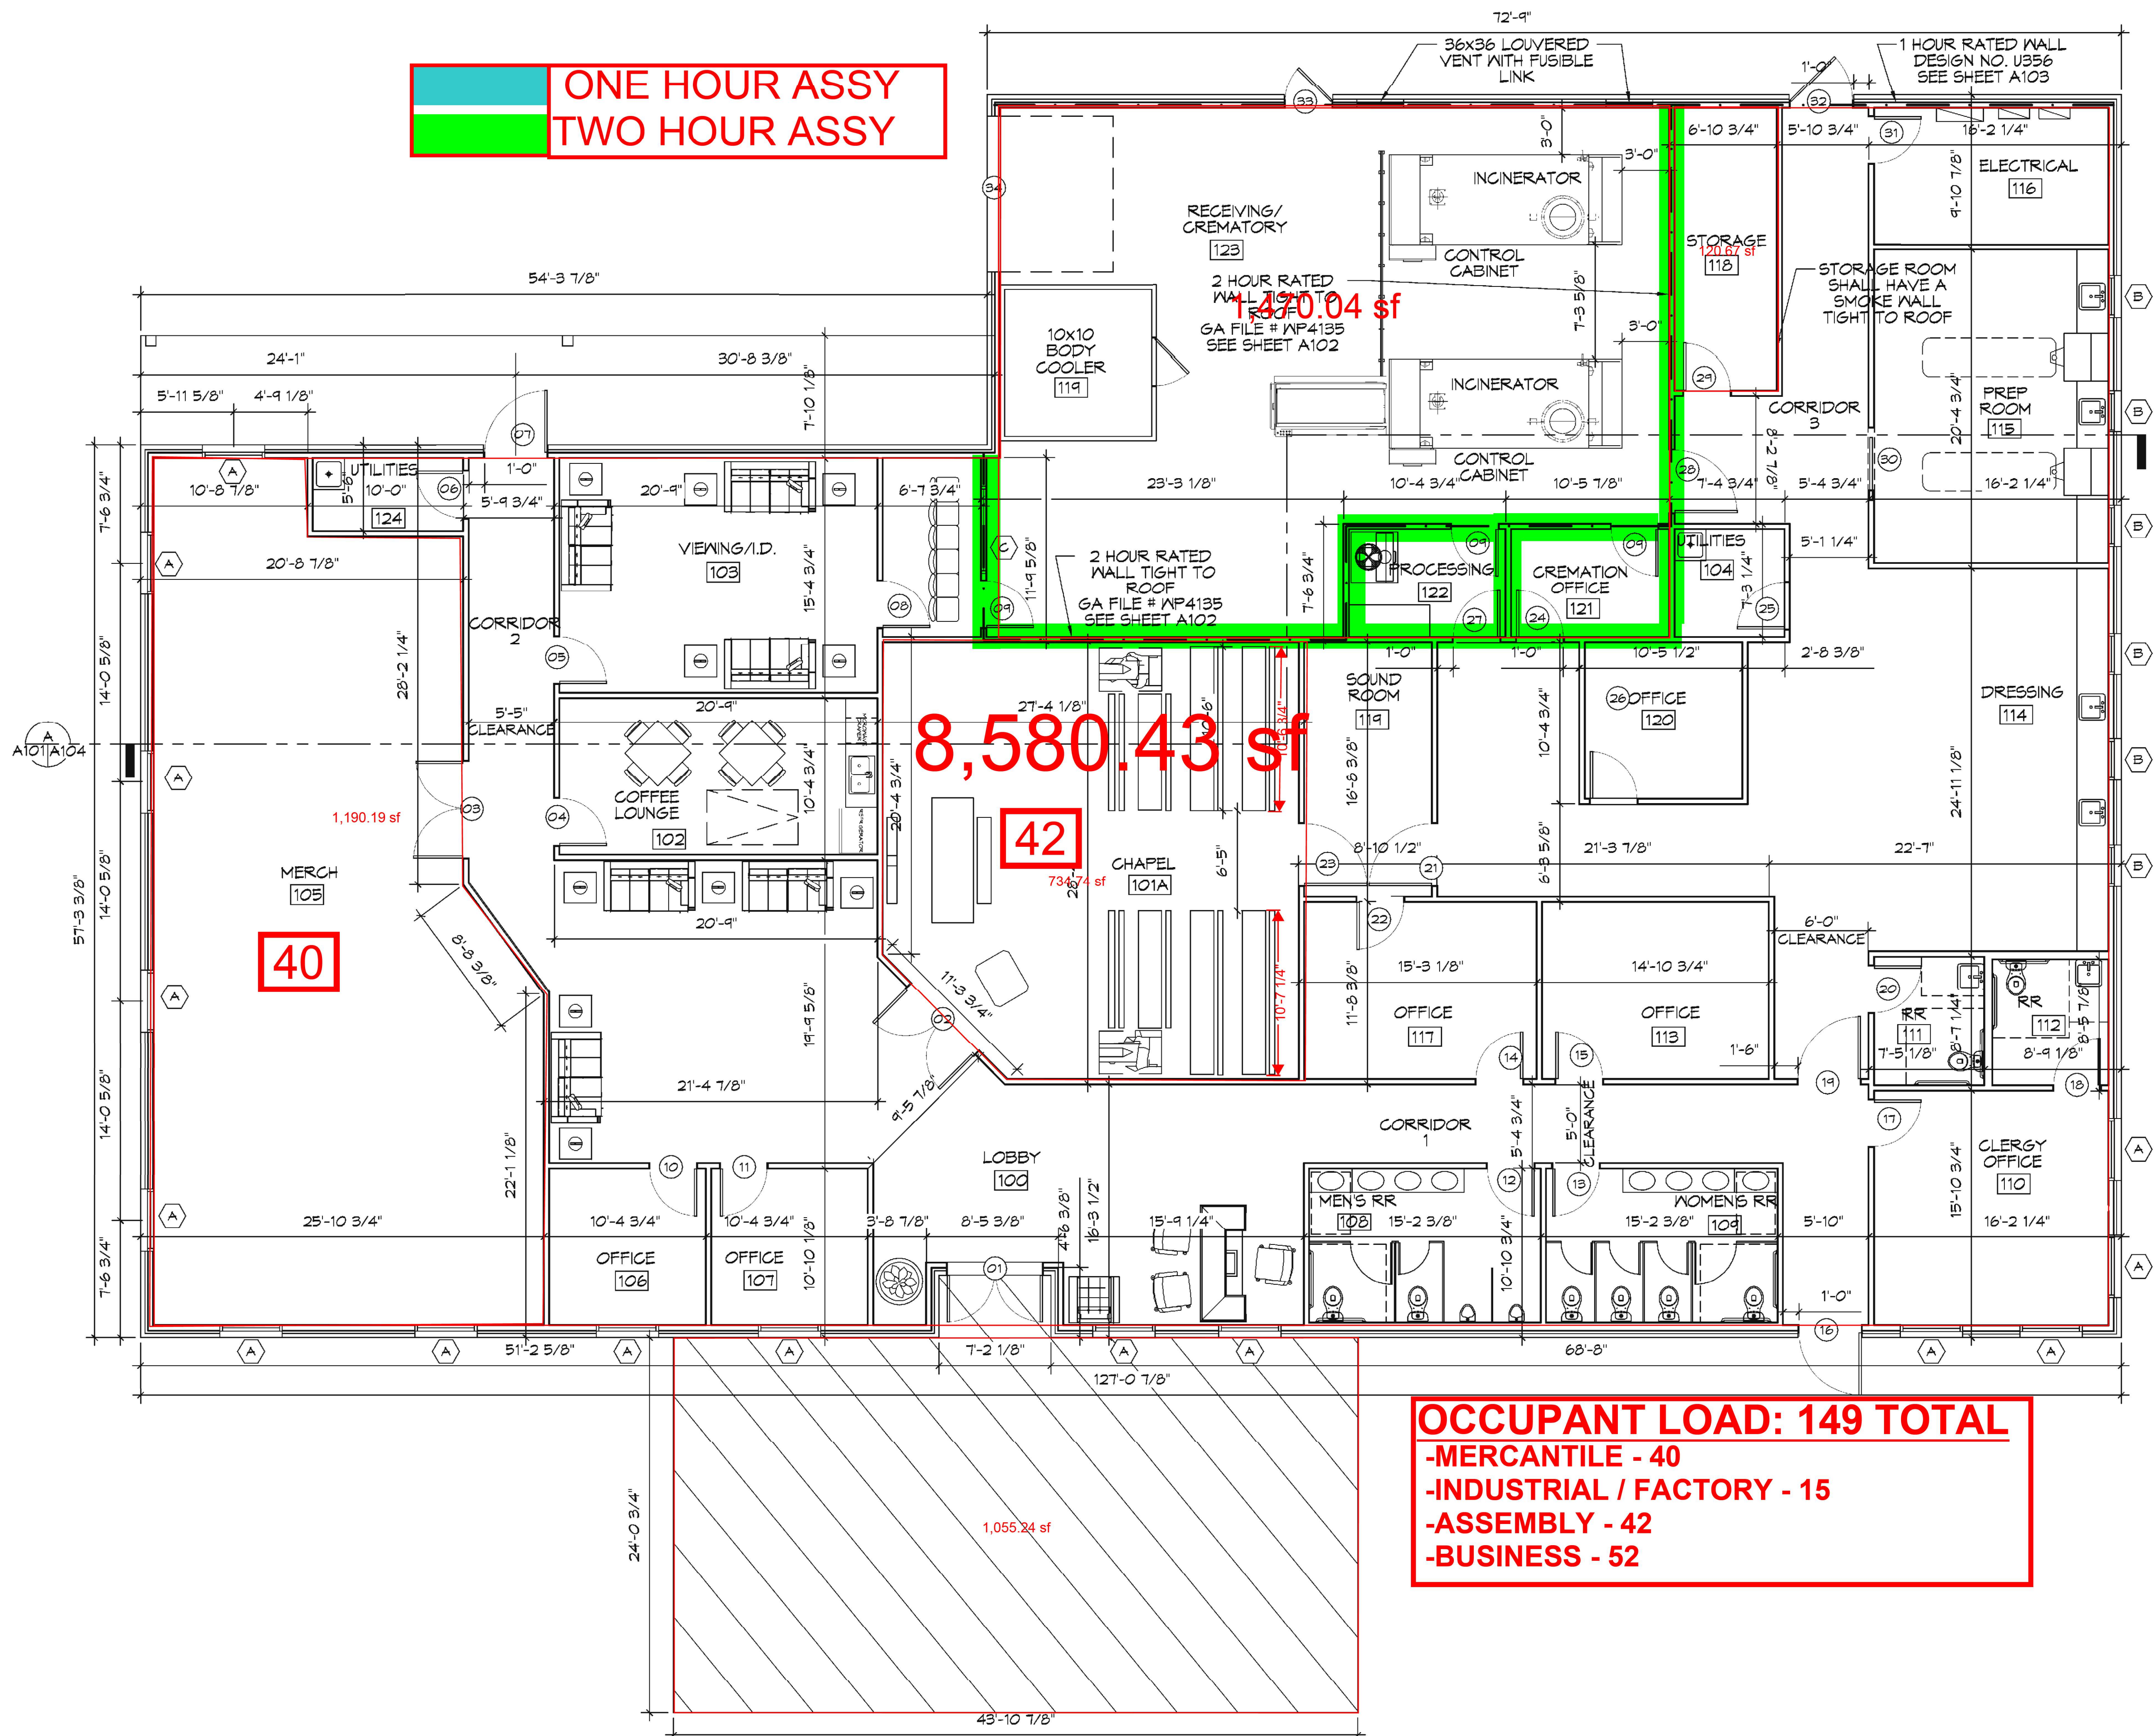

8,580.43 sf

1,470.04 sf

40

42

OCCUPANT LOAD: 149 TOTAL
 -MERCANTILE - 40
 -INDUSTRIAL / FACTORY - 15
 -ASSEMBLY - 42
 -BUSINESS - 52

10 FLOOR PLAN
 SCALE: 3/16"=1'-0"

DAMMON
 ENGINEERING, INC.
 LOUISIANA & MISSISSIPPI

#	DESCRIPTION	DATE



NEW FUNERAL HOME
BONER FALLOME
 4800 DOWNMAN ROAD
 NEW ORLEANS, LA
 JOB No: 2586 | DATE: 11-10-2020
 DRAWN BY: C&D | CHECKED BY: C&D

SHEET TITLE:
 FLOOR PLAN

REVIEWED FOR:
 STATE FIRE MARSHAL
 AS PER REVIEW LETTER
 BY: ERIC M. RILEY, ARCHITECT
 A101