



All but chapel
circled by
1/27/19

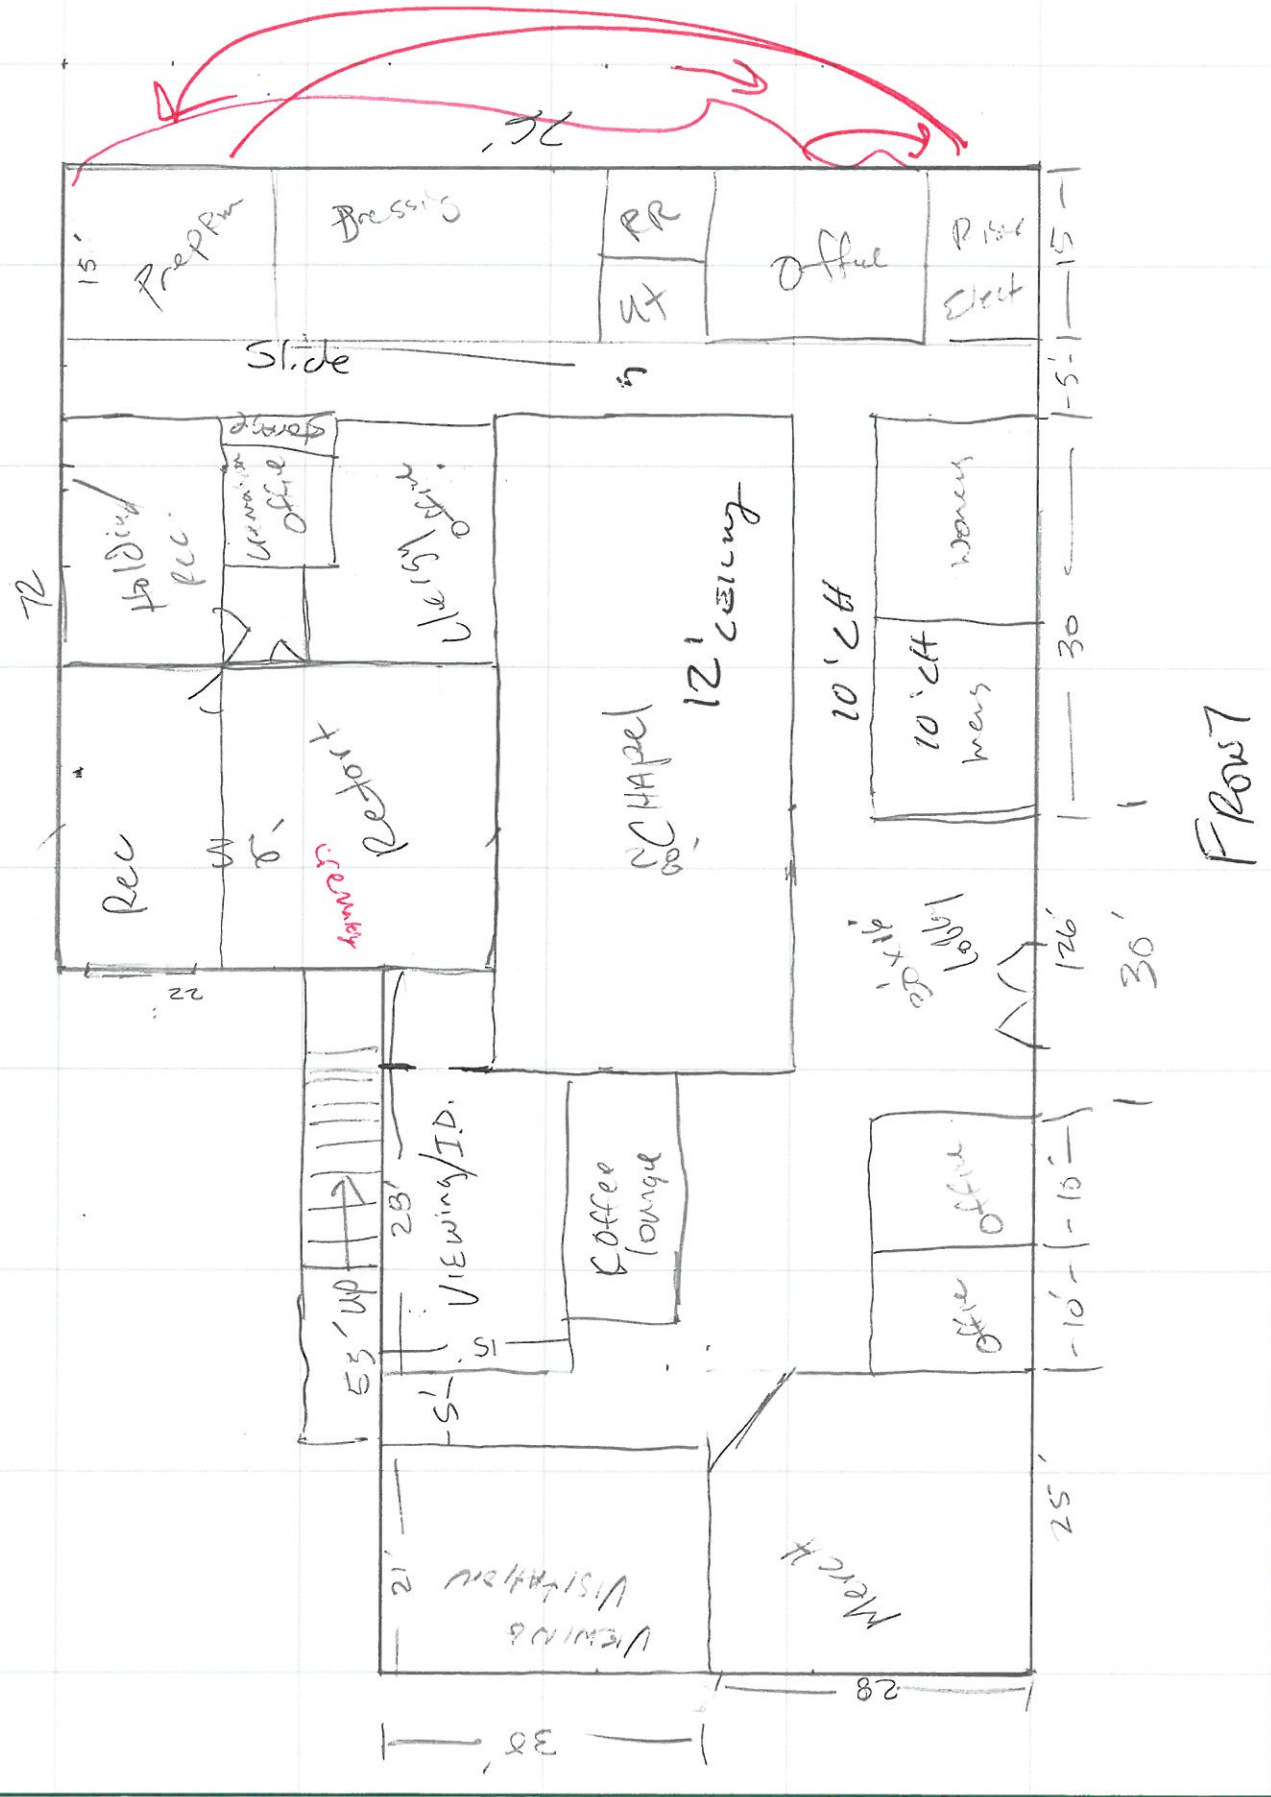

Flow 7

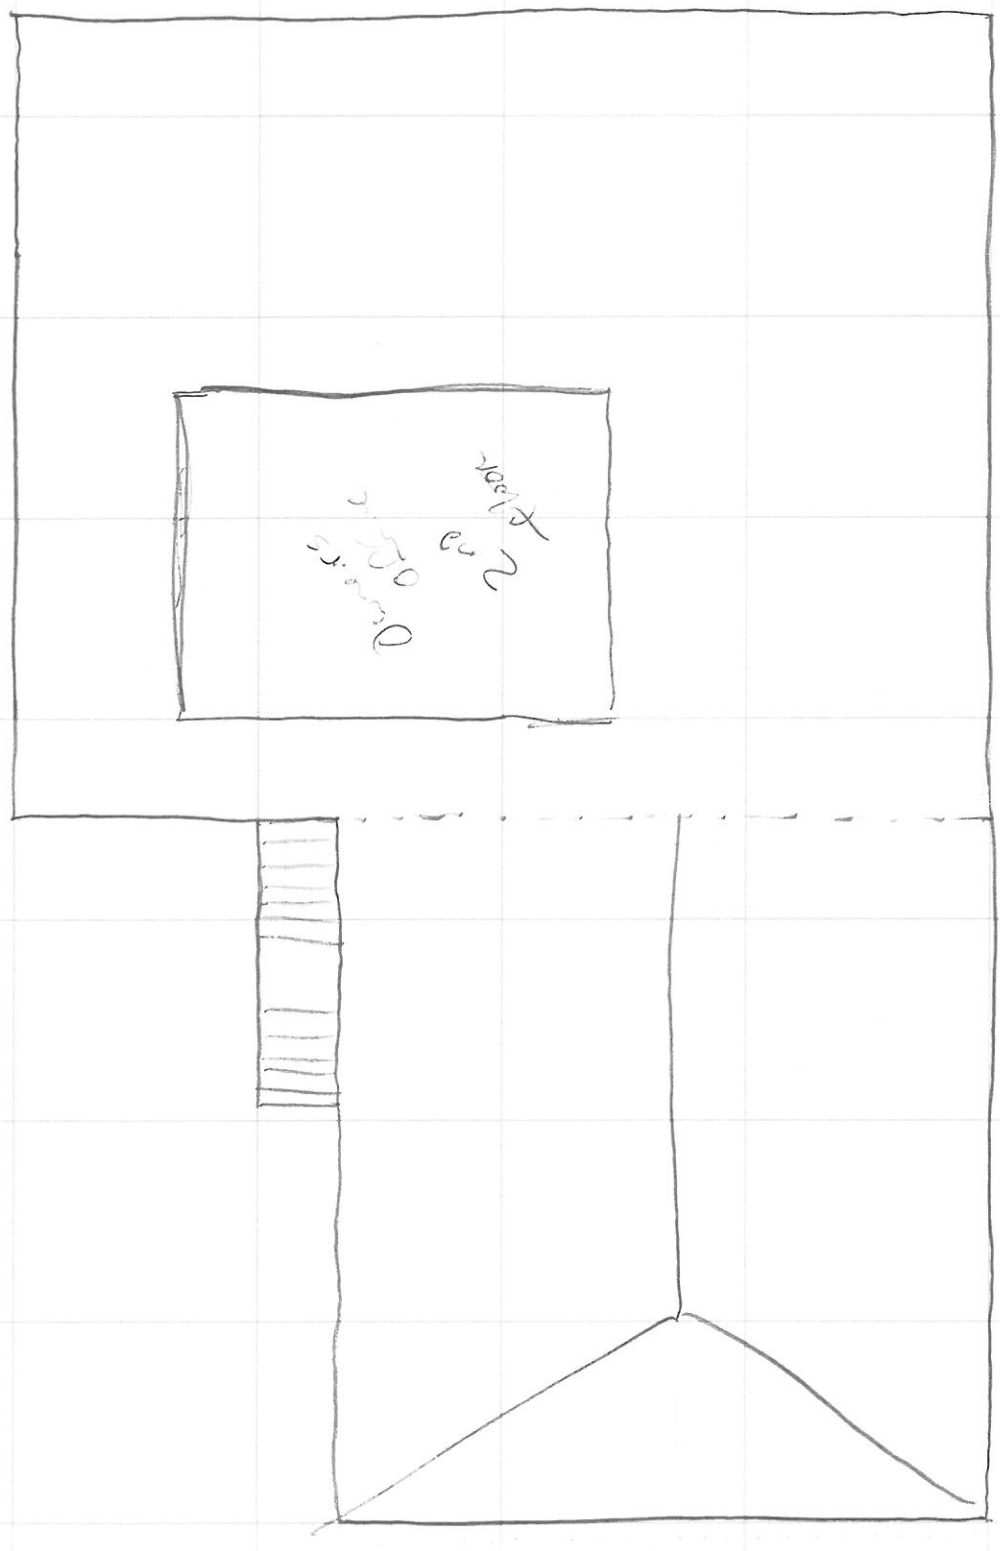

Floor 7