


## HIGH VOLTAGE PRIMARY RISER DIAGRAM

SCALE: NTS

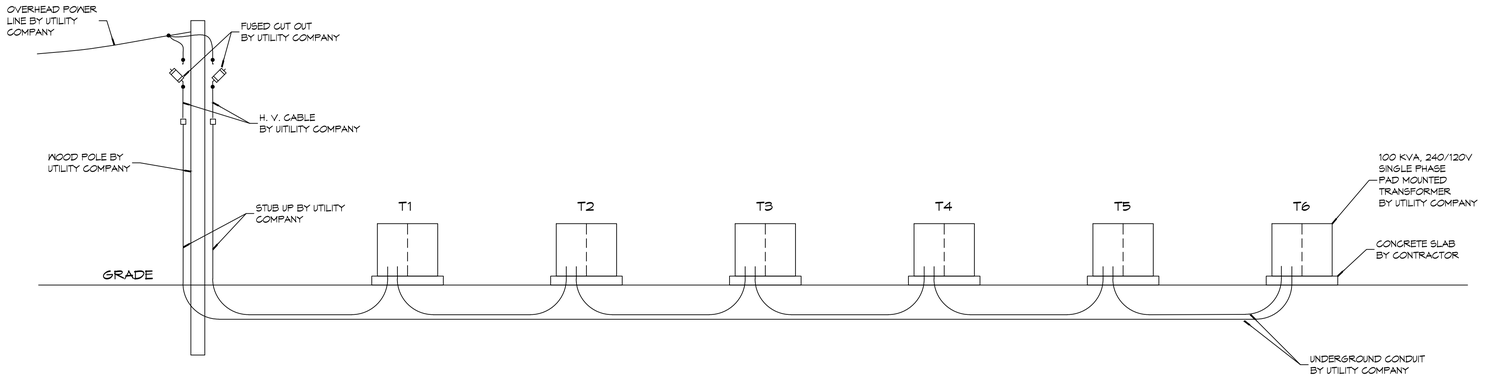


## TYPICAL LOW VOLTAGE DIAGRAM

SCALE: NTS


J:\DAMMON\Dammon Logo\Dammon Logo_Louisiana & Mississippi-3.JPG

www.dammonengineering.com
info@dammonengineering.com
PH: 985.649.5832

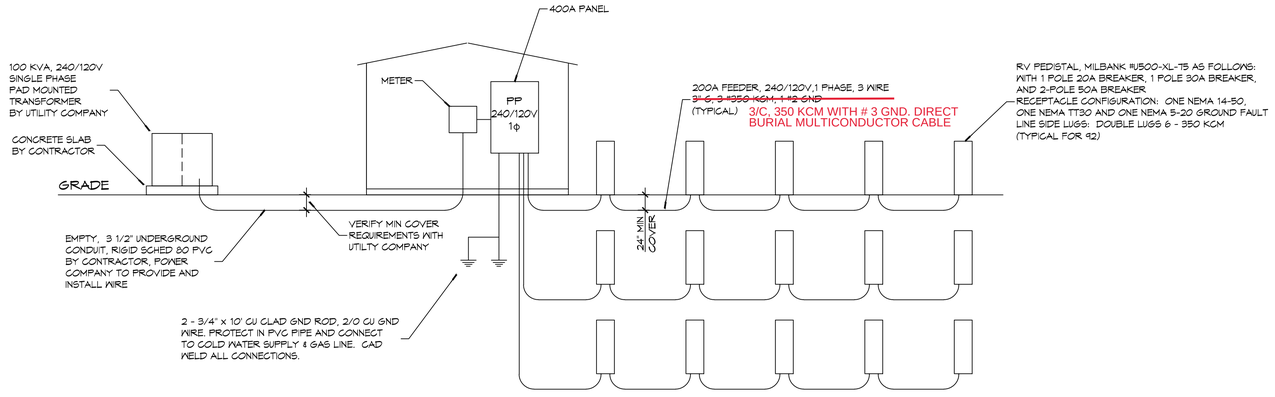Chief Engineer: Brian Mistich, PE
154 Old Spanish Trail
Slidell, LA 70458


REVISIONS

| # | DESCRIPTION | DATE |
|---|---|---|

SEAL:


These plans and specifications, including but not limited to all concepts, designs, arrangements and drawings prepared or furnished by Dammon Engineering, and the copyright therein are the property of Dammon Engineering. All rights are reserved. These plans and specifications are not to be changed or copied in any form or manner whatsoever nor are they to be assigned to any third party without first obtaining the express written permission and consent of Dammon Engineering. Any unauthorized use of these plans and specifications without the express written consent of Dammon Engineering will be prosecuted to the maximum extent possible under the law.


JOB No: 2451 | DATE: 02-25-2021
DRAWN BY: DD/JTL | CHECKED BY: BAM

SHEET TITLE:
ELECTRICAL RISER DIAGRAMS

DRAWING NUMBER:

E111

SHEET No: 50 of 1


FILE NAME: C:\Users\Mistich\Documents\Job Folders\2020-02-10 RV Park & Pickleball\Drawings\E111 - E113 Riser Diag and Load Summary.dwg AUG 2021 & Then, Sunday, April 03, 2022 11:03:31 AM