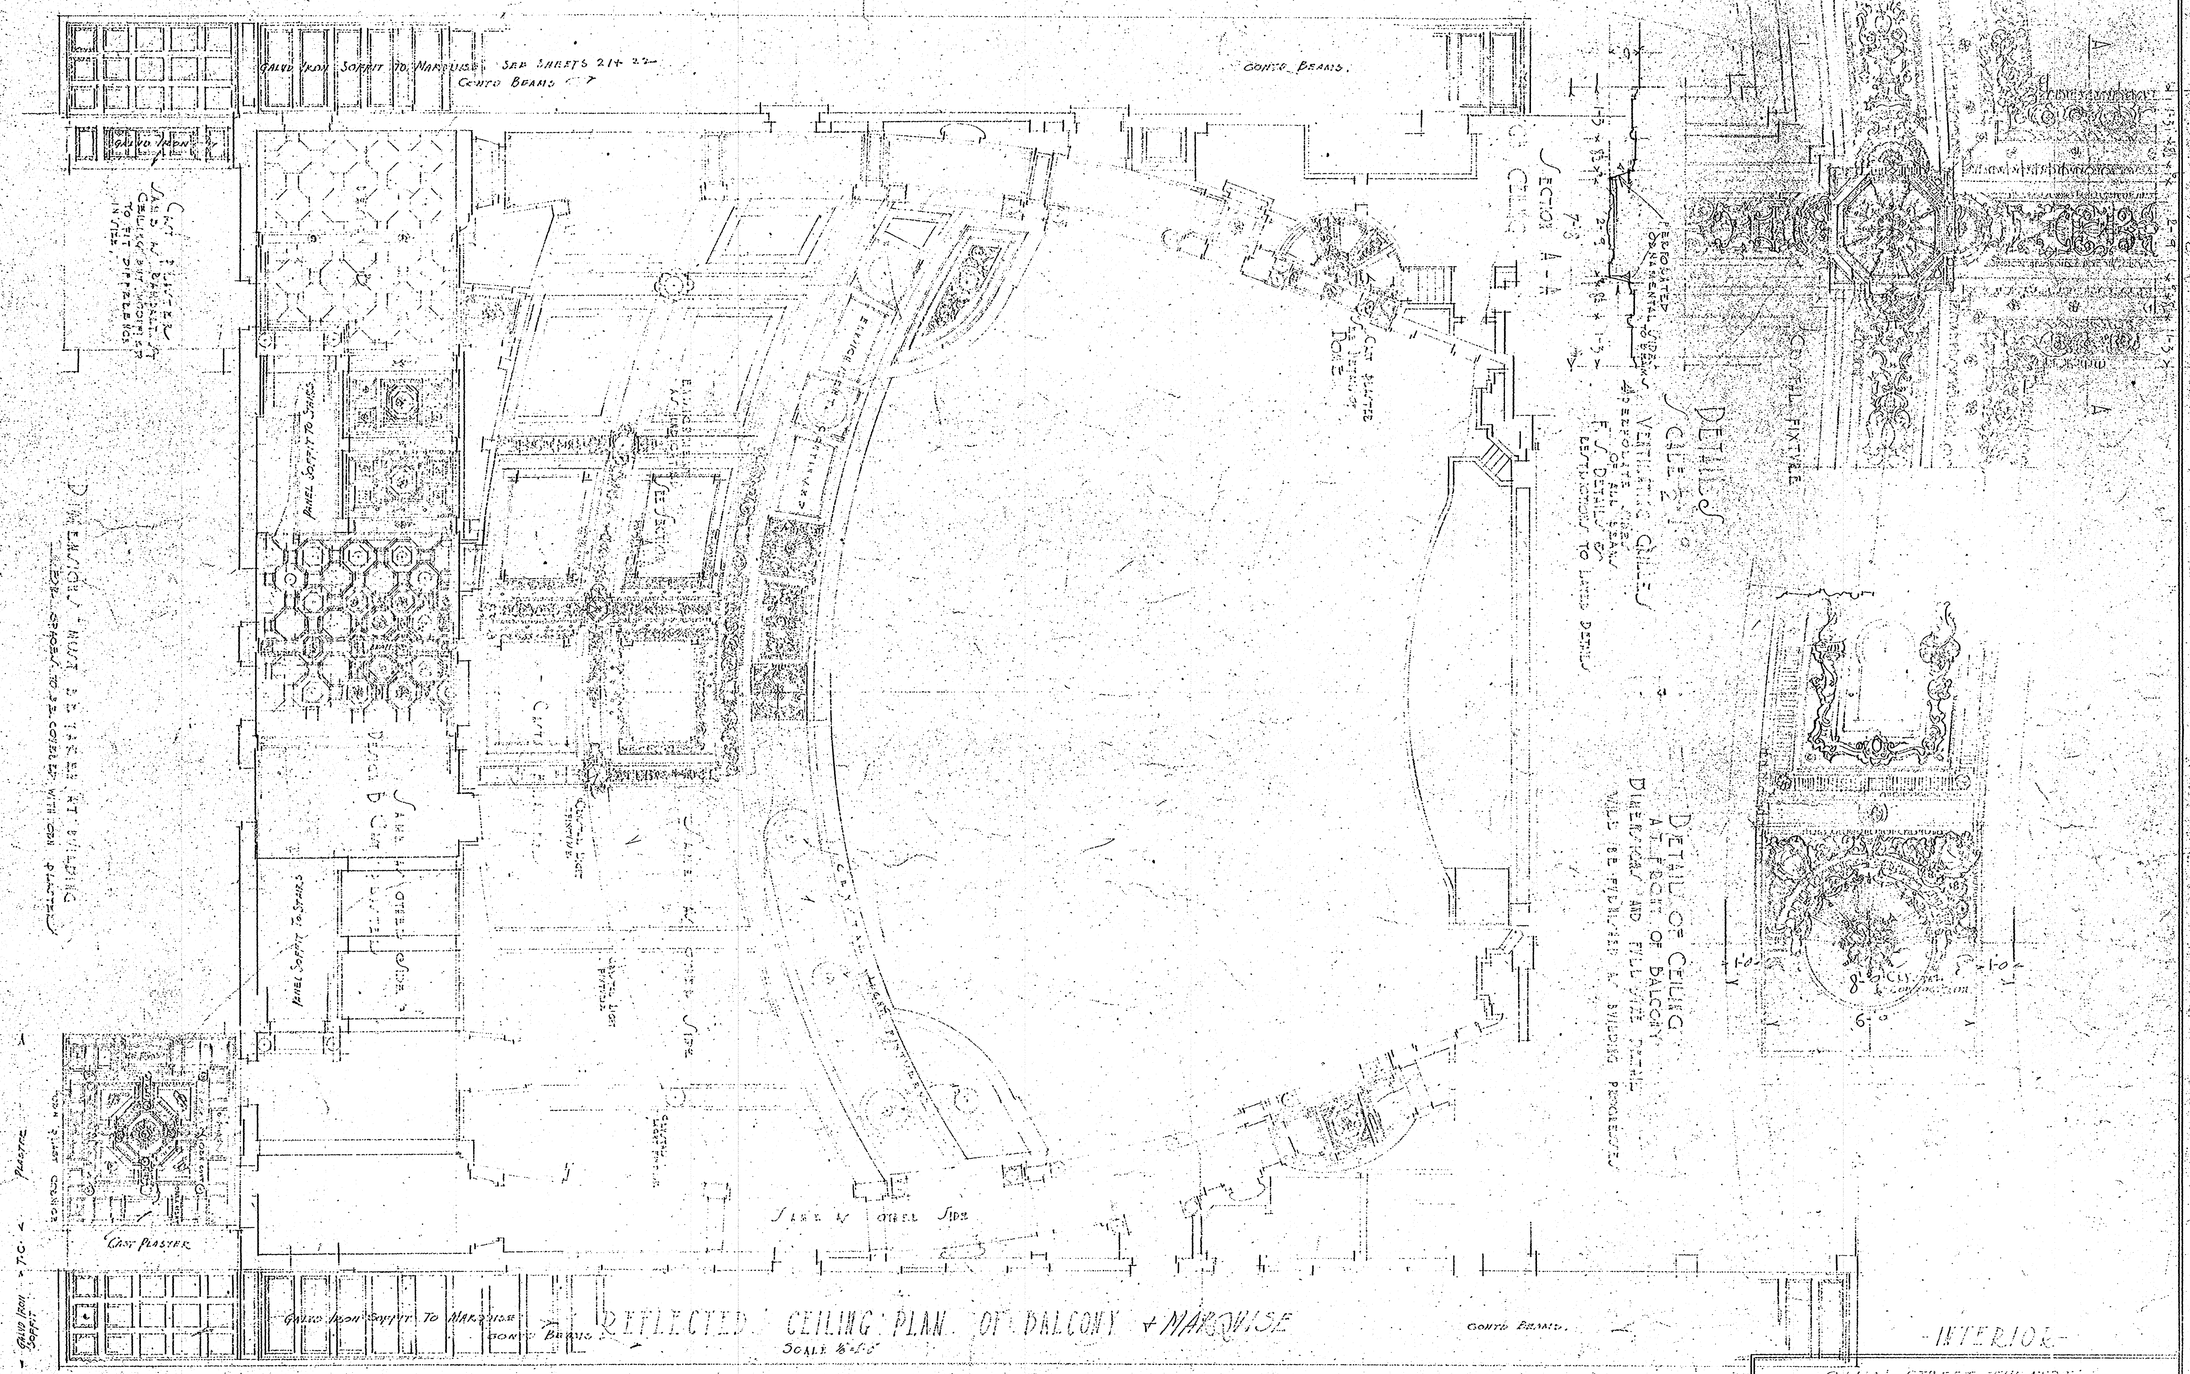

INTERIOR

CANAL STREET THEATRE
FOR
SPENCER THEATRES, INC.
CANAL, BASIN & ST. CHARLES STS.
NEW ORLEANS

REVISED	EMILE WEIL Jr. ARCHITECT WHITNEY CENTRAL BUILDING NEW ORLEANS, LA.	PLAN 8/F	SHEET D50
		DATE Nov. 3/30	