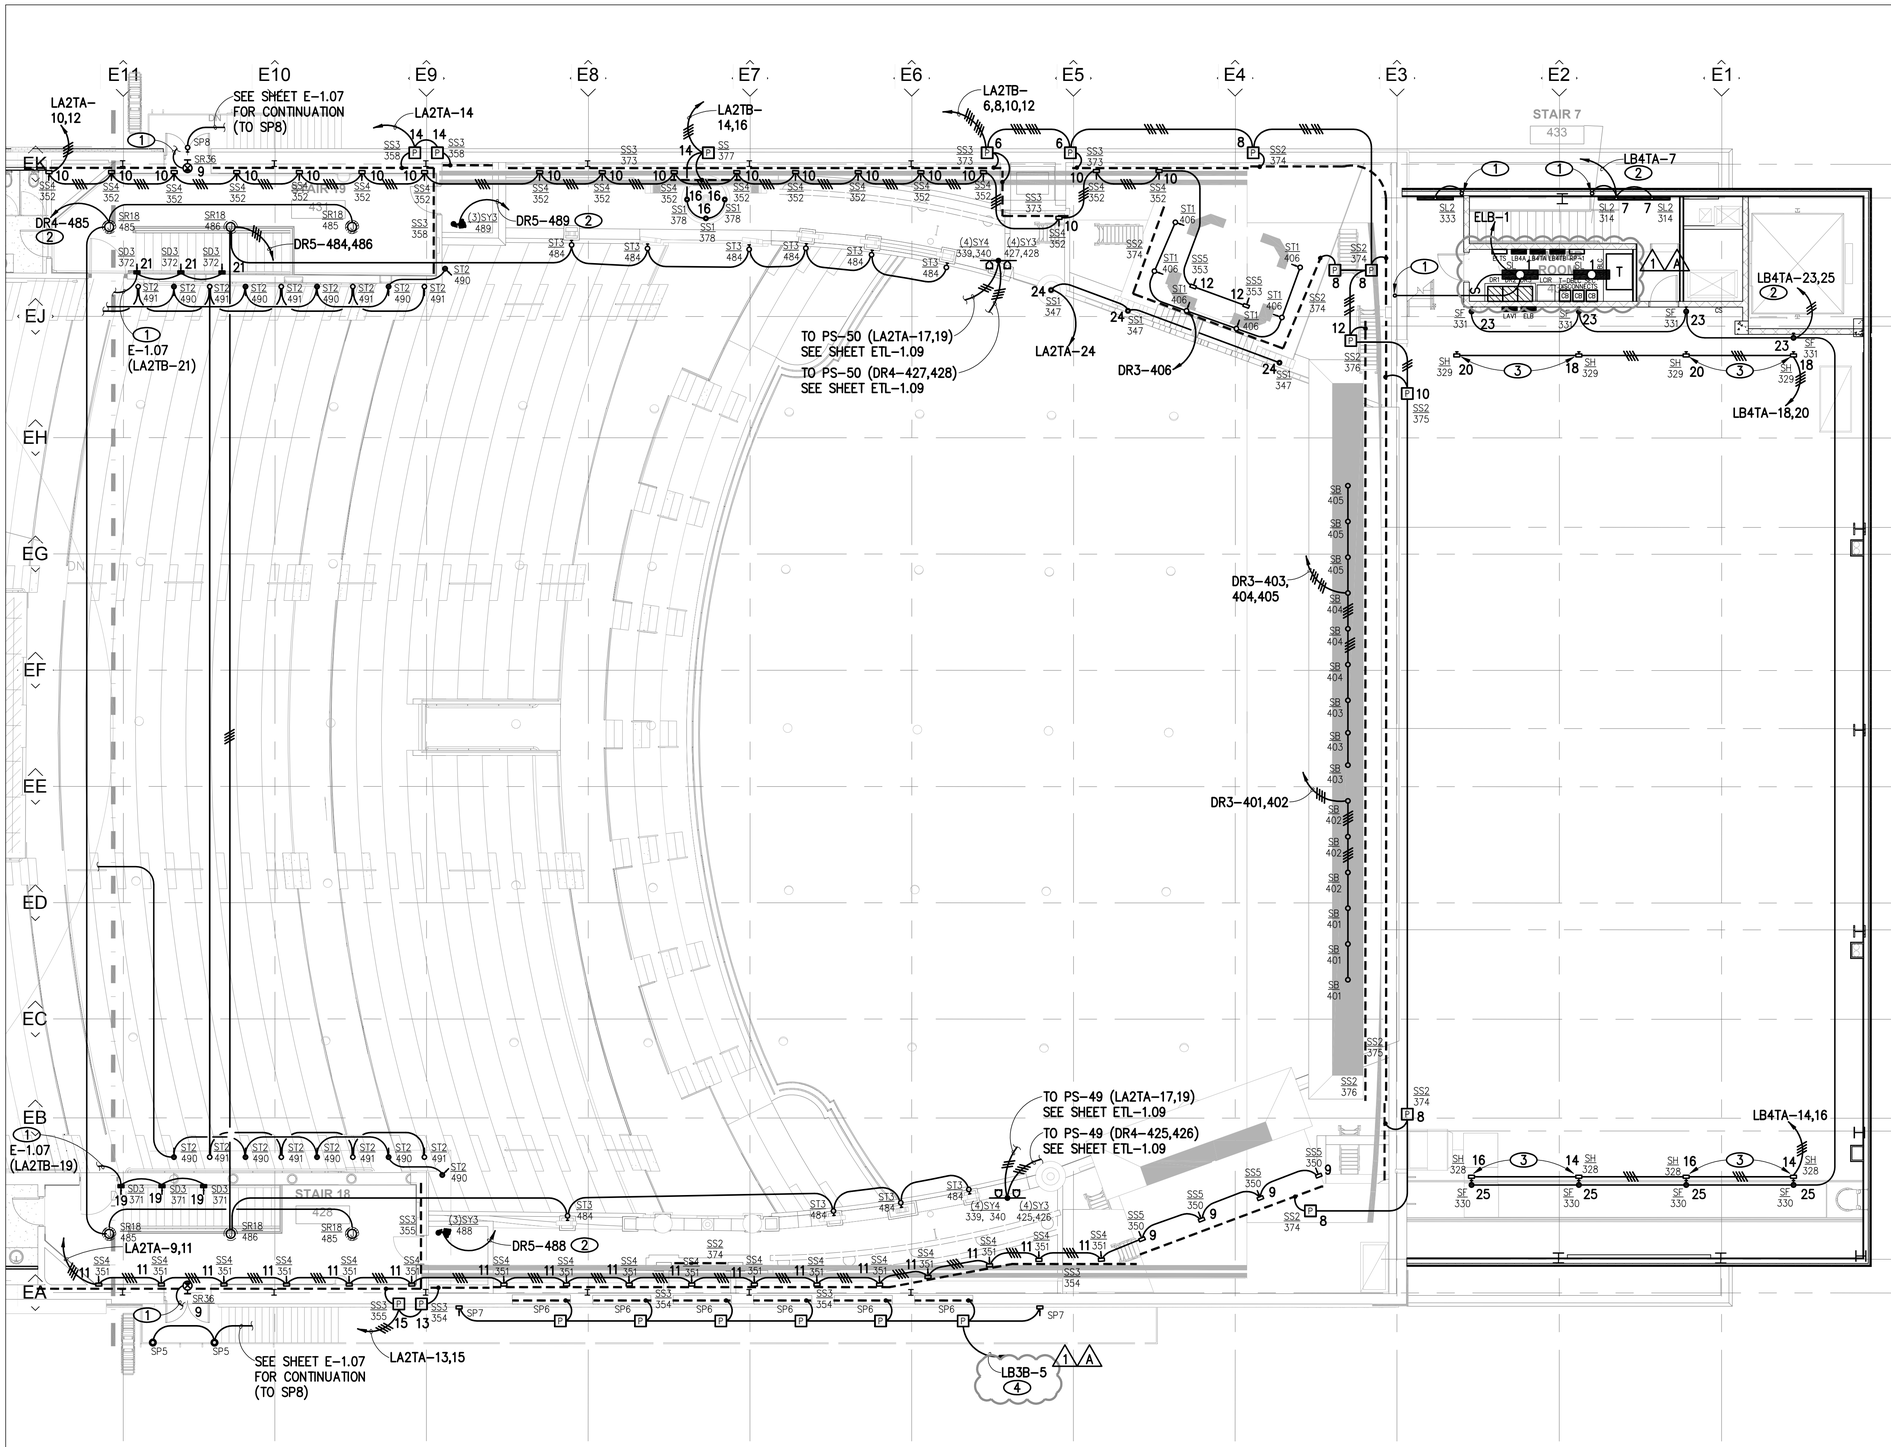


## NOTES

1. TO FIXTURE ON FLOOR BELOW.
2. ROUTE CIRCUIT VIA EMERGENCY TRANSFER RELAY.
3. COORDINATE CONDUIT ROUTING FOR TYPE SH FIXTURES WITH LIGHTING CONSULTANT, REFER TO 4/AL-4.00.
4. ROUTE CIRCUIT VIA LIGHTING CONTROL RELAY 'R-L2'

## CIRCUIT WIRING TABLE

| DISTANCE | 20A | 50A |
|---|---|---|
| 0' – 145' | #10 | #6 |
| 146' – 225' | #8 | #4 |
| 226' – 350' | #6 | #2 |

## NOTICE

(APPLIES TO DIMMER & RELAY CONTROLLER CIRCUITS)

1. EACH 120V CIRCUIT SHALL BE 2 CONDUCTORS, SEPARATE NEUTRALS REQUIRED FOR ALL 120V CIRCUITS.
2. RACEWAY FILL SHALL BE PER NEC CHAPTER 9. PROVIDE RACEWAY SIZE AND QUANTITY REQUIRED.
3. SEE DIMMER SCHEDULE SHEET E8.01 FOR RECEPTACLE TYPES.
4. PROVIDE DERATING OF CONDUCTORS PER NEC TABLE 310.15(B)(2)(a).
5. REFER TO SCHULER SHOOK DRAWINGS FOR LIGHTING SYSTEM CONTROL REQUIREMENTS. PROVIDE ALL RACEWAYS, BOXES, OUTLETS, CONNECTORS, EQUIPMENT, ETC. PER THEATRICAL LIGHTING CONSULTANT DRAWINGS.

# THE SAENGER THEATRE RENEWAL PROJECT

142 North Rampart Street
New Orleans, LA


**Client**
Saenger Theatre Redevelopment Company
200 West Loop South, Suite 1040 Houston TX 77027

Architect
**MARTINEZ+JOHNSON** ARCHITECTURE
**1412 Eye St., NW**
**Washington, DC 20005**
**202.333.4480**

Structural Engineer
Shawn J. Franke, P.E.
549 Heimer Road San Antonio TX 78232
210.979.7900

Theatre Consultant
Schuler Shook
123 Third Street North #210 Minneapolis, MN 55401
612.339.5958

Acoustical Engineer
Akustiks
93 North Main Street South Norwalk, CT 06584
202.299.1904

MEP Engineer
JBA Consulting Engineers, Inc.
3525 N. Causeway BLVD. Suite 500 Metairie, LA 70002
504.830.0139

Civil Engineer
Linfield, Hunter, & Junius, Inc.
3608 18th Street Suite 200 Metairie, LA 70002
504.833.5300

Architectural Historian
EHT Traceries, Inc.
1121 Fifth Street NW Washington, DC 20001
202.393.1199



THESE DRAWINGS, SPECIFICATIONS, AND OTHER DOCUMENTS, (COLLECTIVELY, THE "DOCUMENTS") INCLUDING WITHOUT LIMITATION ELECTRONIC VERSIONS THEREOF AND THE IDEAS, DESIGNS, AND ARRANGEMENTS REPRESENTED THEREBY, ARE AND SHALL REMAIN THE PROPERTY OF MARTINEZ & JOHNSON ARCHITECTURE PC, AS DEFINED BY APPLICABLE CONTRACTUAL AGREEMENTS ("THE AGREEMENTS") AND AS PROTECTED BY THE COPYRIGHT STATUTES OF THE UNITED STATES. USE OF THE DOCUMENTS SHALL BE STRICTLY LIMITED TO THE PROJECT FOR WHICH THEY WERE PREPARED AND DEVELOPED ("THE PROJECT") PER THE TERMS OF THE AGREEMENTS. NO PART OF THE DOCUMENTS SHALL BE COPIED, DISCLOSED TO OTHERS, OR USED IN CONNECTION WITH ANY OTHER WORK OR PROJECT, OR BY ANY OTHER PERSONS FOR ANY PURPOSES, OTHER THAN THE COMPLETION OF THE PROJECT, WITHOUT THE SPECIFIC WRITTEN AUTHORIZATION OF MARTINEZ & JOHNSON ARCHITECTURE PC. THE DOWNLOADING, OPENING, OR VIEWING OF ELECTRONIC VERSIONS OF THE DOCUMENTS OR VISUAL CONTACT WITH ANY PRINTED FORM THEREOF SHALL CONSTITUTE CONCLUSIVE EVIDENCE OF ACCEPTANCE OF THESE RESTRICTIONS.
7502


| DATE: | No.: | ISSUE: |
|---|---|---|
| 02.19.10 | 1 | PERMIT SET |
| 04.02.10 | 2 | GMP CONTRACT SET |

| DATE: | No.: | REVISION: |
|---|---|---|
| 06.16.10 | 1 | PERMIT REVISION |
| 11.11.10 | | CONTRACT SET |

SHEET TITLE:
THEATRE - UPPER BALCONY LEVEL - LIGHTING PLAN

09.0394

**E-1.09**

THEATRE - UPPER BALCONY LEVEL - LIGHTING PLAN | 1/8" = 1'-0" | 1

ISSUED FOR PERMIT

© 2010 M+J

P:\09.0394 Saenger Theatre\DRAWING\ELECTRICAL\09394_E-109.dwg, 11/19/2010 5:24:52 PM, dhiggins