

NOTES

- ① 3" CHS/R & 2" HS/R FROM ABOVE & DOWN. ROUTE 3/4" CONDENSATE DRAIN DOWN.
- ② 2" CONDENSATE DRAIN IN CHASE FROM ABOVE & DOWN.
- ③ PROVIDE S.O.V.'S FOR BOTH CHS AND CHR PIPES (TYPICAL THROUGHOUT DRAWINGS).
- ④ PROVIDE PIPE LAGGING AROUND PIPES.

THE SAENGER THEATRE RENEWAL PROJECT
 142 North Rampart Street
 New Orleans, LA

Client
 Saenger Theatre Redevelopment Company
 200 West Loop South, Suite 1040
 Houston TX 77027

Architect
MARTINEZ+JOHNSON ARCHITECTURE
 1412 Eye St., NW
 Washington, DC 20005
 202.333.4480

Structural Engineer
 Shawn J. Franke, P.E.
 549heimer Road, San Antonio TX 78232
 210.979.7900

Theatre Consultant
 Schuler Shook
 123 Third Street North #210
 Minneapolis, MN 55401
 612.333.5659

Acoustical Engineer
 Akustiks
 93 North Main Street South
 Norwalk, CT 06584
 202.299.1904

MEP Engineer
 JBA Consulting Engineers, Inc.
 3525 N. Causeway Blvd. Suite 500
 Metairie, LA 70002
 504.830.0139

Civil Engineer
 Linfield, Hunter, & Junius, Inc.
 3608 18th Street Suite 200
 Metairie, LA 70002
 504.833.5300


Architectural Historian
 EHT Traceries, Inc.
 1121 Fifth Street NW
 Washington, DC 20001
 202.393.1199

THESE DRAWINGS, SPECIFICATIONS, AND OTHER DOCUMENTS, COLLECTIVELY, THE "DOCUMENTS" INCLUDING WITHOUT LIMITATION ELECTRONIC VERSIONS THEREOF AND THE IDEAS, DESIGNS, AND ARRANGEMENTS REPRESENTED THEREBY, ARE AND SHALL REMAIN THE PROPERTY OF MARTINEZ & JOHNSON ARCHITECTURE, P.C. AS SET FORTH BY APPLICABLE CONTRACTUAL AGREEMENTS ("THE AGREEMENTS") AND AS PROTECTED BY THE COPYRIGHT STATUTES OF THE UNITED STATES. USE OF THE DOCUMENTS SHALL BE STRICTLY LIMITED TO THE PROJECT FOR WHICH THEY WERE PREPARED AND DEVELOPED ("THE PROJECT") FOR THE TERM OF THE AGREEMENTS. NO PART OF THE DOCUMENTS SHALL BE COPIED, DISCLOSED TO OTHERS, OR USED IN CONNECTION WITH ANY OTHER WORK OR PROJECT, OR BY ANY OTHER PERSONS FOR ANY PURPOSES, OTHER THAN THE COMPLETION OF THE PROJECT, WITHOUT THE SPECIFIC WRITTEN AUTHORIZATION OF MARTINEZ & JOHNSON ARCHITECTURE, P.C. THE DOWNLOADING, OPENING, OR VIEWING OF ELECTRONIC VERSIONS OF THE DOCUMENTS OR VISUAL CONTACT WITH ANY PRINTED FORM THEREOF SHALL CONSTITUTE CONCLUSIVE EVIDENCE OF ACCEPTANCE OF THESE RESTRICTIONS.

7502

DATE:	No.:	ISSUE:
02.19.10	1	PERMIT SET
04.02.10	2	GMP CONTRACT SET
DATE:	No.:	REVISION:
11.11.10		CONTRACT SET

SHEET TITLE:
THEATRE - ELEVATOR MACHINE ROOM - PIPING

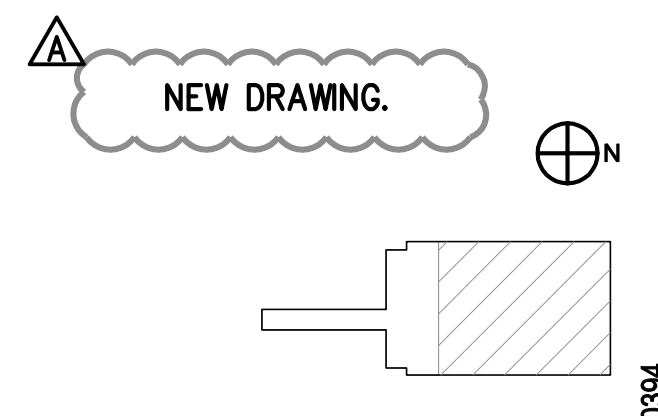

THEATRE - UPPER BALCONY LEVEL PLAN 1/8" = 1'-0" 1

P:\09.0394 Saenger Theatre\DRAWINGS\Mechanical\Contract Set\09.0394_M1.29A.dwg, 11/19/2010 4:52:04 PM, amand