File No 39143K16

SITE PLAN

Borrower or Owner

Property Address 36236 Sloat Road

City Slidell County St. Tammany State LA Zip Code 70461

Client Vesna Oelsner

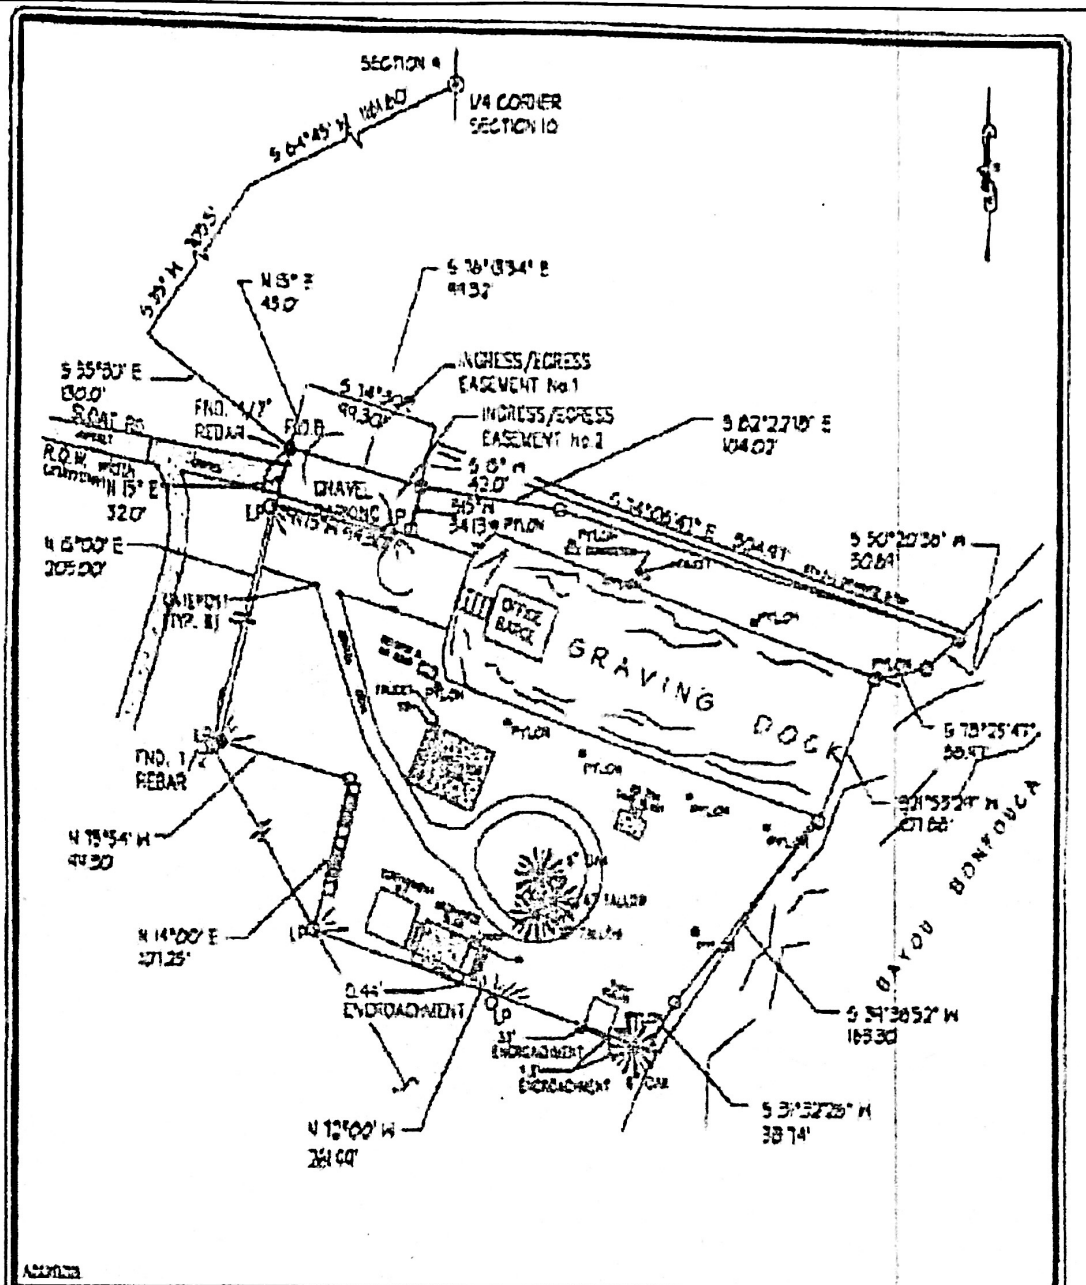

I CERTIFY THAT THIS PLAT REPRESENTS AN ACTUAL GROUND SURVEY AND THAT TO THE BEST OF MY KNOWLEDGE AND ENCROACHMENTS EXIST EITHER WAY ACROSS ANY OF THE PROPERTY LINES EXCEPT AS SHOWN

SURVEYED IN ACCORDANCE WITH THE LOUISIANA "MINIMUM STANDARDS FOR PROPERTY BOUNDARY SURVEYS" FOR A CLASS ____ SURVEY. BEARINGS ARE BASED ON RECORD BEARINGS UNLESS NOTED OTHERWISE.

ENCUMBRANCES SHOWN HEREON ARE NOT NECESSARILY EXCLUSIVE. ENCUMBRANCES OF RECORD AS SHOWN ON TITLE OR TITLE POLICY WILL BE ADDED HERETO UPON FURNISHED. SURVEYOR WAS NOT FURNISHED ANY TITLE SEARCH OR ABSTRACT.

DATE ____ DATE

* Verify prior to construction with

SURVEY NO. 1030328

DATE 2/18/03

J.V. Burkes & Associates, Inc.

SURVEYING ENGINEERING • ENVIRONMENTAL

2790 East Gause Blvd. Suite B Slidell, Louisiana 70461

PHONE • (985) 641-0078 FAX • (985) 641-0354

DRAWN BY geo

SCALE 1" = 100'

REVISED

SURVEY MADE FOR A Parcel of Land

LOCATED Section 9 T9S R14E Near Slidell

ST. TAMMANY PARISH - LOUISIANA

CERTIFIED TO HARBOUR FLEETING, LLC

STATE OF LOUISIANA
BRIAN M. BURKES
REG. NO. 4783
REGISTERED
LAND SURVEYOR

SIGNED
BRIAN M. BURKES
LA REG. NO. 4783