


FOUNDATION PLAN
SCALE: 3/16" = 1'-0"

Piers
38 ~~Blocks~~
104 Blocks

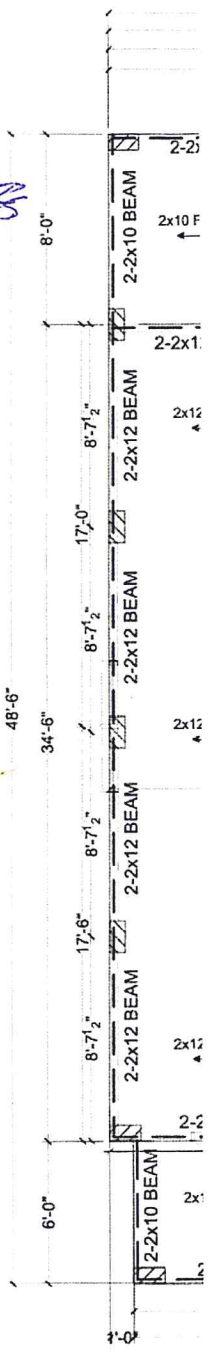

1ST FLOOR
SCALE: 3/16" = 1'-0"

16" x 16"
4 5/8"
R3333