

**GENERAL NOTES**

THE LOCATIONS OF UNDERGROUND UTILITIES AS SHOWN HEREON ARE BASED ON ABOVEGROUND STRUCTURES AND RECORD DRAWINGS PROVIDED THE SURVEYOR. LOCATIONS OF UNDERGROUND UTILITIES OR STRUCTURES MAY VARY FROM LOCATIONS SHOWN HEREON. ADDITIONAL BURIED UTILITIES OR STRUCTURES MAY BE ENCOUNTERED. NO EXCAVATIONS WERE MADE DURING THE PROGRESS OF THIS SURVEY TO LOCATE BURIED UTILITIES OR STRUCTURES.


I HAVE CONSULTED THE FLOOD INSURANCE RATE MAPS AND FOUND THIS PROPERTY IS IN A SPECIAL FLOOD HAZARD AREA. F.I.R.M. COMMUNITY MAP NO. 220204 0005 C, DATED: 4/21/99 FLOOD ZONE: AE; BASE FLOOD ELEVATION: 16'.

T.B.M. = CROSS CUT  
E.L. = 13.60'

REFERENCES:  
1.) SURVEY BY JOHN E. BONNEAU DATED 7/22/94, SURVEY NO. 94838.

**DRAINAGE NOTES**

1. ALL OPEN TOP DRAINAGE BASINS SHALL BE 12" CIRCULAR PLASTIC YARD DRAINS.
2. MINIMUM PIPE SLOPE SHALL BE 0.005 '/'.
3. PVC PIPE CAN BE SCHEDULE 40.
4. ROOF DRAINS TO TIE INTO SUBSURFACE PIPE WHERE SHOWN.

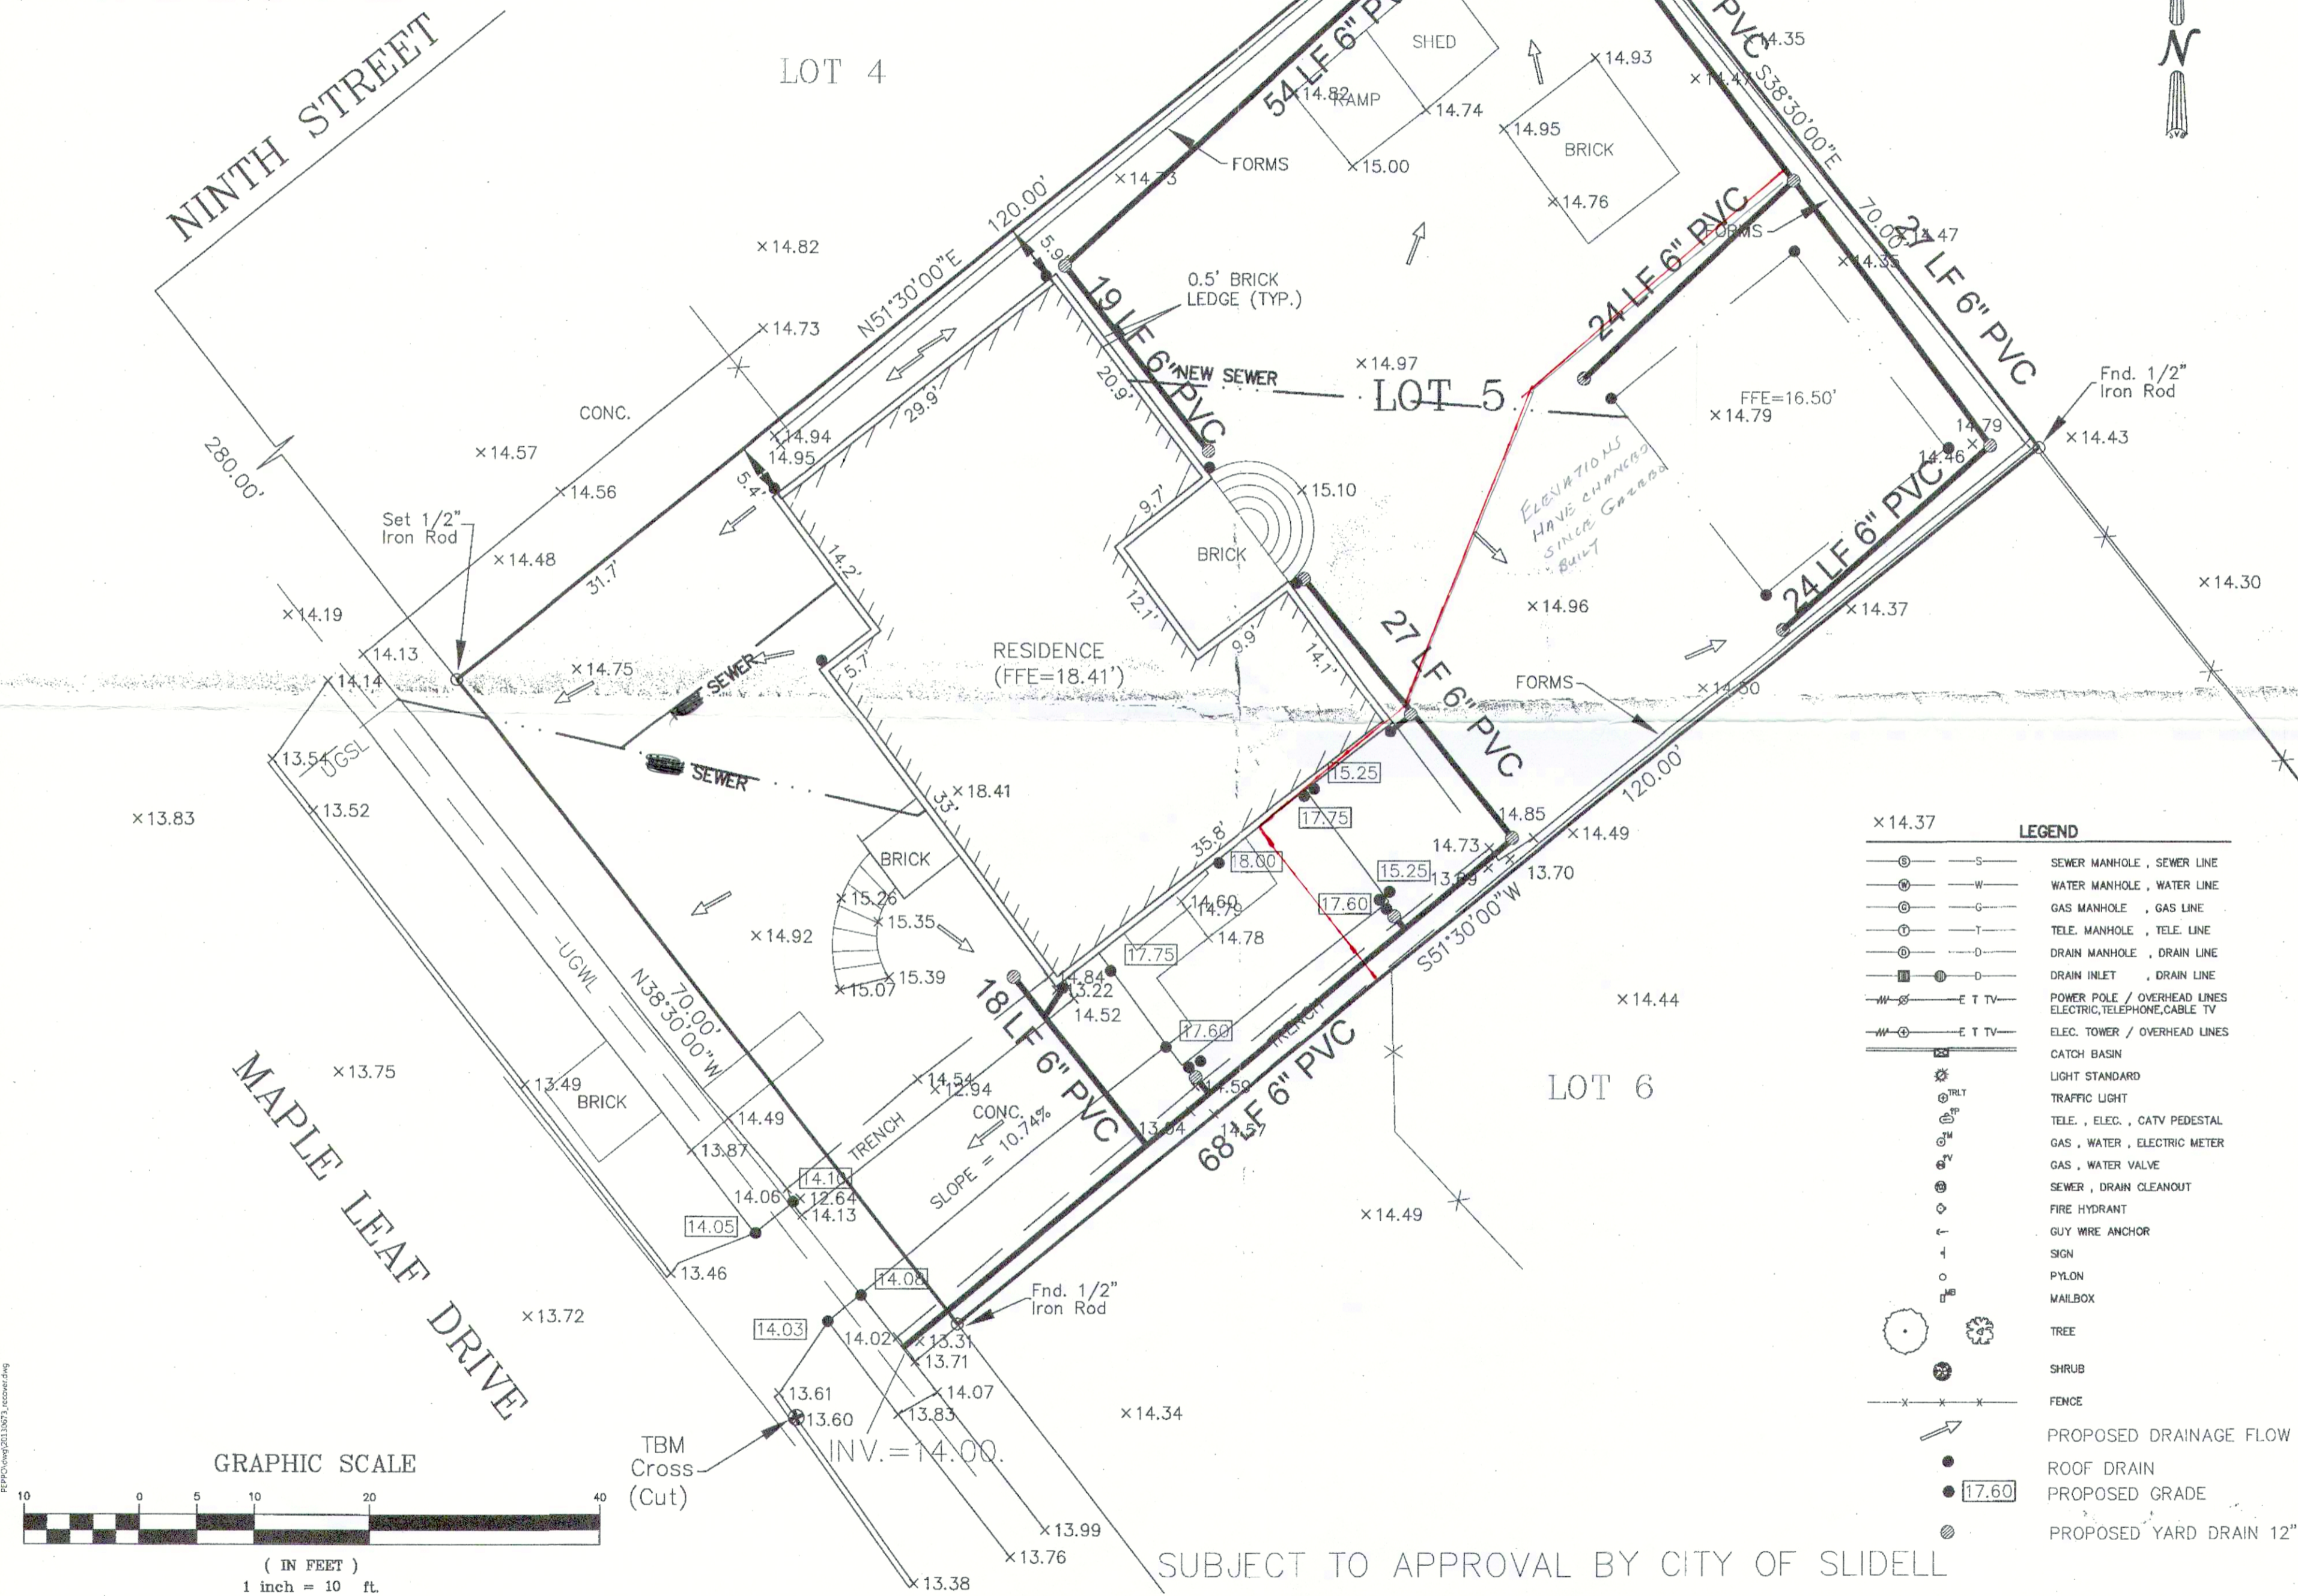

**LEGEND**

	S	SEWER MANHOLE, SEWER LINE
	W	WATER MANHOLE, WATER LINE
	G	GAS MANHOLE, GAS LINE
	T	TELE. MANHOLE, TELE. LINE
	D	DRAIN MANHOLE, DRAIN LINE
	D	DRAIN INLET, DRAIN LINE
	E T TV	POWER POLE / OVERHEAD LINES ELECTRIC, TELEPHONE, CABLE TV
	E T TV	ELEC. TOWER / OVERHEAD LINES
		CATCH BASIN
		LIGHT STANDARD
		TRAFFIC LIGHT
		TELE., ELEC., CATV PEDESTAL
		GAS, WATER, ELECTRIC METER
		GAS, WATER VALVE
		SEWER, DRAIN CLEANOUT
		FIRE HYDRANT
		GUY WIRE ANCHOR
		SIGN
		PYLON
		MAILBOX
		TREE
		SHRUB
		FENCE
		PROPOSED DRAINAGE FLOW
		ROOF DRAIN
	17.60	PROPOSED GRADE
		PROPOSED YARD DRAIN 12"


SUBJECT TO APPROVAL BY CITY OF SLIDELL

**A TOPOGRAPHIC SURVEY AND DRAINAGE PLAN  
OF LOT 5, SQ. 3,  
MAPLEWOOD PARK, PHASE 2,  
ST. TAMMANY PARISH, LOUISIANA**

SCALE:	1" = 10'
DATE:	12/4/13
DRAWN BY:	JDL
CHECKED BY:	SMB
DWG. NO.	20130673
SHEET	1 OF 1

**J.V. Burkes & Associates, Inc.**  
SURVEYING ENGINEERING • ENVIRONMENTAL

1805 Shortcut Highway  
Slidell, Louisiana 70458  
E-mail: jvbassoc@jvburkes.com  
Phone: 985-649-0075 Fax: 985-649-0154  
Mississippi Phone: 228-435-5800

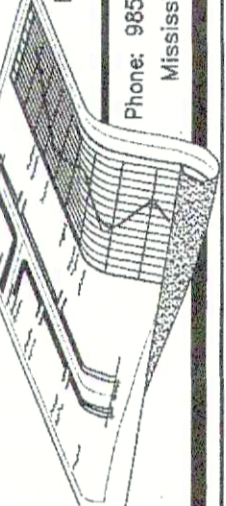

DECLARATION IS MADE TO ORIGINAL PURCHASER OF THE SURVEY. IT IS NOT TRANSFERABLE TO ADDITIONAL INSTITUTIONS OR SUBSEQUENT OWNERS. SURVEY IS VALID ONLY IF PRINT HAS ORIGINAL SEAL OF SURVEYOR.  
ELIZABETH M. PEPPLO