


LEFT SIDE

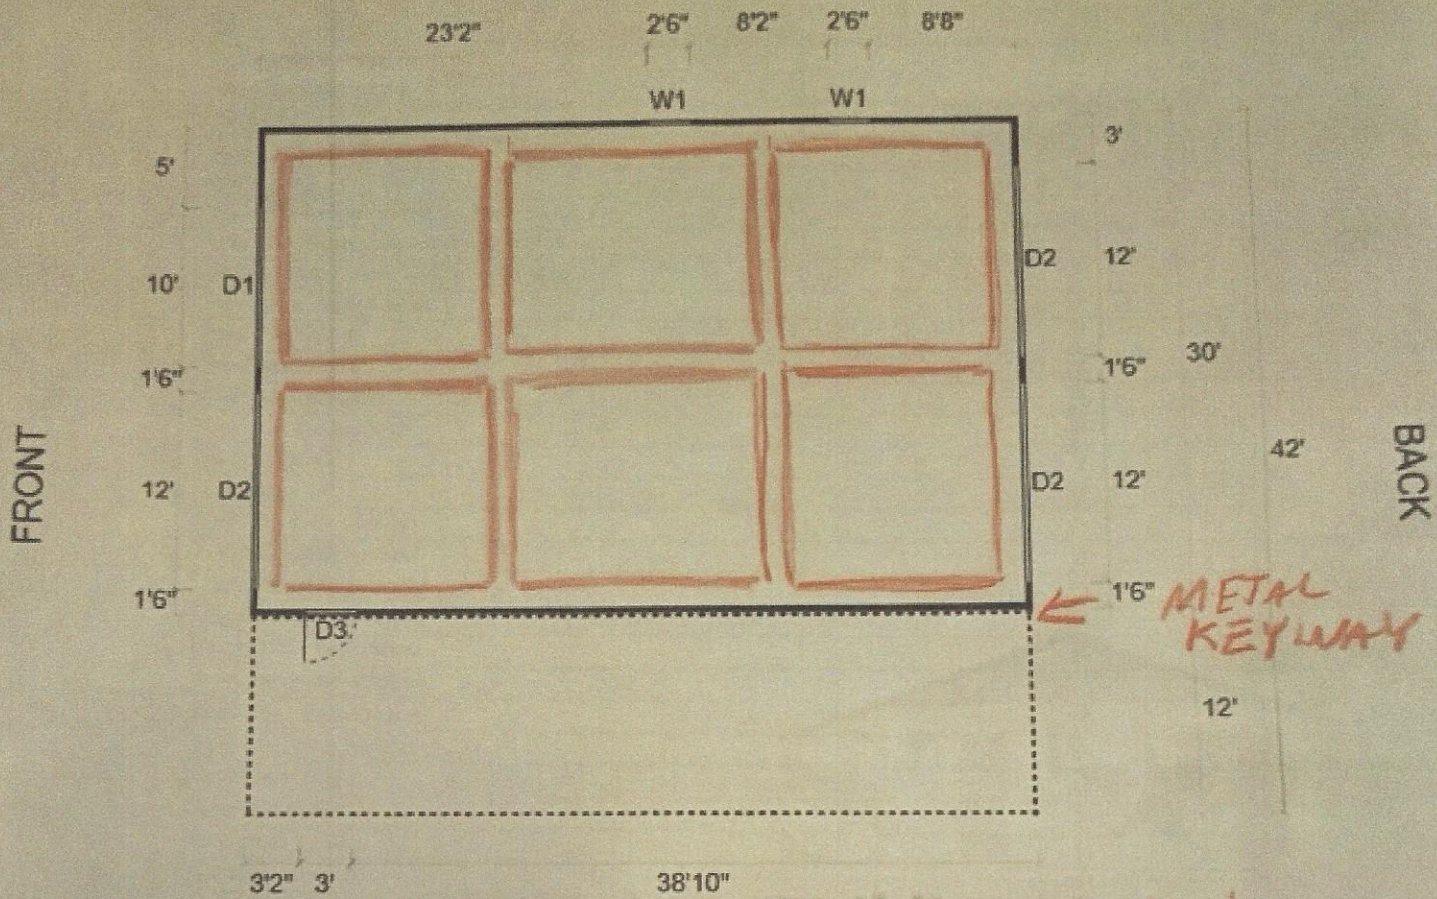

RIGHT SIDE

SYMBOL LEGEND			
	10' x 12' Garage Door		12' x 12' Garage Door (Chain Hoist Included)*
	30" x 30" With Grid		36" x 80" Walk-in Door
	Closed Wall		Open Wall

MAIN Slab parts  
 4 1/2 inch Concrete Slab  
 12" Footings  
 4 #4 Rebar on Dyt side  
 2 #4 on inside  
 6 ga WIRE MESH  
 6 MIL VAPOR BARRIER  
LEAN SLAB  
 4 1/2 Concrete Slab  
 6 ga WIRE MESH