

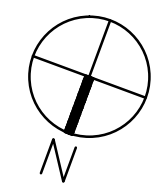
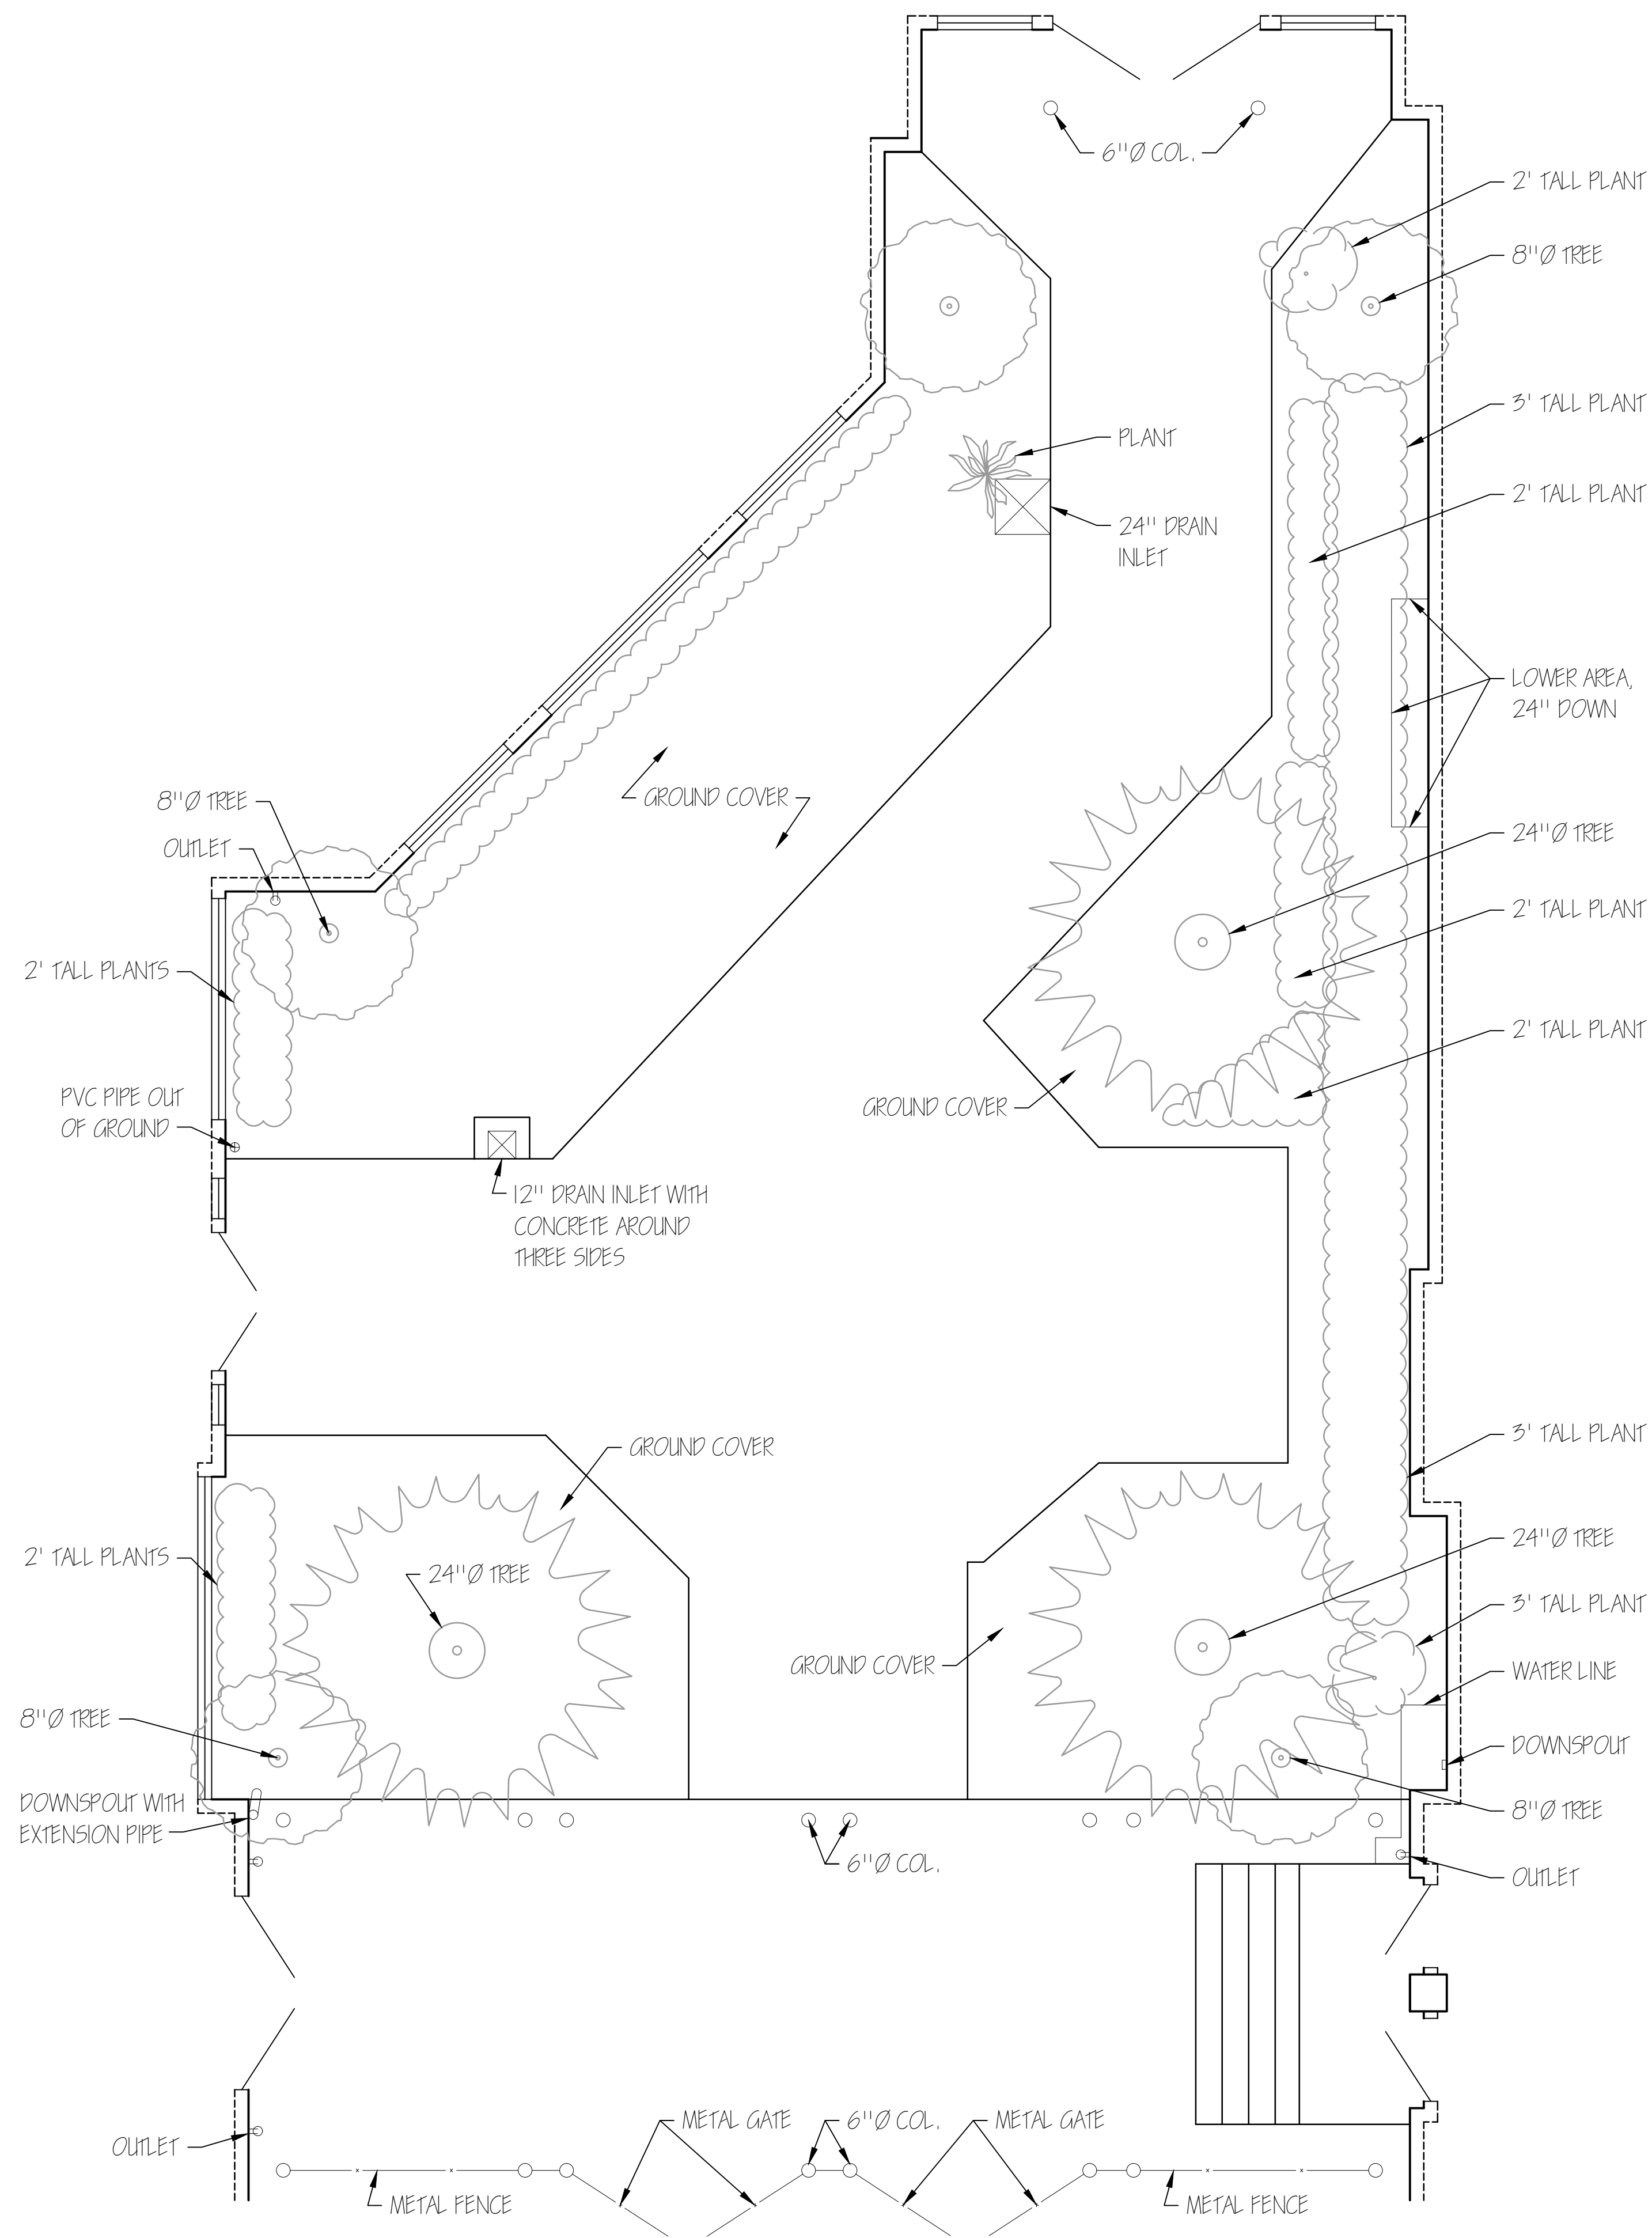


4238 ST. CHARLES AVE,
NEW ORLEANS, LA 70115

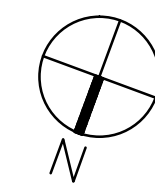

1 EXISTING SITE LAYOUT
SCALE: 1/4" = 1'-0"

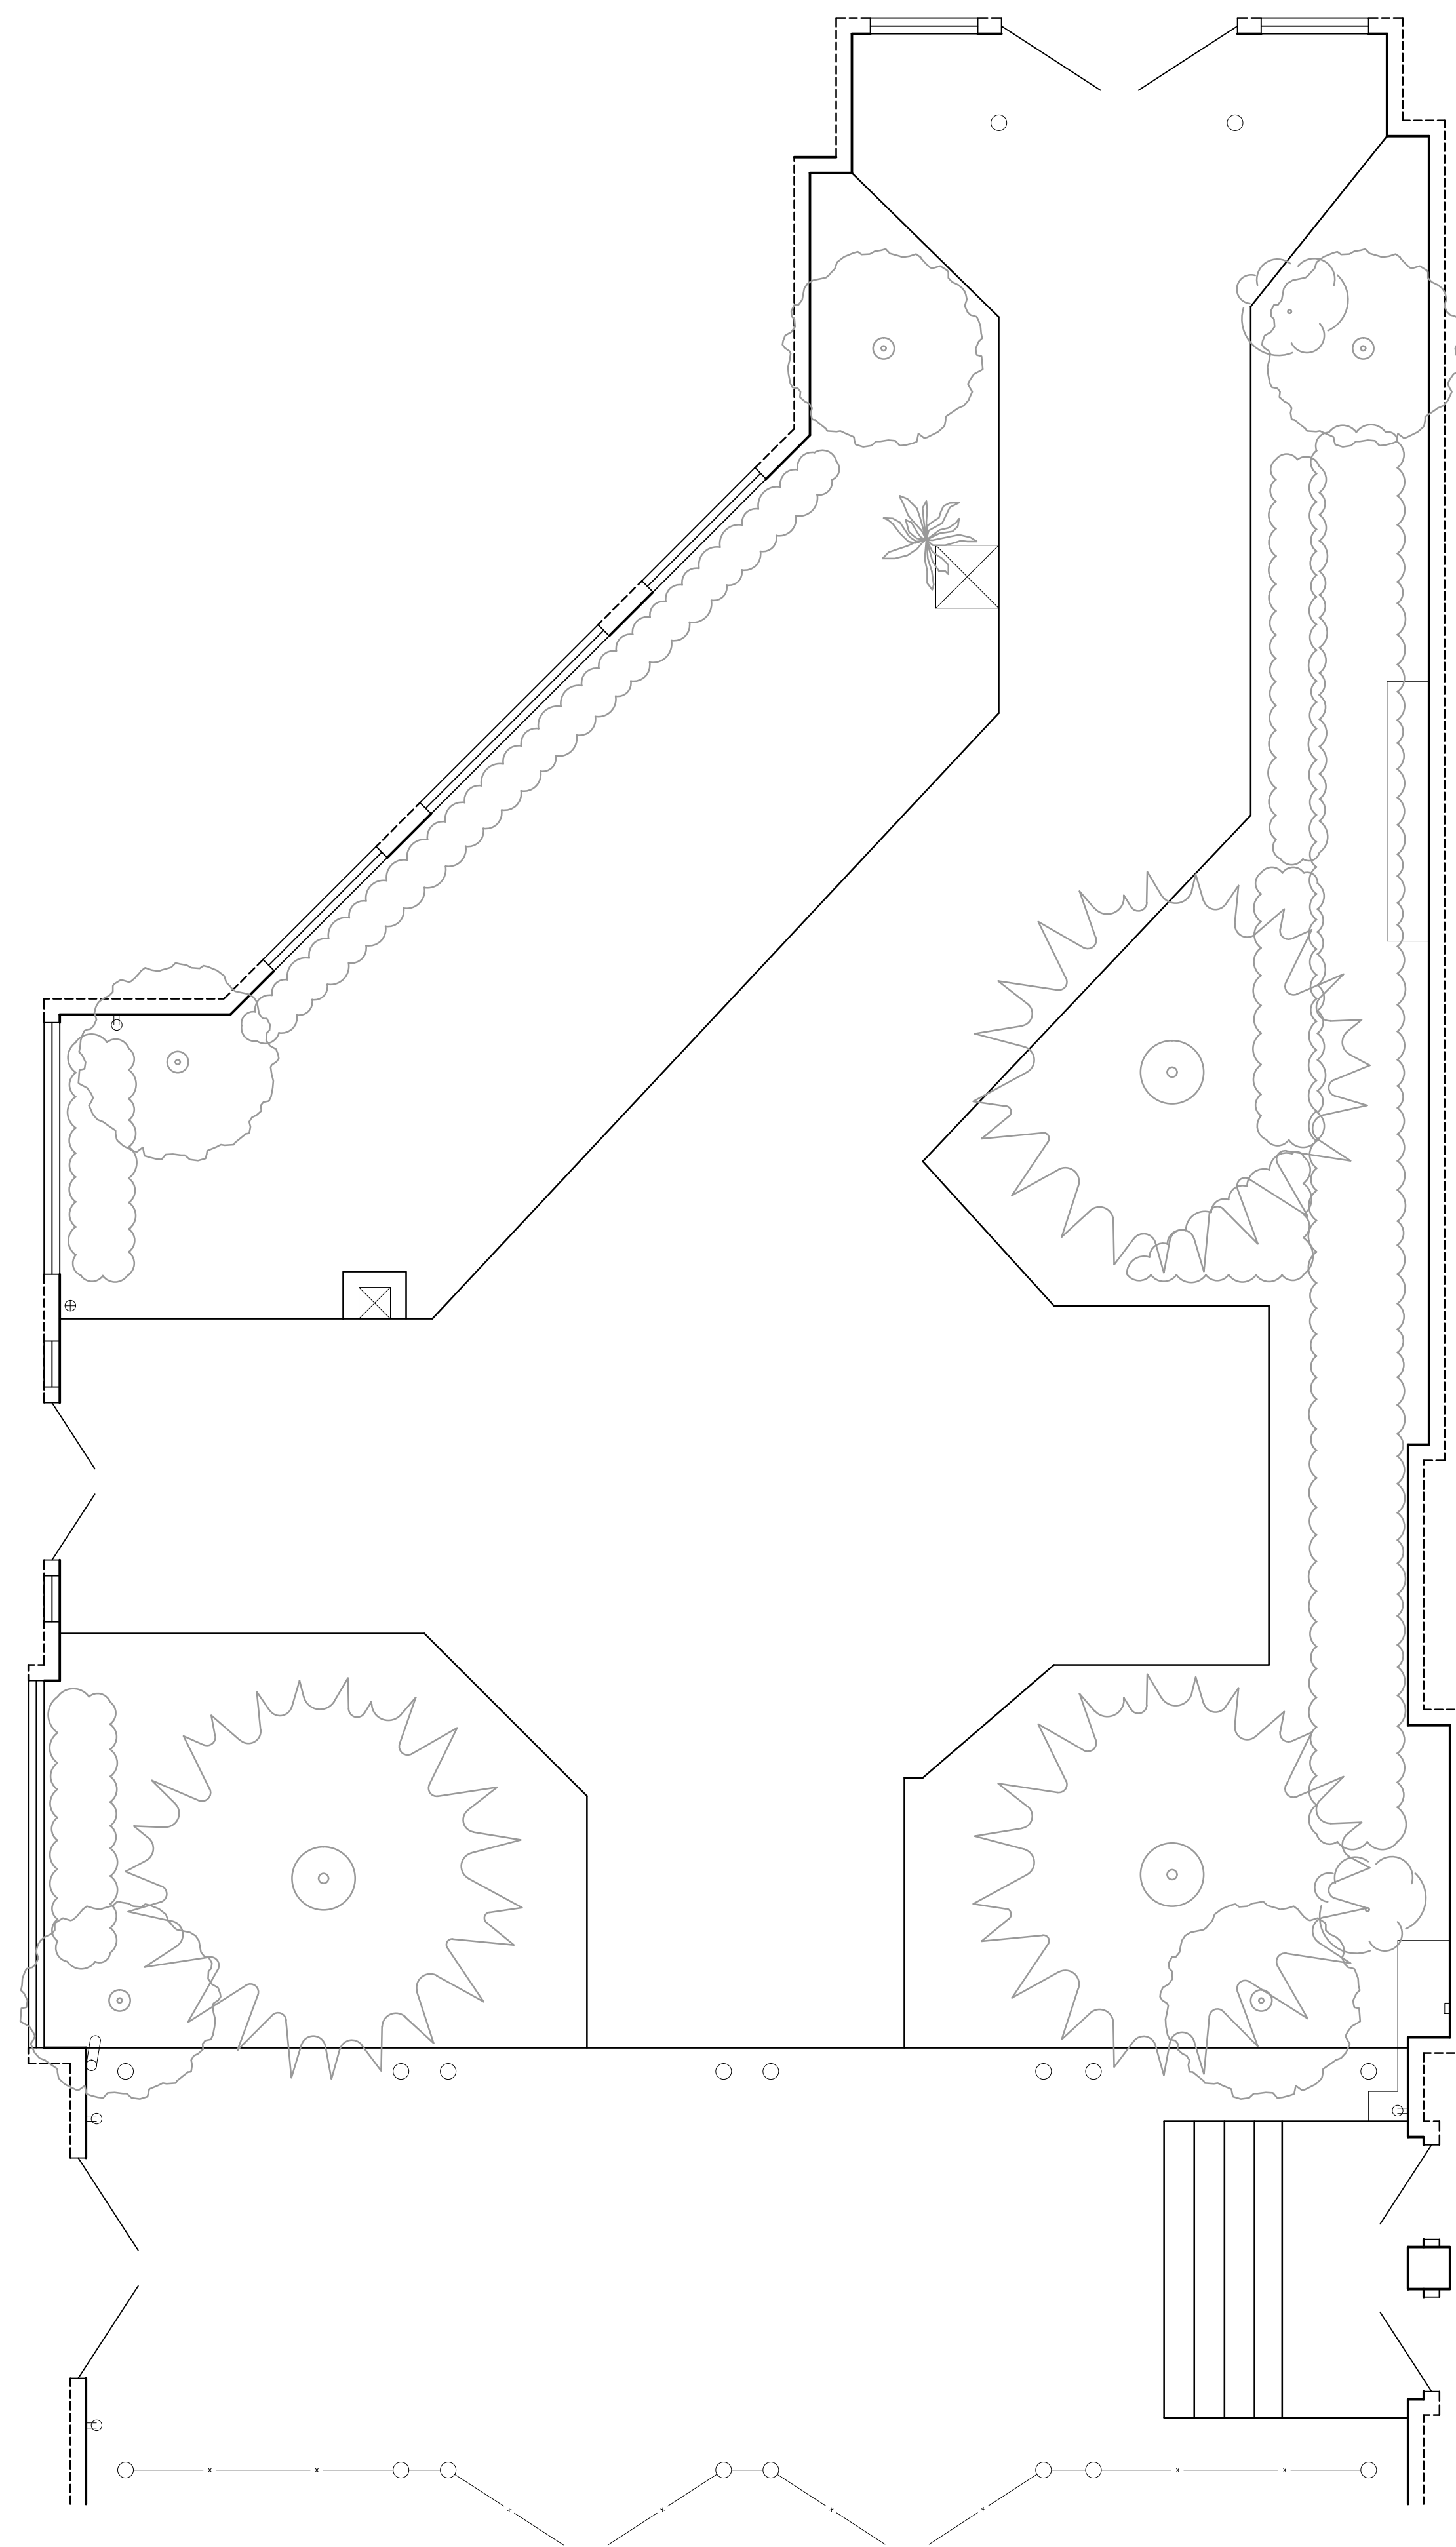

2 EXISTING SITE LAYOUT
SCALE: 1/4" = 1'-0"

Drawn by: KMG
Sheet #: S-1
Date: 07/01/2020
Scale: AS SHOWN