WIND SPEED

THE CONSTRUCTION FOR SAID HOUSE, WIND SPEED IS 150 MPH. THIS DESIGN IS IN ACCORDANCE WITH: AMERICAN WOOD COUNCIL, WOOD FRAME CONSTRUCTION MANUAL FOR ONE AND TWO FAMILY DWELLINGS (WFCM) 2015 EDITION AS WELL AS THE INTERNATIONAL RESIDENTIAL CODE (IRC) 2015 EDITION.

SHEET INDEX

SHEET #	SHEET TITLE
C101	SITE PLAN
S101	FOUNDATION AND BUILDING SECTIONS
S102	CONNECTION DETAILS, SCHEDULES & NOTES
A101	FLOOR PLAN
A102	BUILDING ELEVATIONS & ROOF PLAN

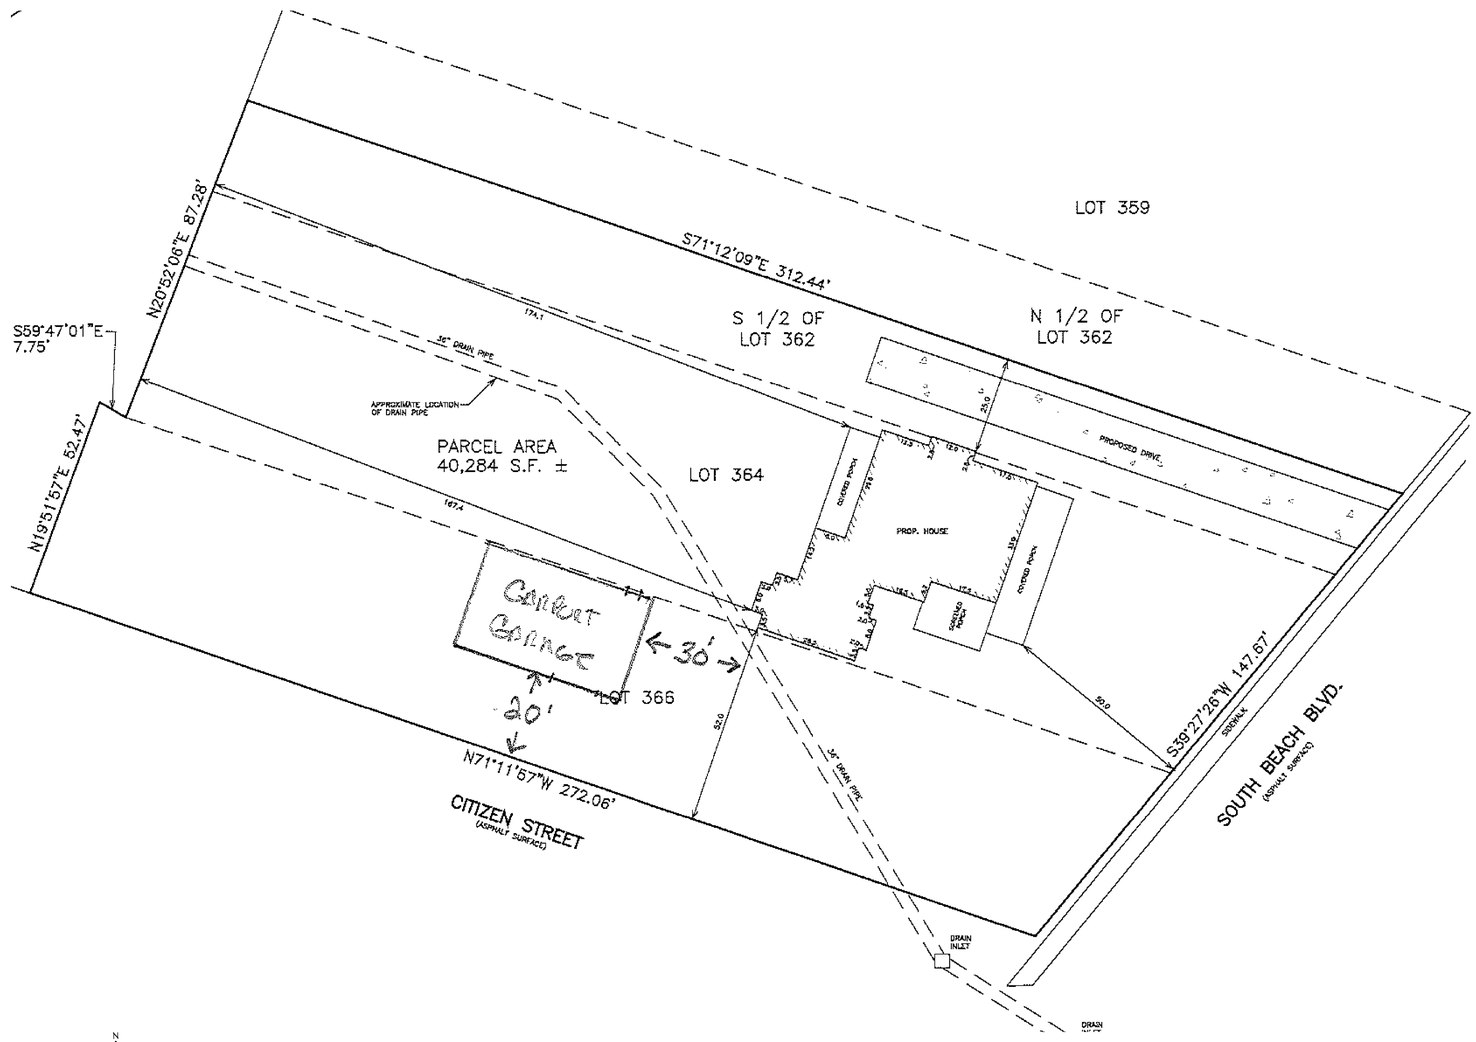

N

1 SITE PLAN
SCALE: 1" = 15'-0"

DAMMON ENGINEERING, INC.
LOUISIANA & MISSISSIPPI
www.dammonengineering.com
info@dammonengineering.com
PH: 985.649.5832
Chief Engineer: Brian Mistich, PE
5540 Oakwood Trail
Slidell, LA 70458

#	DESCRIPTION	DATE

REVISIONS

SEAL:

NEW GARAGE

MARTY HOPKINS

612 SOUTH BEACH BLVD
BAY ST LOUIS, MS 39520

JOB No:
DATE: 05-10-23
DRAWN BY: CKD
CHECKED BY: BAM

These plans and specifications are the property of Dammon Engineering, and are not transferable. Any reproduction or use of these plans and specifications without written consent of Dammon Engineering is prohibited. Any alterations made to these plans and specifications without written consent of Dammon Engineering, or any reuse of these plans and specifications on other projects, shall be at the owner's and the contractor's sole risk and without liability to Dammon Engineering.

SHEET TITLE:
SITE PLAN

DRAWING NUMBER:
C101

SHEET No: 1 of 5