WIND SPEED

THE CONSTRUCTION FOR SAID HOUSE, WIND SPEED IS 150 MPH. THIS DESIGN IS IN ACCORDANCE WITH: AMERICAN WOOD COUNCIL, WOOD FRAME CONSTRUCTION MANUAL FOR ONE AND TWO FAMILY DWELLINGS (WFCM) 2018 EDITION AS WELL AS THE INTERNATIONAL RESIDENTIAL CODE (IRC) 2018 EDITION.

SHEET INDEX

SHEET #	SHEET TITLE
C101	SITE PLAN
S101	FOUNDATION AND BUILDING SECTIONS
S102	CONNECTION DETAILS, SCHEDULES & NOTES
A101	FLOOR PLAN
A102	BUILDING ELEVATIONS & ROOF PLAN

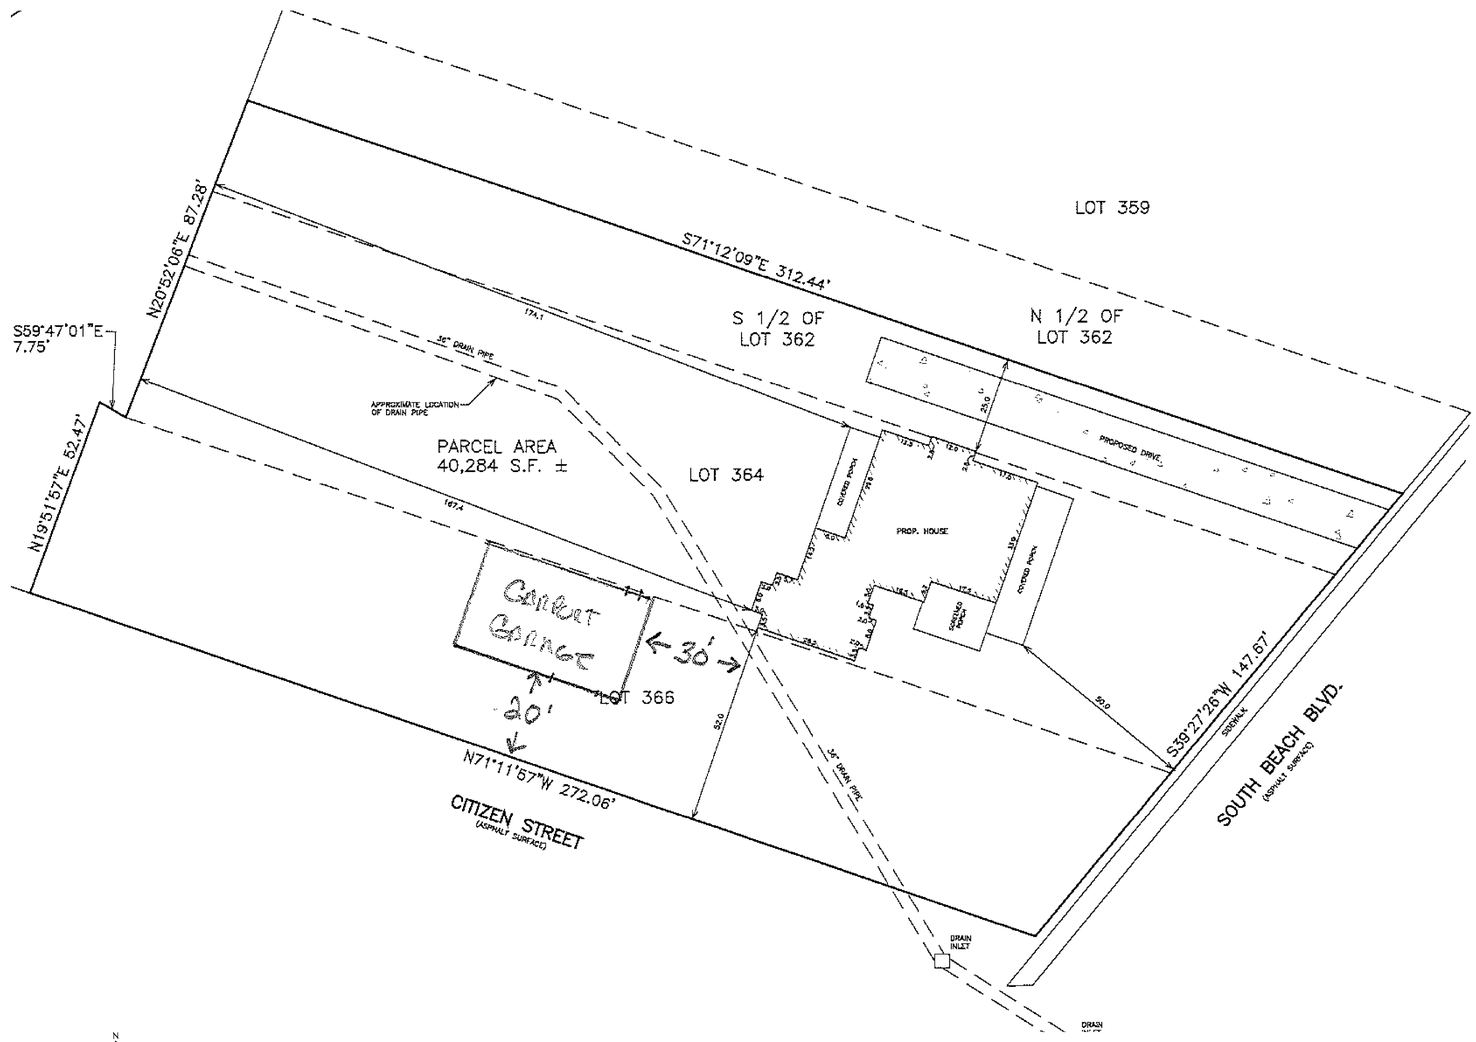

N

1 SITE PLAN
SCALE: 1" = 15'-0"

DAMMON ENGINEERING, INC.
LOUISIANA & MISSISSIPPI
www.dammonengineering.com
info@dammonengineering.com
PH: 985.649.5832

Chief Engineer: Brian Mistich, PE
5540 Oakwood Trail
Slidell, LA 70458

#	DESCRIPTION	DATE

REVISIONS

SEAL:

BRIAN A. MISTICH
LICENSED PROFESSIONAL ENGINEER
20971
STATE OF MISSISSIPPI

NEW GARAGE

MARTY HOPKINS

612 SOUTH BEACH BLVD
BAY ST LOUIS, MS 39520

JOB No: | DATE: 05-11-23
DRAWN BY: GKD | CHECKED BY: BAM

SHEET TITLE:
SITE PLAN

DRAWING NUMBER:
C101

SHEET No: 1 of 5