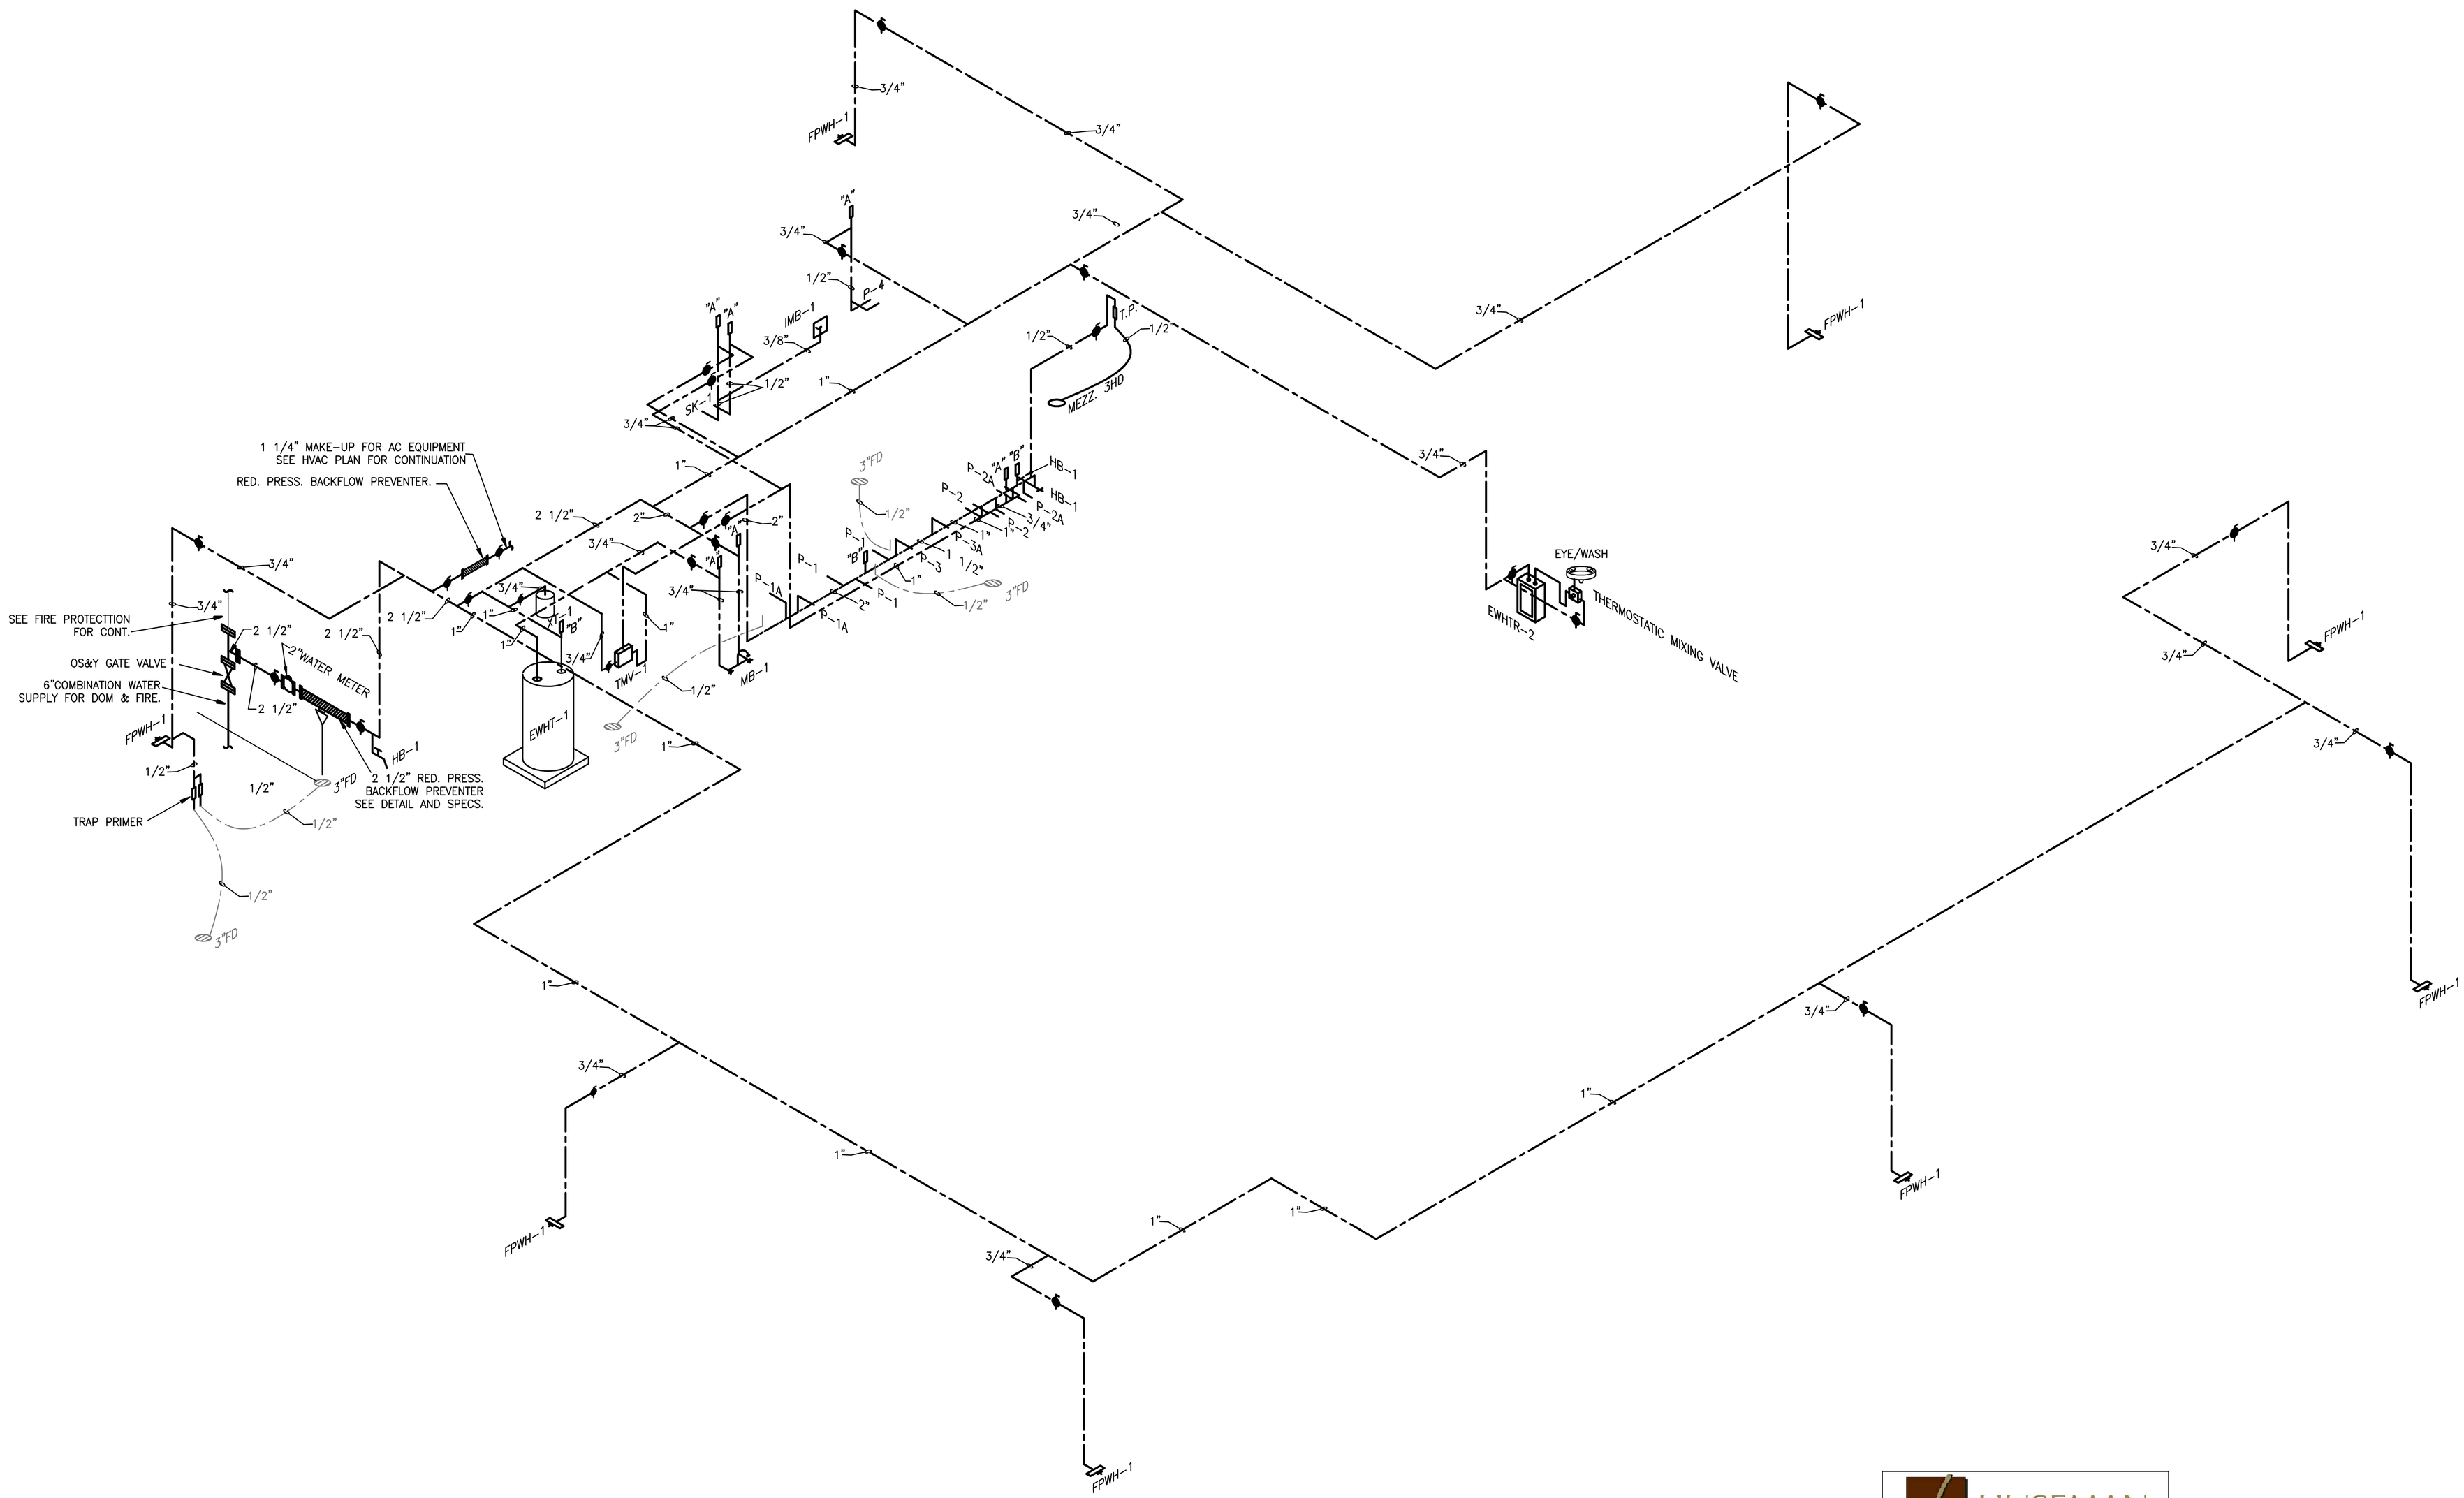

WATER DISTRIBUTION RISER DIAGRAM

NOT TO SCALE

1
P-05

HUSEMAN & Associates
MECHANICAL ▪ ELECTRICAL ▪ PLUMBING ▪ FIRE PROTECTION
3925 N I-10 SERVICE RD (504) 456-3119
SUITE 201B, METAIRIE, LA 70002 FAX (504) 456-3122
Job No. 0900301 Designed By RM
Drawn By RM Checked By CB

WALDEMAR S. NELSON AND COMPANY
INCORPORATED
ENGINEERS AND ARCHITECTS
1200 ST. CHARLES AVE NEW ORLEANS, LA.

BROADMOOR
BUILDING by DESIGN
BROADMOOR, L.L.C.
2740 North Arnoult Road
Metairie, Louisiana 70002
www.broadmoorllc.com

DRAWING REVISIONS

REV.	DESCRIPTION	PREP BY	DATE	APPRVD.
0	FINAL DESIGN	RM	10/29/09	CB

NAS JRB New Orleans — Belle Chasse, Louisiana

NAVAIRSEFAC CALIBRATION BLDG.
PLUMBING WATER RISER DIAGRAM

DATE: AUGUST 22, 2008 — ETD FOR COMMANDER, NAVFAC — APPROVED

NAVFAC
Naval Facilities Engineering Command
Southeast Division, Jacksonville, FL

STATE OF LOUISIANA
THOMAS W. BOYLE, JR.
REG. NO. 16400
REGISTERED PROFESSIONAL ENGINEER IN MECHANICAL ENGINEERING

RECORD DRAWING DATE 10/29/2009
CODE I.D. NO. –
DRAWING SIZE: D
SPEC. NO.06– –
CONSTRN. CONTR. NO. –
NAVFAC DRAWING NO. 15030954
SHEET 8 OF 11
P–05.1