


John S. Tegarden
 REGISTERED PROFESSIONAL LAND SURVEYOR
 REGISTRATION NO. 4635

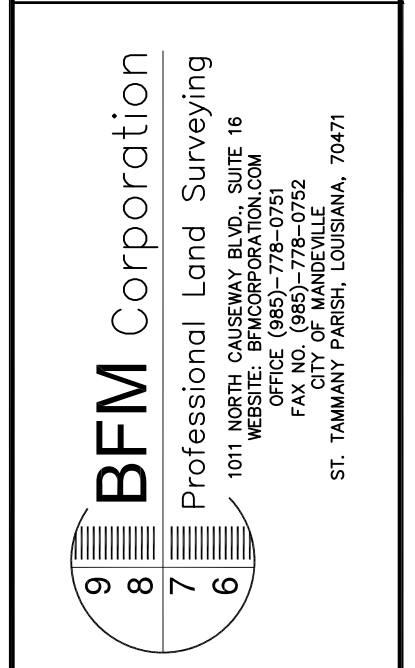

A SEWER SURVEY OF
 BRIDGE CITY CENTER FOR YOUTH
 IN SECTIONS 2 & 3, T-13-S, R-23-E,
 WITHIN JEFFERSON PARISH, LOUISIANA

I certify that this plot represents an actual ground survey made by me or under my direction, and it is true and correct in all particulars. I am a duly Licensed Professional Surveyor as found in Louisiana Administrative Code Title 46, L.A.C. Chapter 29 for a Class "C" survey.

#1	REVISION RECORD	DATE	BY	CHK'D
02-25-13	Revised Sewer Lines between building #17 & #18			

SCALE: 1" = 40'

DATE: 01-14-13

DRAWN BY: J.B.M.

CHECKED BY: J.B.M.

PROJECT NO. 809B DRAWING NO. 809B

SHEET 1 OF 1