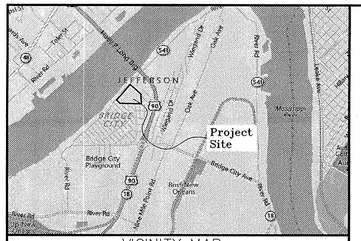

VICINITY MAP

NOT TO SCALE

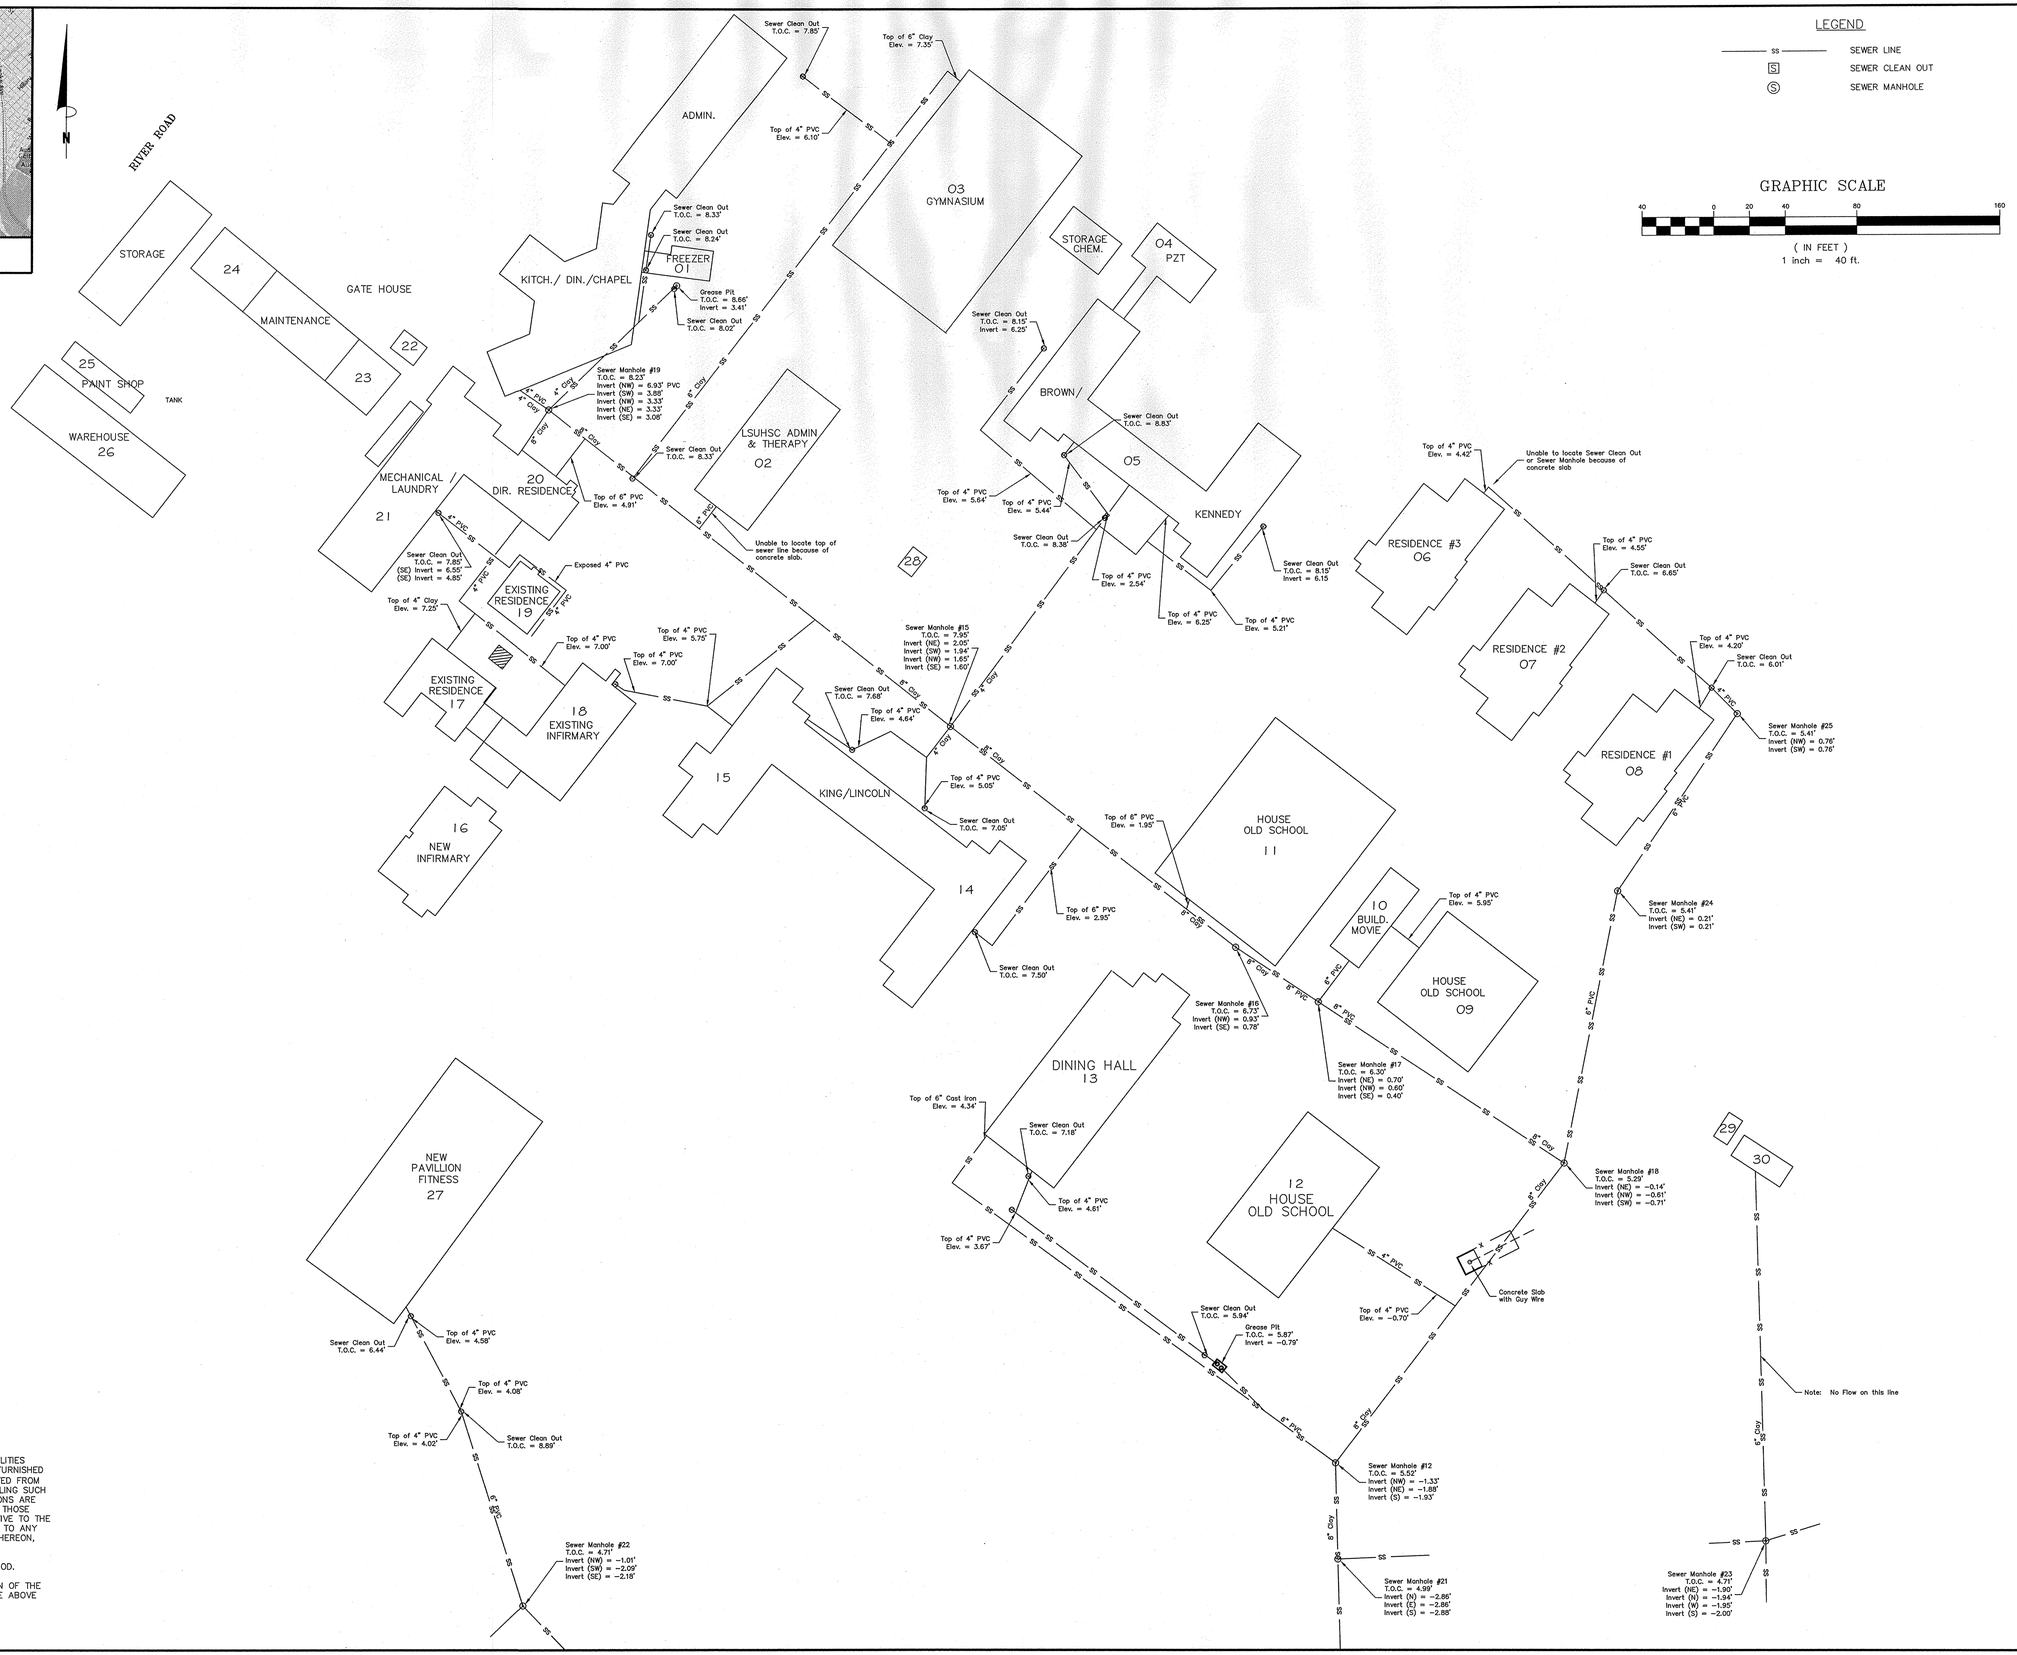

LEGEND

SS	SEWER LINE
S	SEWER CLEAN OUT
S	SEWER MANHOLE

GRAPHIC SCALE

40 0 20 40 80 160

(IN FEET)

1 inch = 40 ft.

GENERAL NOTES

1. THE LOCATIONS OF UNDERGROUND AND OTHER NONVISIBLE UTILITIES SHOWN HEREON HAVE BEEN DETERMINED FROM DATA EITHER FURNISHED BY THE AGENCIES CONTROLLING SUCH DATA AND/OR EXTRACTED FROM RECORDS MADE AVAILABLE TO US BY THE AGENCIES CONTROLLING SUCH RECORDS. WHERE FOUND, THE SURFACE FEATURES OF LOCATIONS ARE SHOWN. THE ACTUAL NONVISIBLE LOCATIONS MAY VARY FROM THOSE SHOWN HEREON. EACH AGENCY SHOULD BE CONTACTED RELATIVE TO THE PRECISE LOCATION OF ITS UNDERGROUND INSTALLATION PRIOR TO ANY RELIANCE UPON THE ACCURACY OF SUCH LOCATIONS SHOWN HEREON, INCLUDING PRIOR TO EXCAVATION AND DIGGING.
2. ALL ELEVATIONS SHOWN REFER TO NAVD 88 DATUM, 2009 GEOID.
3. NOTE: THE UNDERSIGNED DOES NOT CERTIFY TO THE LOCATION OF THE ANY IMPROVMENTS SHOWN OTHER THAN THE LOCATION OF THE ABOVE GROUND SEWER AS SHOWN.

STATE OF LOUISIANA
JOHN S. TEEGARDEN
License No. 4635
PROFESSIONAL
LAND SURVEYOR

REGISTERED PROFESSIONAL LAND SURVEYOR
JOHN S. TEEGARDEN
REGISTRATION NO. 4635

BFM Corporation
Professional Land Surveying
1101 NORTH CAUSEWAY BLVD., SUITE 16
MANDEVILLE, LOUISIANA 70471
OFFICE (985)-778-0701
FAX (985)-778-0722
CITY OF MANDEVILLE
ST. TAMMANY PARISH, LOUISIANA, 70471

A SEWER SURVEY
OF
BRIDGE CITY CENTER FOR YOUTH
IN
SECTIONS 2 & 3, T-13-S, R-23-E,
WITHIN
JEFFERSON PARISH, LOUISIANA

I certify that this plat represents an actual ground survey made by me or under my direction, and it does not violate any provisions of the Minimum Standards for Property Boundary Surveys as found in Louisiana Administrative Code TITLE 46, LXI, Chapter 29 for a Class C survey.

BRIDGE CITY CENTER FOR YOUTH

MARK	DESCRIPTION	DATE	BY	CHK'D
	REVISION RECORD			

SCALE: 1" = 40'

DATE: 01-14-13

DRAWN BY: J.B.M.

CHECKED BY: J.B.M.

PROJECT NO. 8098

DRAWING NO. 8098

SHEET 1 OF 1