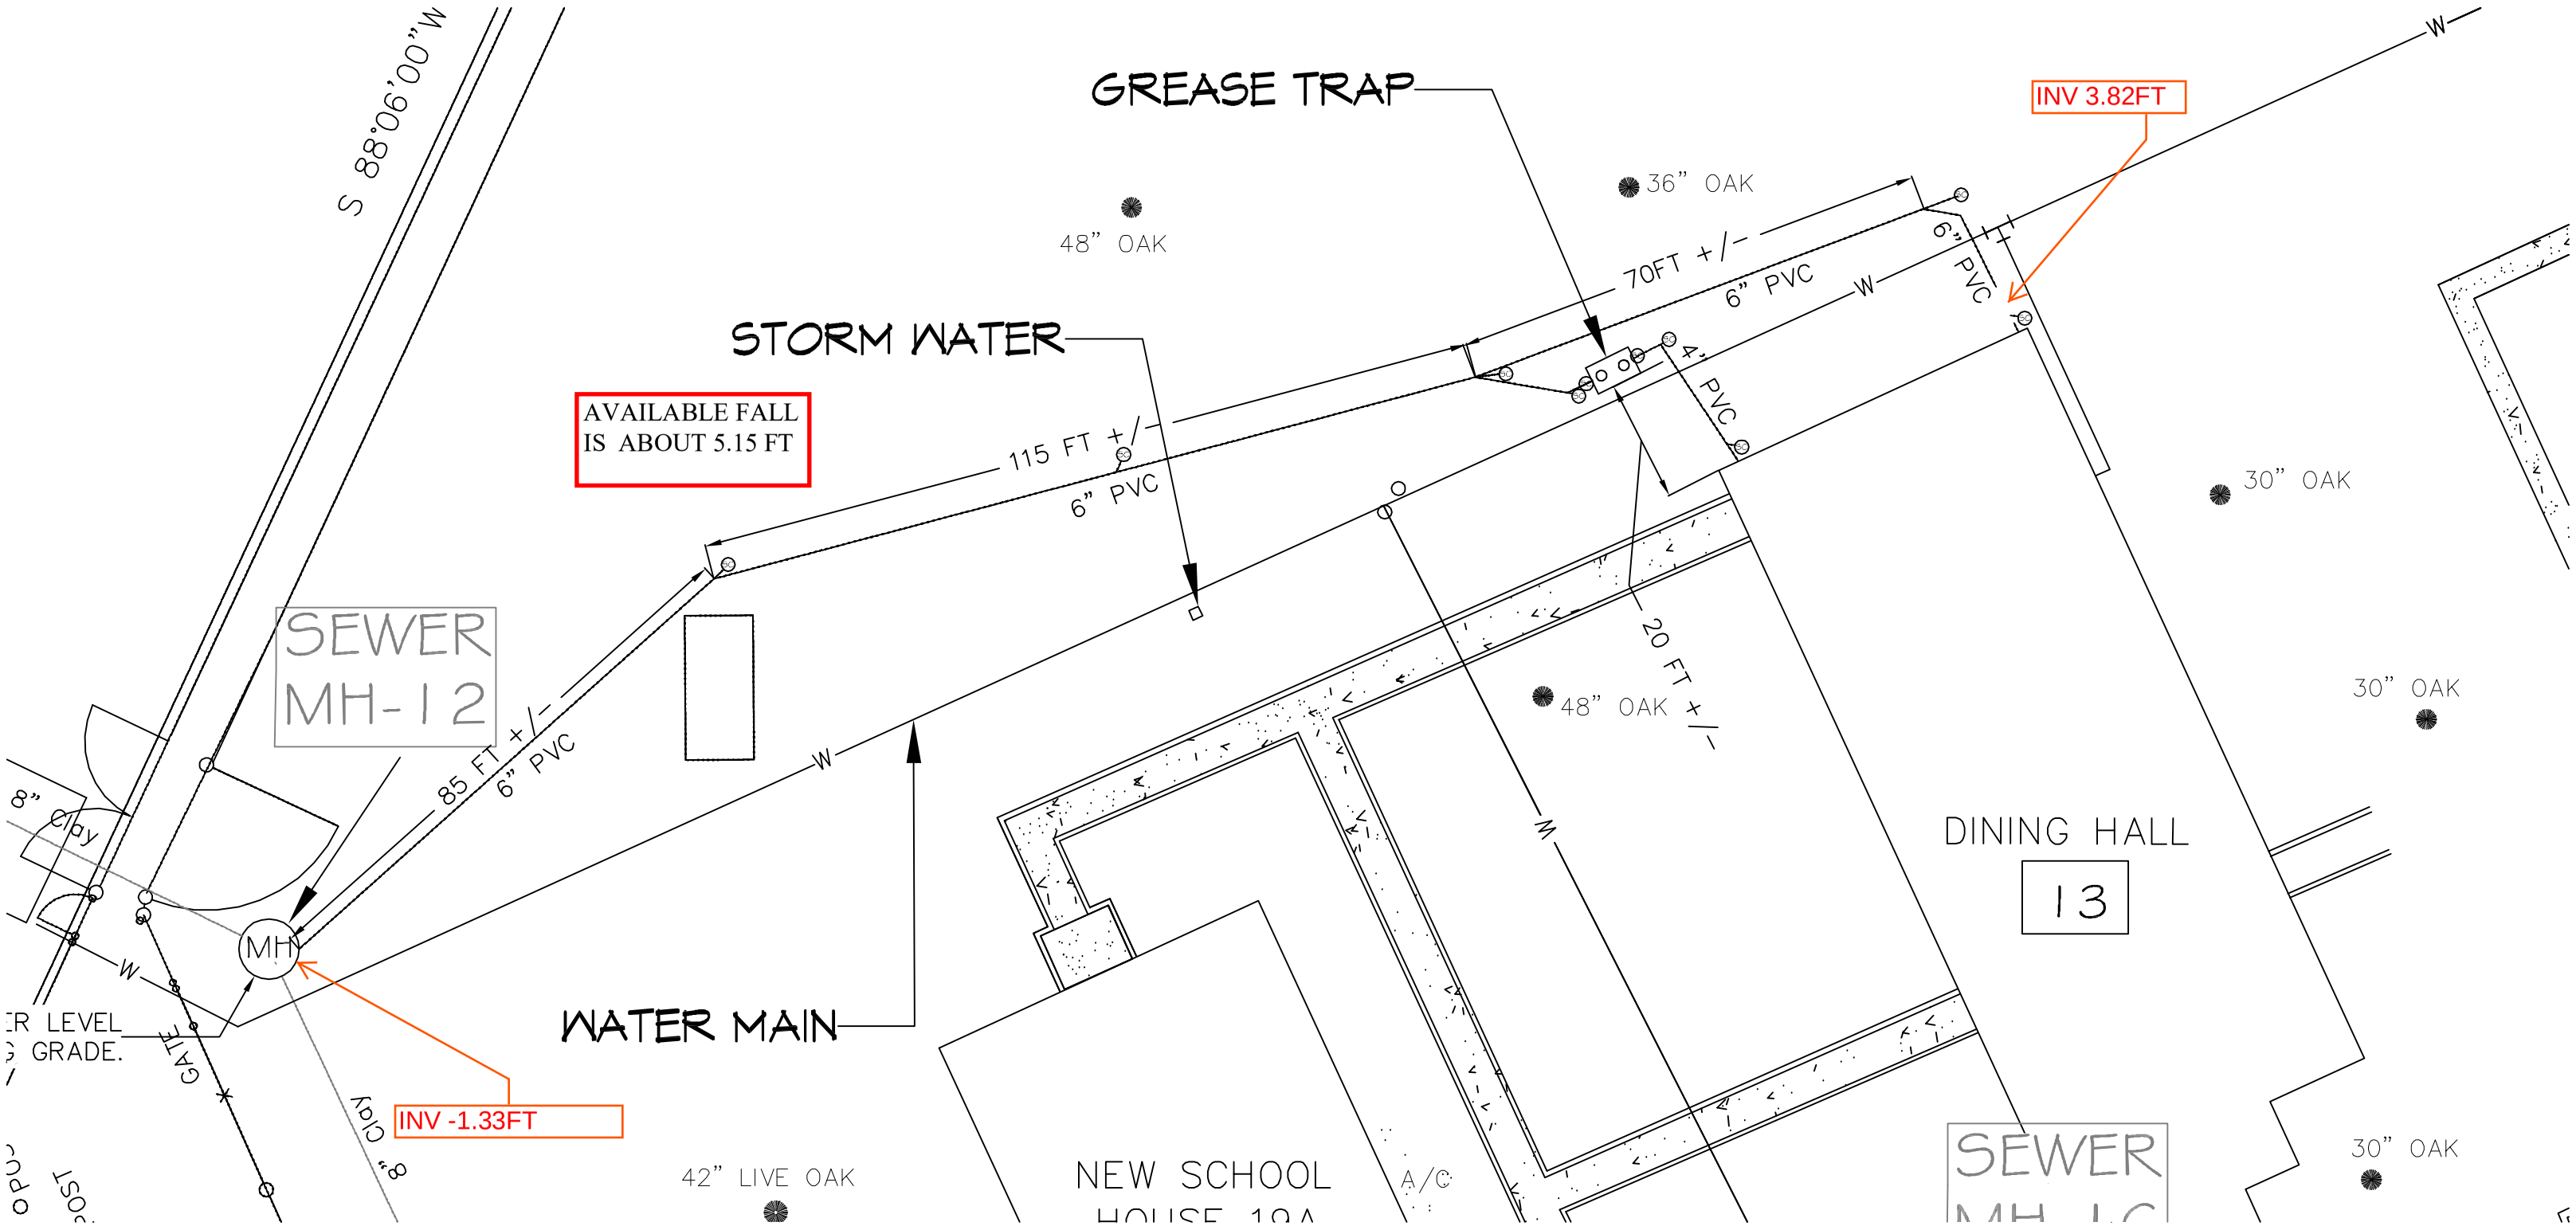
S 88°06'00"W
GREASE TRAP
INV 3.82FT
36" OAK
48" OAK
70FT +/-
6" PVC
W
6" PVC
STORM WATER
AVAILABLE FALL
IS ABOUT 5.15 FT
115 FT +/-
6" PVC
4" PVC
30" OAK
SEWER
MH-12
85 FT +/-
6" PVC
20 FT +/-
48" OAK
30" OAK
8" Clay
W
DINING HALL
13
MH
WATER MAIN
GATE
INV -1.33FT
8" Clay
42" LIVE OAK
NEW SCHOOL
HOUSE 19A
A/C
SEWER
MH-1C
30" OAK