

Approximately 85 ft installed, estimated 180 ft



**LEGEND**

- SS — SS — EXISTING SEWER LINE TO REMAIN
- SS-LAT — NEW GRAVITY SEWER LATERAL
- SC — SEWER CLEAN-OUT
- MH — EXISTING MANHOLE
- 09 — BLDG NUMBER
- IA — DESIGNATED REPAIR NOTES ON C-2

NOTE: SEWER CLEAN-OUTS AND MANHOLES DRAWN LARGER THAN SCALE FOR CLARITY. MAINLINE AND LATERAL DIMENSIONS ARE APPROXIMATE.


Area #3

Area #2

Area #1

Area #1B Alternate

Area #4

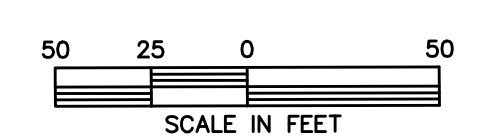

**SITE PLAN**  
SCALE: 1" = 50'



**DAMMON ENGINEERING, INC.**  
554 Old Spanish Trail  
Burrhead, LA 70058  
(865) 649-5832

www.dammonengineering.com  
info@dammonengineering.com  
PH: 865.649.5832

Chief Engineer: Brian Matich, PE  
554 Old Spanish Trail  
Burrhead, LA 70058

REVISIONS	DATE
1 CHANGE ORDER PROPOSAL REQUEST #1	7/27/2017

SEAL:

**SEWER SYSTEM RENOVATION:**  
**PROJECT NUMBERS: 08-408-11-01 PART 1 & 08-408-04B-01, PART 20 & 01-10T-06B-11, Part UT**  
**BRIDGE CITY CENTER FOR YOUTH**

3225 RIVER ROAD  
BRIDGE CITY, LA 70094  
JOB No: 2156 DATE: 10/1/2016  
DRAWN BY: DPD CHECKED BY: BAW

SHEET TITLE:  
SITE PLAN

DRAWING NUMBER:  
**C-3**

SHEET No: 4 of 5