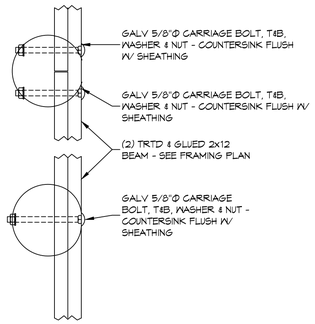

G | S1 | S1 **DETAIL**
SCALE: N.T.S.

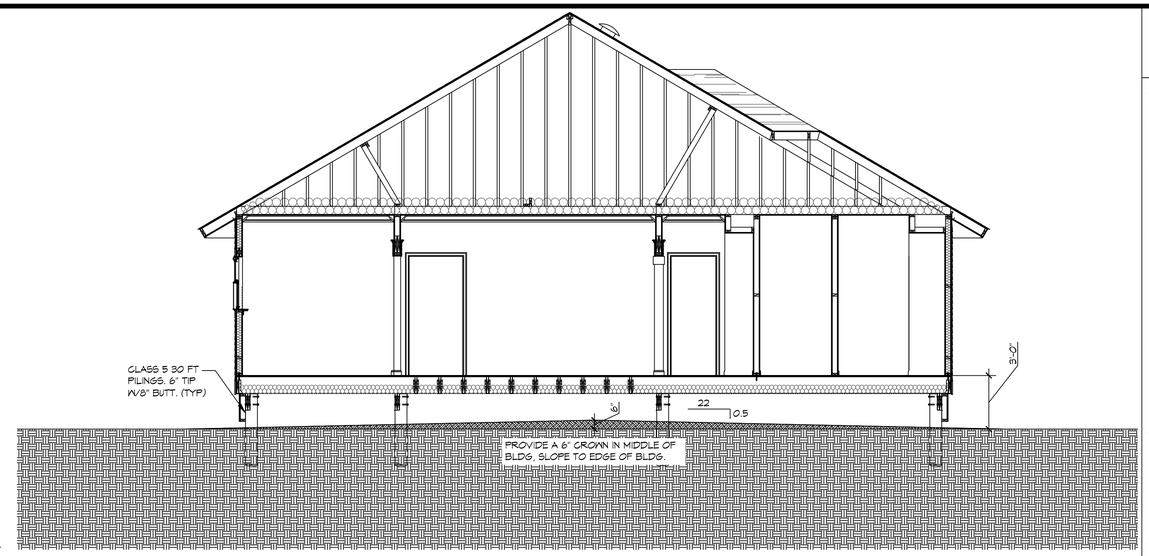

2 | S1 | S1 **SECTION**
SCALE: 1/4" = 1'-0"

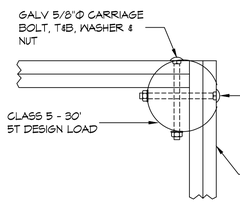

E | S1 | S1 **DETAIL**
SCALE: N.T.S.

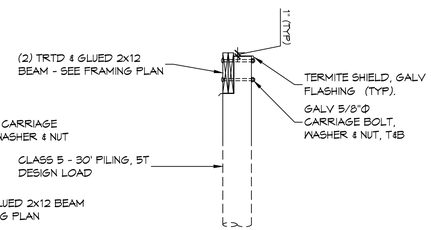

F | S1 | S1 **DETAIL**
SCALE: N.T.S.

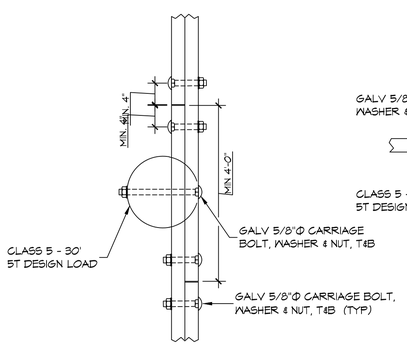

C | S1 | S1 **DETAIL**
SCALE: N.T.S.

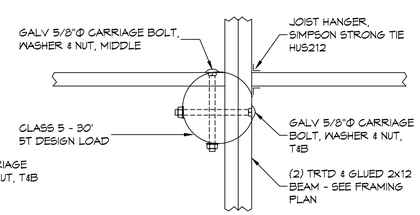

D | S1 | S1 **DETAIL**
SCALE: N.T.S.

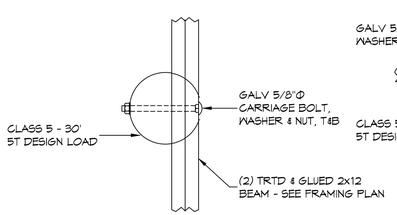

A | S1 | S1 **DETAIL**
SCALE: N.T.S.

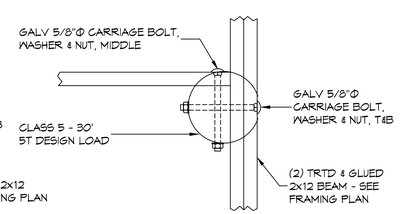

B | S1 | S1 **DETAIL**
SCALE: N.T.S.

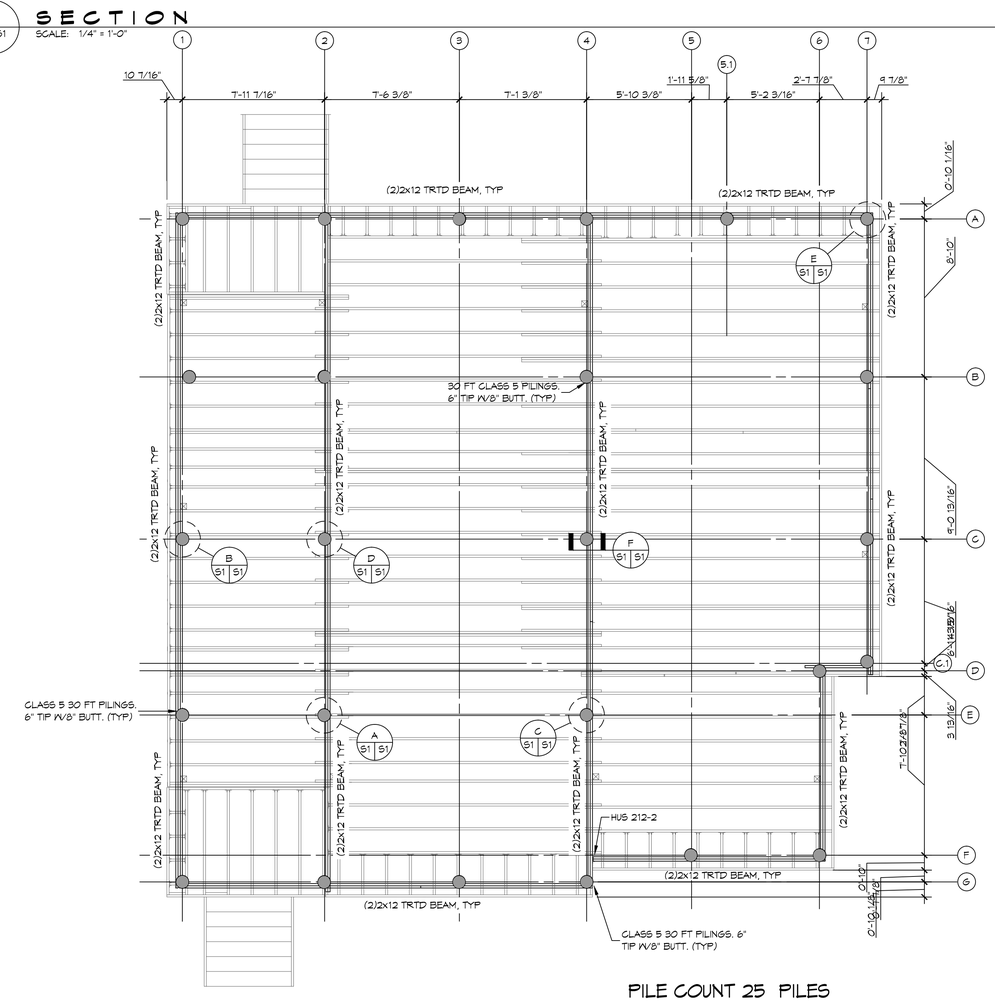

PILE COUNT 25 PILES

1 | S1 | S1 **PILING/FRAMING PLAN**
SCALE: 1/4" = 1'-0"

GENERAL FOUNDATION NOTES

1. ALL PILES SHALL BE PRESSURE-TREATED ROUND TIMBER PILES CONFORMING TO ASTM D25.
2. PILE LENGTH SHALL BE 30 FEET AND HAVE A 6" TIP DIAMETER AND 8" MINIMUM BUTT DIAMETER, MEASURED THREE FEET FROM THE BUTT.
3. PILE CAPACITY SHALL BE 5 TONS EACH, DRIVEN TO 25 FT. BELOW NATURAL GRADE OR REFUSAL. PRE DRILLING MAY BE REQUIRED. IF PREDRILLING IS PERFORMED, PREDRILL TO A MAXIMUM DEPTH OF 15 FT. USING A WET ROTARY DRILL WITH A BIT NO LARGER THAN 6 INCHES.
4. USE DROP HAMMER OR SINGLE ACTING AIR HAMMER DELIVERING 7,500 FT-LBS OF ENERGY PER BLOW. RAM WEIGHT OF DROP HAMMER SHALL NOT EXCEED 2,500 TO 3,000 LBS AND THE DROP SHOULD NOT EXCEED 3 FT., AT MINIMUM OF 25 BLOWS PER FOOT. IF THE DROP EXCEEDS 3 FT., CONTACT ENGINEER FOR INSTRUCTIONS.
5. TREAT ALL FIELD CUTS, HOLES OR OTHER PENETRATIONS INTO PILINGS IN ACCORDING TO AWPA M4, FIELD APPLIED WOOD PRESERVATIVE.
6. MARK EACH PILE WITH HORIZONTAL LINES AT 12 INCH INTERVALS, LABEL THE DISTANCE FROM PILE TIP AT 60 INCH INTERVALS.
7. CONTRACTOR SHALL NOTIFY THE ENGINEER AT LEAST 48 HOURS PRIOR TO PILE DRIVING SO THAT ENGINEER MAY OBSERVE PILE DRIVING.
8. CONTRACTOR SHALL PERFORM A STATIC LOAD TEST ON 10% OF DRIVEN PILES SELECTED BY ENGINEER. THESE TEST SHALL BE CONDUCTED IN ACCORDANCE WITH THE LATEST REVISION OF ASTM D1143, STANDARD TEST METHOD FOR PILES UNDER STATIC AXIAL COMPRESSIVE LOAD. CONTRACTOR SHALL SUBMIT NOTARIZED AFFIDAVIT TO THE ENGINEER UPON COMPLETION VERIFYING THAT ALL PILES HAVE BEEN DRIVEN PER PLANS AND SPECIFICATIONS.
9. PROVIDE AND MAINTAIN IMMEDIATE SITE DRAINAGE BEFORE, DURING AND AFTER CONSTRUCTION. PROVIDE GRADING, SWALES AND SUMP PUMPS AS MAY BE REQUIRED TO IMMEDIATELY DRAIN ALL RAIN WATER FROM THE CONSTRUCTION AREA. GOOD SURFACE DRAINAGE WITH POSITIVE COLLECTION AND RUNOFF AND SLOPES AWAY FROM THE CENTER OF THE BUILDING SHOULD BE ASSURED. AFTER PILES HAVE BEEN DRIVEN, PROVIDE A 6" HIGH POINT IN THE CENTER OF THE FOUNDATION SLOPING TO THE EDGE OF THE BUILDING. SUITABLE FILL SHALL BE FREE OF TRASH, LUMPS, HUMUS, PIECES OF WOOD OR ANY OTHER DELETERIOUS MATERIAL.

DAMMON ENGINEERING, INC.
LOUISIANA & MISSISSIPPI
www.dammonengineering.com
info@dammonengineering.com
PH: 985.649.5832
Chief Engineer: Brian Mistich, PE
534 Opelousas Trail
Slidell, LA 70458

#	DESCRIPTION	DATE
	AS BUILTS	10/6/2017

REVISIONS

SEAL:

LOUISIANA ARMY NATIONAL GUARD

CAMP VILLERE NEW HOME CONSTRUCTION

CAMP VILLERE, LOUISIANA — LA 14-A-037

JOB No: 2210 | DATE: OCTOBER 6, 2014
DRAWN BY: KJK | CHECKED BY: CKD

THIS DRAWING AND ALL OTHER DRAWINGS, SPECIFICATIONS, PLANS, REPORTS, MODELS, DATA, DOCUMENTS, AND ALL OTHER PROJECT INSTRUMENTS OF SERVICE ARE THE PROPERTY OF DAMMON ENGINEERING, AND MAY BE USED ONLY FOR THE PURPOSES AGREED TO BY DAMMON ENGINEERING. ANY OTHER USE OR REUSE BY ANY ENTITY OR FOR ANY OTHER PROJECT IS PROHIBITED. IT IS ASSUMED THAT ALL OF THE INFORMATION CONTAINED IN THE PROJECT INSTRUMENTS OF SERVICE HAS BEEN PREPARED AND DEVELOPED WITHIN THE STANDARD OF CARE EXERCISED BY PROFESSIONALS PERFORMING SIMILAR SERVICES AT THE TIME AND IN THE LOCALITY WHERE THE PROJECT IS LOCATED.

SHEET TITLE:
PILING PLAN - DETAILS AND NOTES

DRAWING NUMBER:
S1

SHEET No: 2 of 12