


- 007 (->)
- 008 (->)
- 009 (->)
- 010 (->)
- 011 (->)

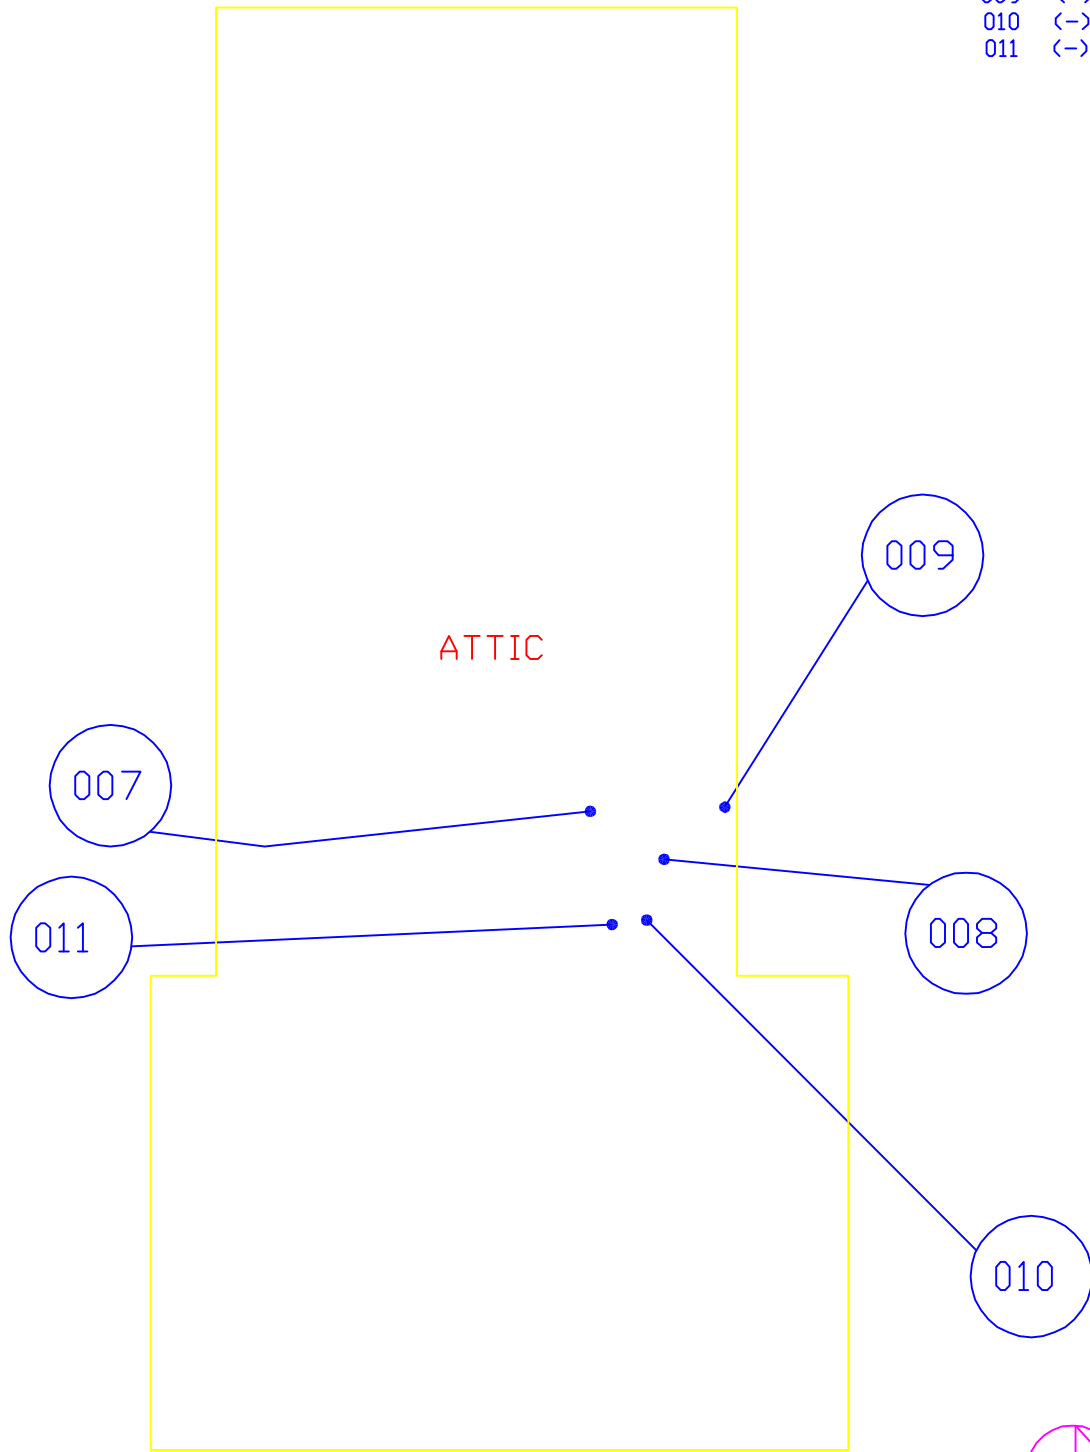

(FD) = FIRE DOORS

TROOP L HEADQUARTERS
 TROOP L HEADQUARTERS
 2600 N. CAUSEWAY BLVD
 MANDEVILLE, LA 70448

STATE I.D. #: 00814
 SITE CODE: 1-52-004
 APPROXIMATE SCALE: 1"=20'
 1 FLOOR OF 1 FLOOR
 FLOOR AREA: 9,649 SQ. FT.

