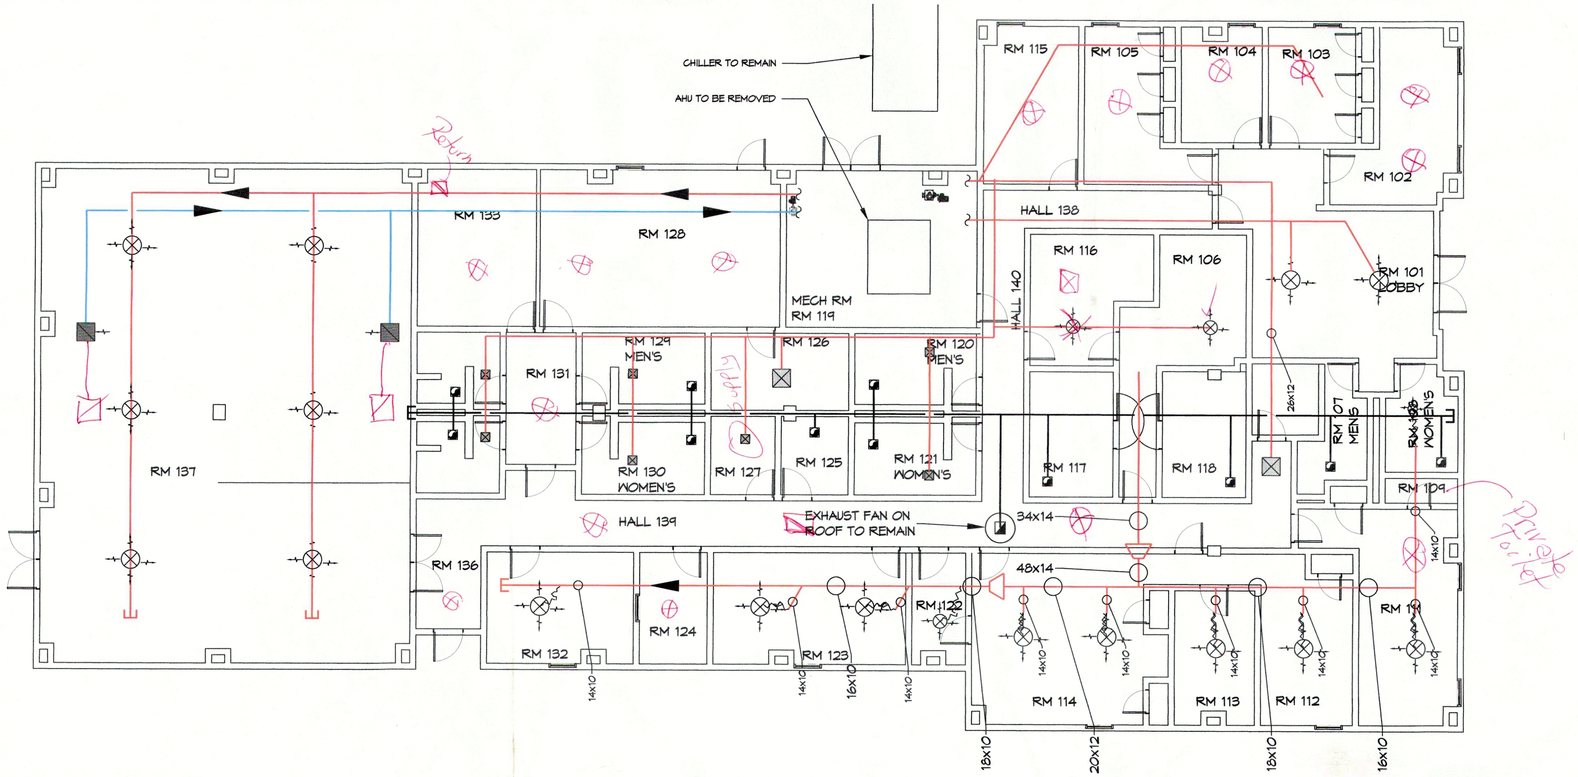

1 MECHANICAL DEMO PLAN
SCALE: 1/8" = 1'-0"

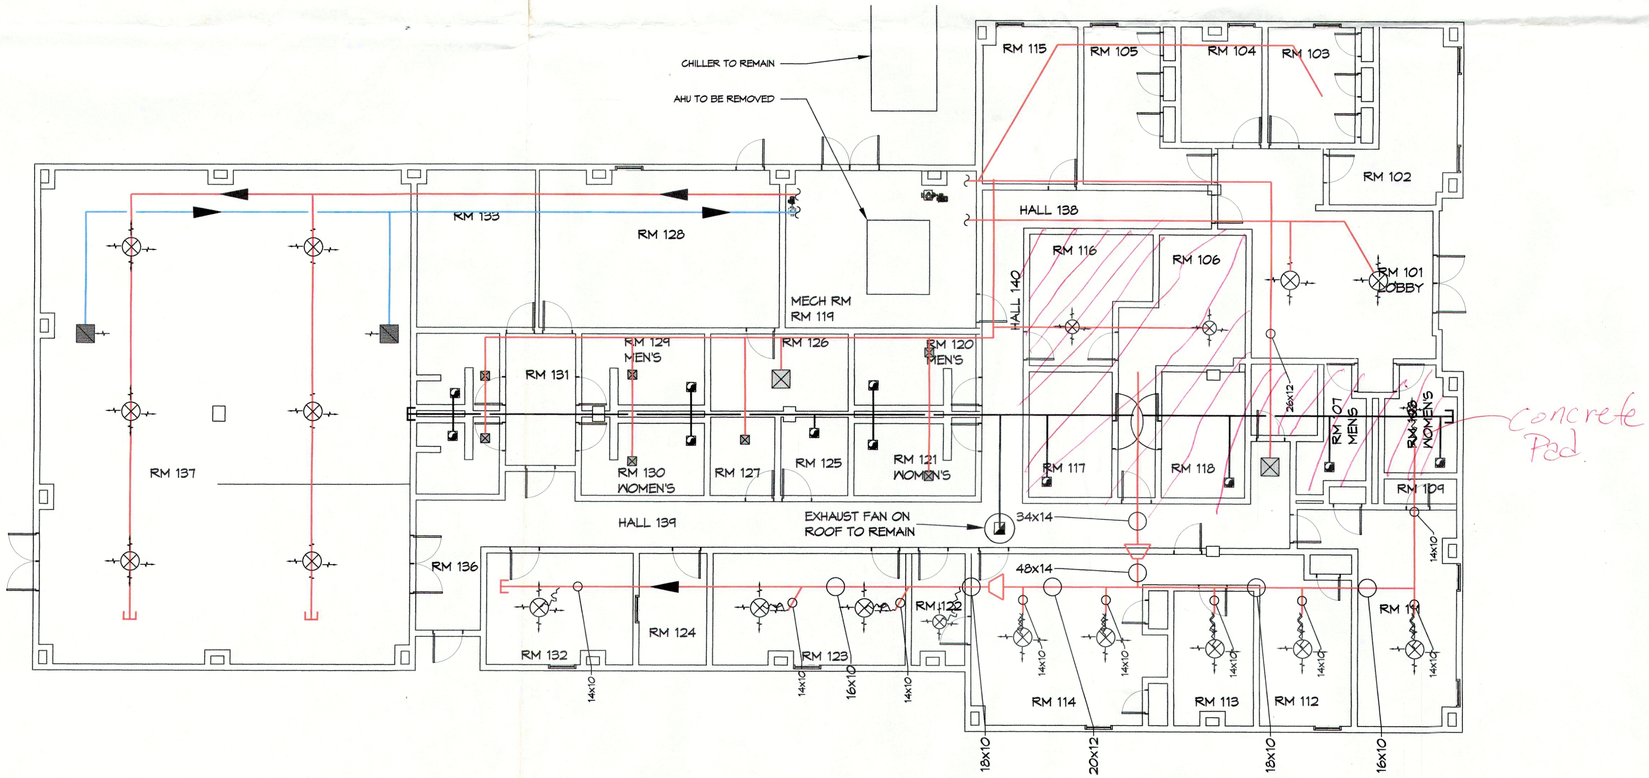

ZONES

GENERAL HVAC DETAIL NOTES

1. ALL MECHANICAL WORK SHALL BE COORDINATED WITH THE WORK OF OTHER TRADES.
2. VERIFY ROUTING OF ALL WORK ON SITE.
3. HVAC CONTRACTOR REPLACE ALL EQUIPMENT FILTERS AT THE TIME OF POSSESSION OF THE PROJECT BY THE OWNER, USING ONLY NEW FILTERS OF THE PROPER SIZE AND TYPE.
4. CONTRACTOR SHALL LEAVE THE HVAC SYSTEM IN PROPER WORKING ORDER AND SHALL GUARANTEE SAME FOR A PERIOD OF TWELVE (12) MONTHS FROM THE DATE OF SUBSTANTIAL COMPLETION.
5. WHERE MOUNTING HEIGHTS ARE NOT INDICATED OR DIMENSIONED, INSTALL MECHANICAL SERVICES AND OVERHEAD EQUIPMENT TO PROVIDE THE MAXIMUM HEADROOM POSSIBLE.

DAMMON ENGINEERING, INC.
LOUISIANA & MISSISSIPPI
www.dammonengineering.com
info@dammonengineering.com
PH: 985.649.5832
Chief Engineer: Brian Mistich, PE
5540 Crosswind Trail
Slidell, LA 70458

#	DESCRIPTION	DATE
	REVISIONS	

SEAL:

HVAC REPLACEMENT
STATE POLICE TROOP L
HEADQUARTERS

[PROJECT ADDRESS]

JOB No:	2372	DATE:	5/3/2019
DRAWN BY:	JASMN	CHECKED BY:	DD

The plans, specifications, and other documents, including but not limited to electronic documents, prepared by Dammon Engineering, Inc. are the property of Dammon Engineering, Inc. and are copyrighted. Such plans, specifications, and other documents are not to be used in whole or in part without the express written consent of Dammon Engineering, Inc. which has been prepared and developed without written consent of Dammon Engineering, Inc. shall be returned upon completion of the project for which they were prepared and developed.

SHEET TITLE:
MECHANICAL DEMO PLAN

DRAWING NUMBER:
MD101

SHEET No: 00 of #