FILE NAME: J:\C - Documents\1373 - Troop L Hdqs HVAC Renovation\Drawings\Current Drawings\M101 - Mechanical Zones.dgn PLOT DATE & TIME: Friday, April 26, 2019 9:05:06 AM

## GENERAL HVAC DETAIL NOTES

1. ALL MECHANICAL WORK SHALL BE COORDINATED WITH THE WORK OF OTHER TRADES.
2. VERIFY ROUTING OF ALL WORK ON SITE.
3. HVAC CONTRACTOR REPLACE ALL EQUIPMENT FILTERS AT THE TIME OF POSSESSION OF THE PROJECT BY THE OWNER, USING ONLY NEW FILTERS OF THE PROPER SIZE AND TYPE.
4. CONTRACTOR SHALL LEAVE THE HVAC SYSTEM IN PROPER WORKING ORDER AND SHALL GUARANTEE SAME FOR A PERIOD OF TWELVE (12) MONTHS FROM THE DATE OF SUBSTANTIAL COMPLETION.
5. PROVIDE A MINIMUM 4" THICK LEVEL PRE-CAST CONCRETE PAD FOR PACKAGED UNITS AT GRADE. THE SIZE OF THE PRE-CAST PAD WILL BE REQUIRED TO ACCOMMODATE THE FOOT PRINT OF THE UNIT AND BE ACCEPTABLE FOR MOUNTING.
6. WHERE MOUNTING HEIGHTS ARE NOT INDICATED OR DIMENSIONED, INSTALL MECHANICAL SERVICES AND OVERHEAD EQUIPMENT TO PROVIDE THE MAXIMUM HEADROOM POSSIBLE.

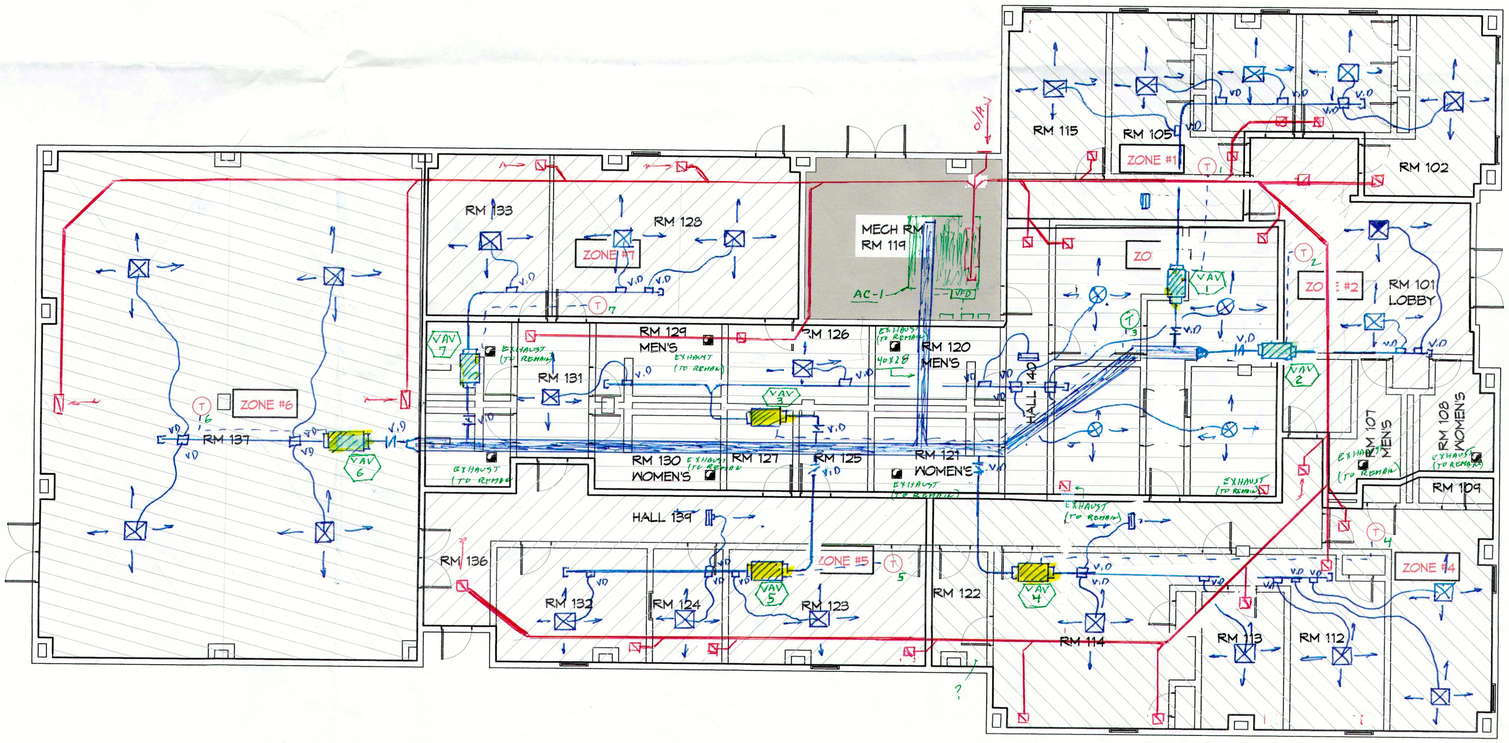


Show outline of concrete pad?

1 MECHANICAL ZONES PLAN
SCALE: 1/8" = 1'-0"

DAMMON ENGINEERING, INC.
LOUISIANA & MISSISSIPPI
www.dammoneng.com
Chief Engineer: Brian Mistich, PE
554 Old Spanish Trail

REVISIONS

| # | DESCRIPTION | DATE |
|---|---|---|

SEAL:

HVAC REPLACEMENT
STATE POLICE TROOP L HEADQUARTERS
[PROJECT ADDRESS]

JOB No: 2372 DATE: [DATE]

SHEET TITLE: MECHANICAL ZONES PLAN

DRAWING NUMBER: M101

SHEET No: 00 of #