




FORTH STREET

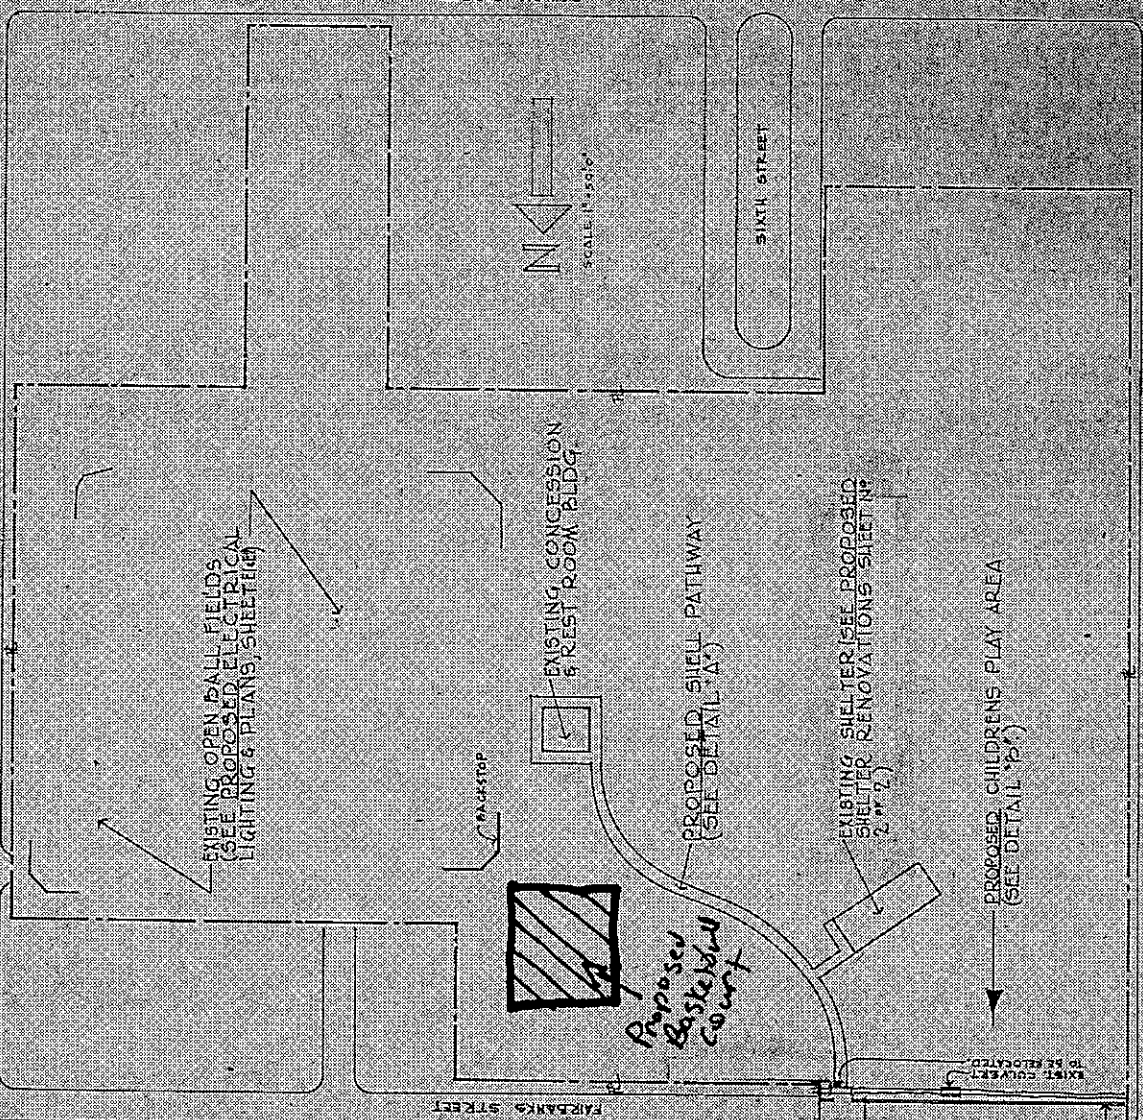







