

CHANGE WORK ORDER

City of Slidell Parking Lot & Courtyard
Slidell, LA

RE: Fountain addition

ATTN: Chuck Dammon

Contractor : Saucier Const. Co. Inc.
39159 Y Bar Y Rd.
Pearl River, LA 70452

1. The Owner authorizes and the Contractor agrees to make the following work changes to the Fountain.

Build the fountain pool for City Hall Parking Lot and Courtyard as modified at meeting. The pool will have 2 skimmers, 2 return lines, 5 bubbler fountains with 3 LED lights each. The pool interior will be plastered with white plaster. The interior waterline to be faced with pool tile and all top surfaces covered with coordinating brick coping. A fountain wall approximately 12' long and 2' high faced with tile and including 4 ea. 12" x 12" "Logo" tiles and a 24" waterfall as per drawing. Each pair of "Logo" tiles will have one LED light to illuminate the wall. Overflow and water level control to be in the remaining corner. Outside vertical surface to be Stucco, color to be chosen.

The fountain equipment to consist of an upgrade to one energy efficient pump, Cartridge filter, Auto Chlorinator and Dual Timer (one for lights, one for pump), 1 control valve for each bubbler and the waterfall (6ea.), all to be installed in the "water sprinkler" room in the adjacent building.


Electric service to the equipment area to be supplied by the City of Slidell.

Total cost for the upgrade is: \$5300.00

Dated: 1/12/2014


City of Slidell


Saucier Const. Co., Inc.

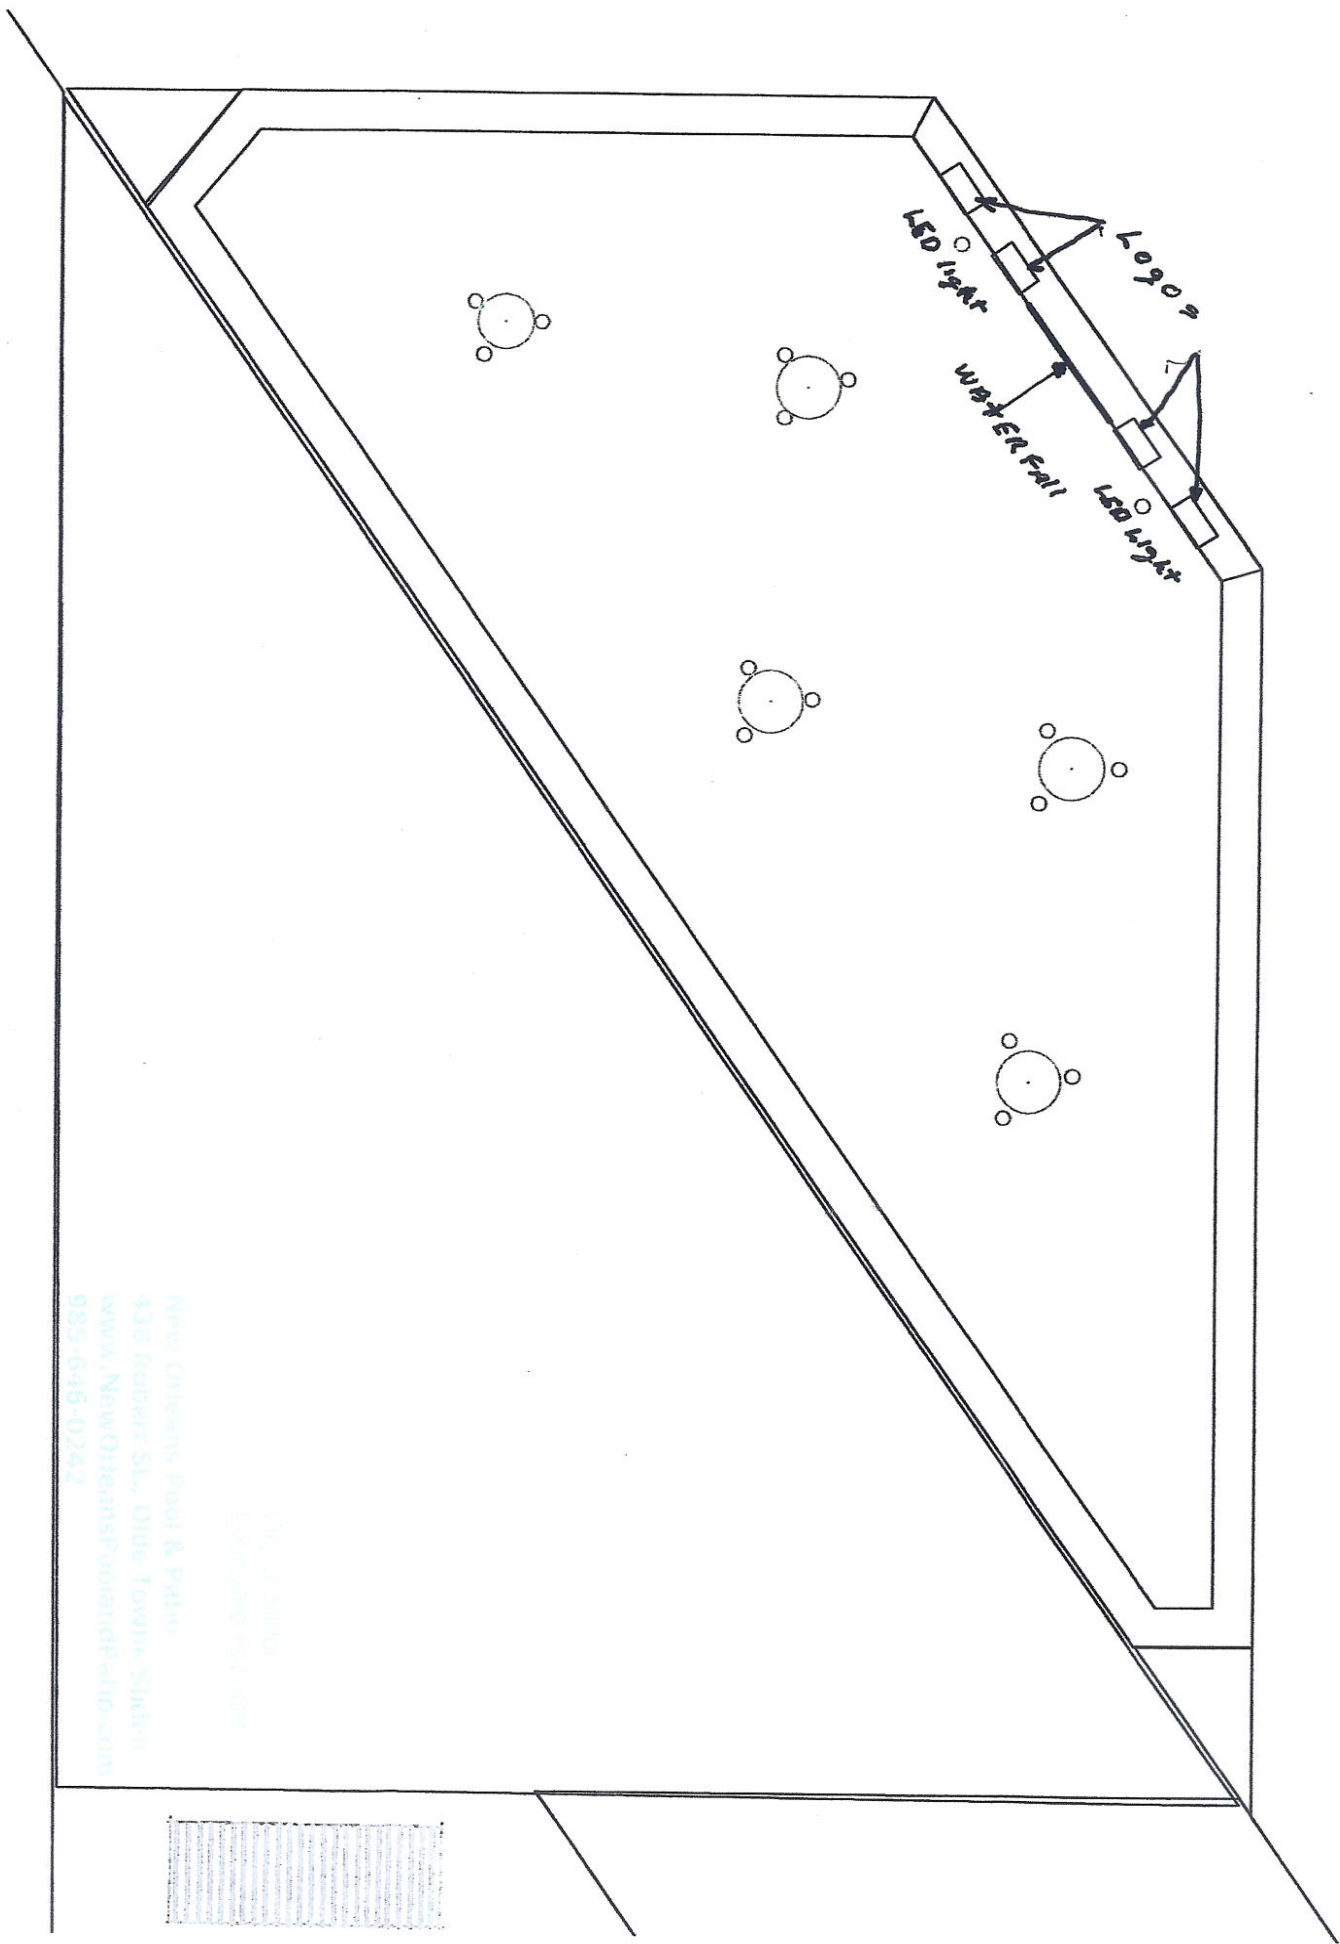

New Orleans Pool & Patio
 438 Robert St., Old Town - Slidell
 www.NewOrleansPoolandPatio.com
 985-646-0242

City of Slidell
 Engineering Department

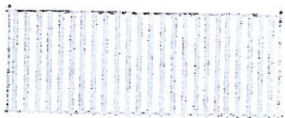

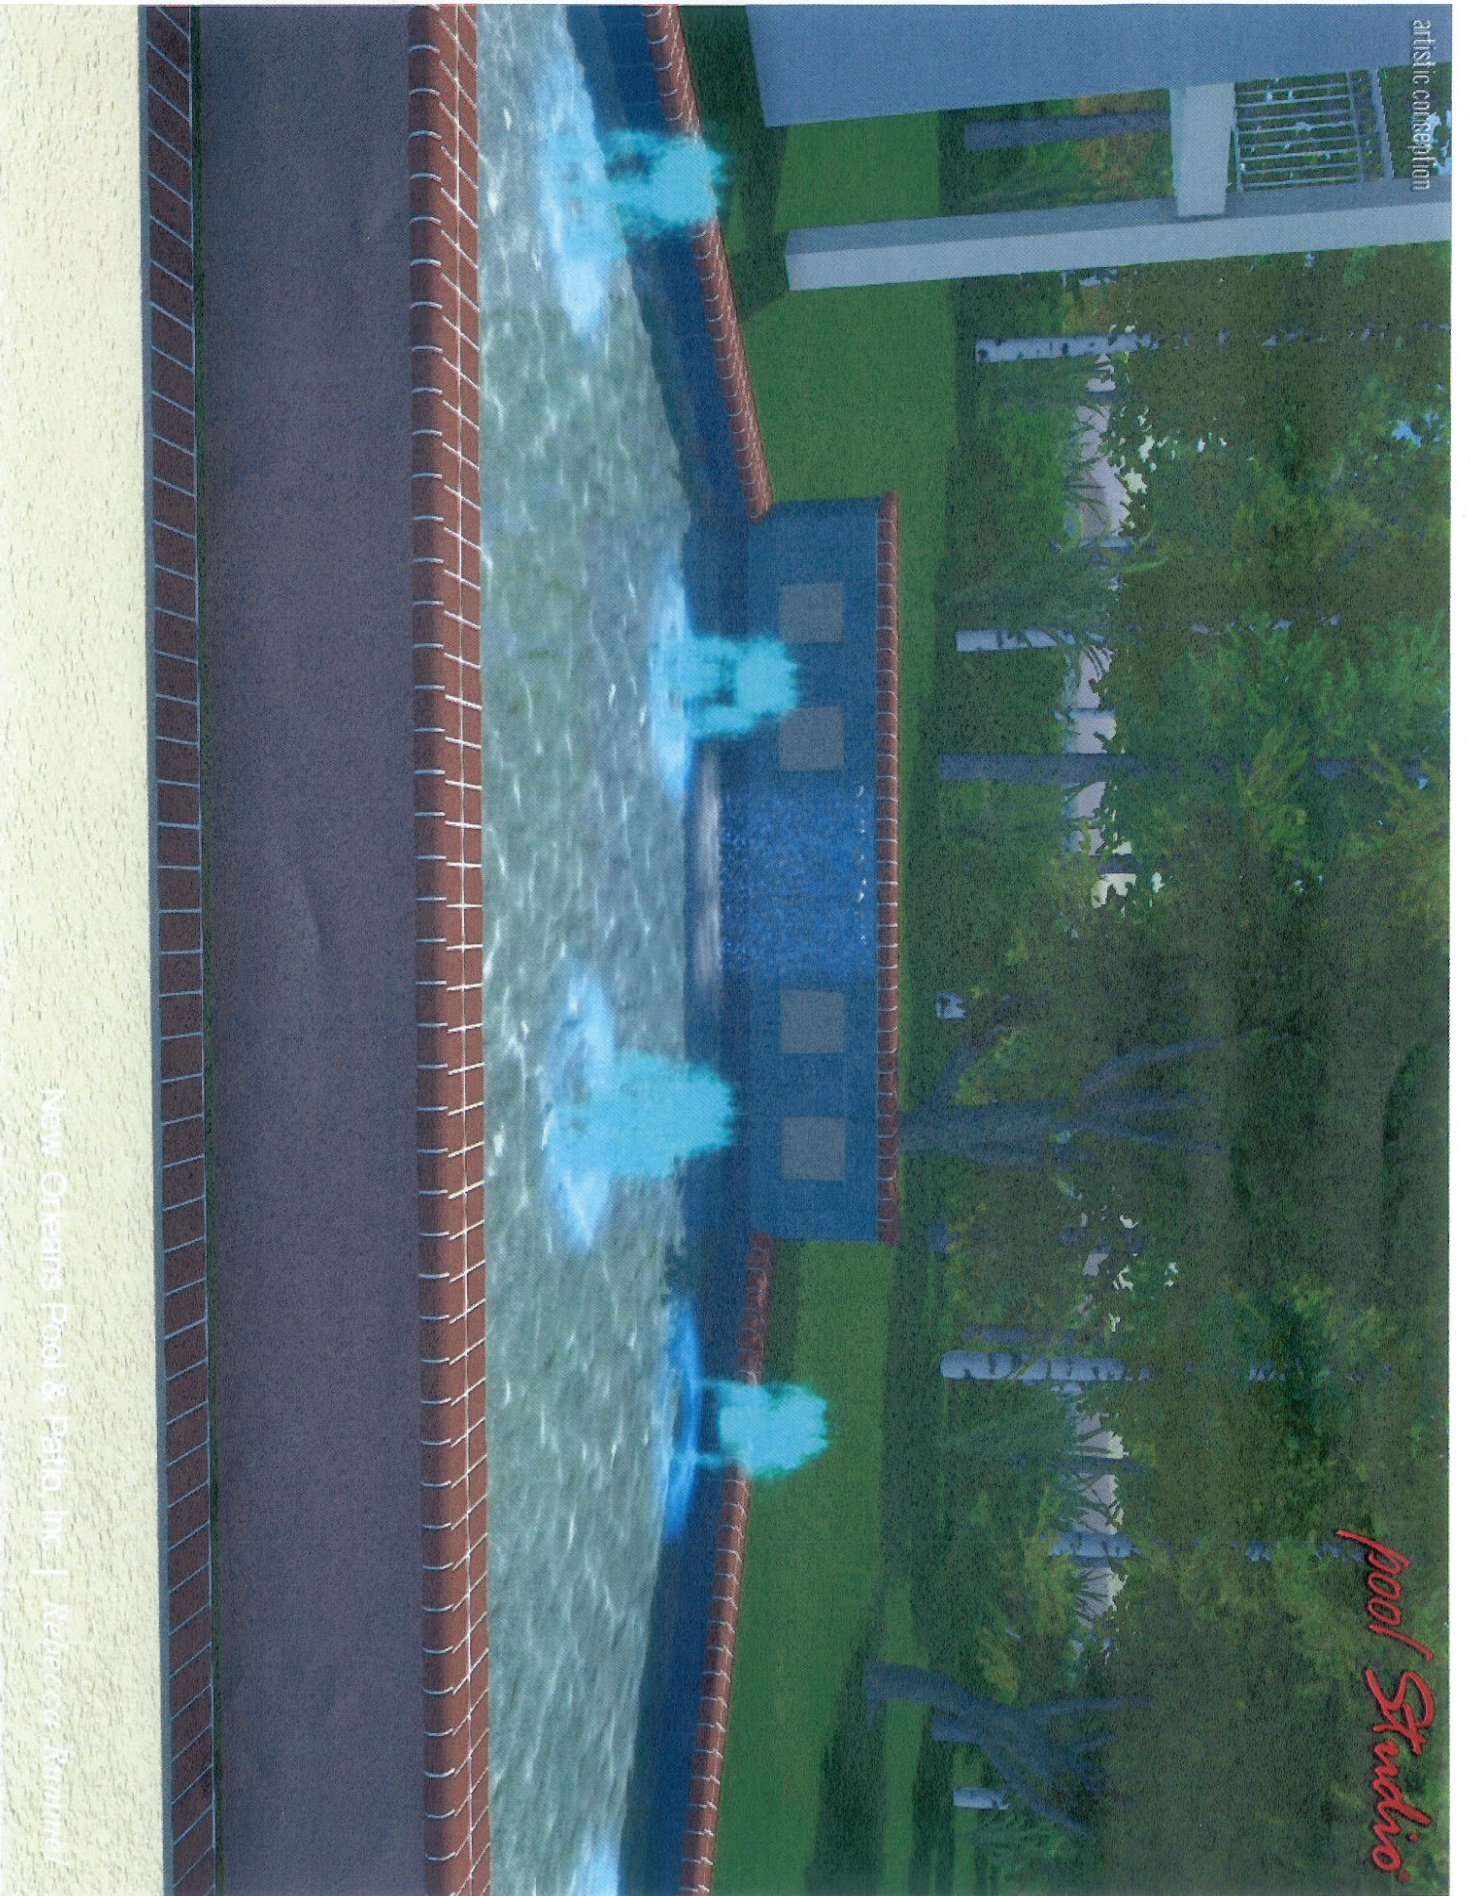


Pool Studio

New Orleans Pool & Patio, Inc. | 713-666-8888

artistic conception

Pool Studios

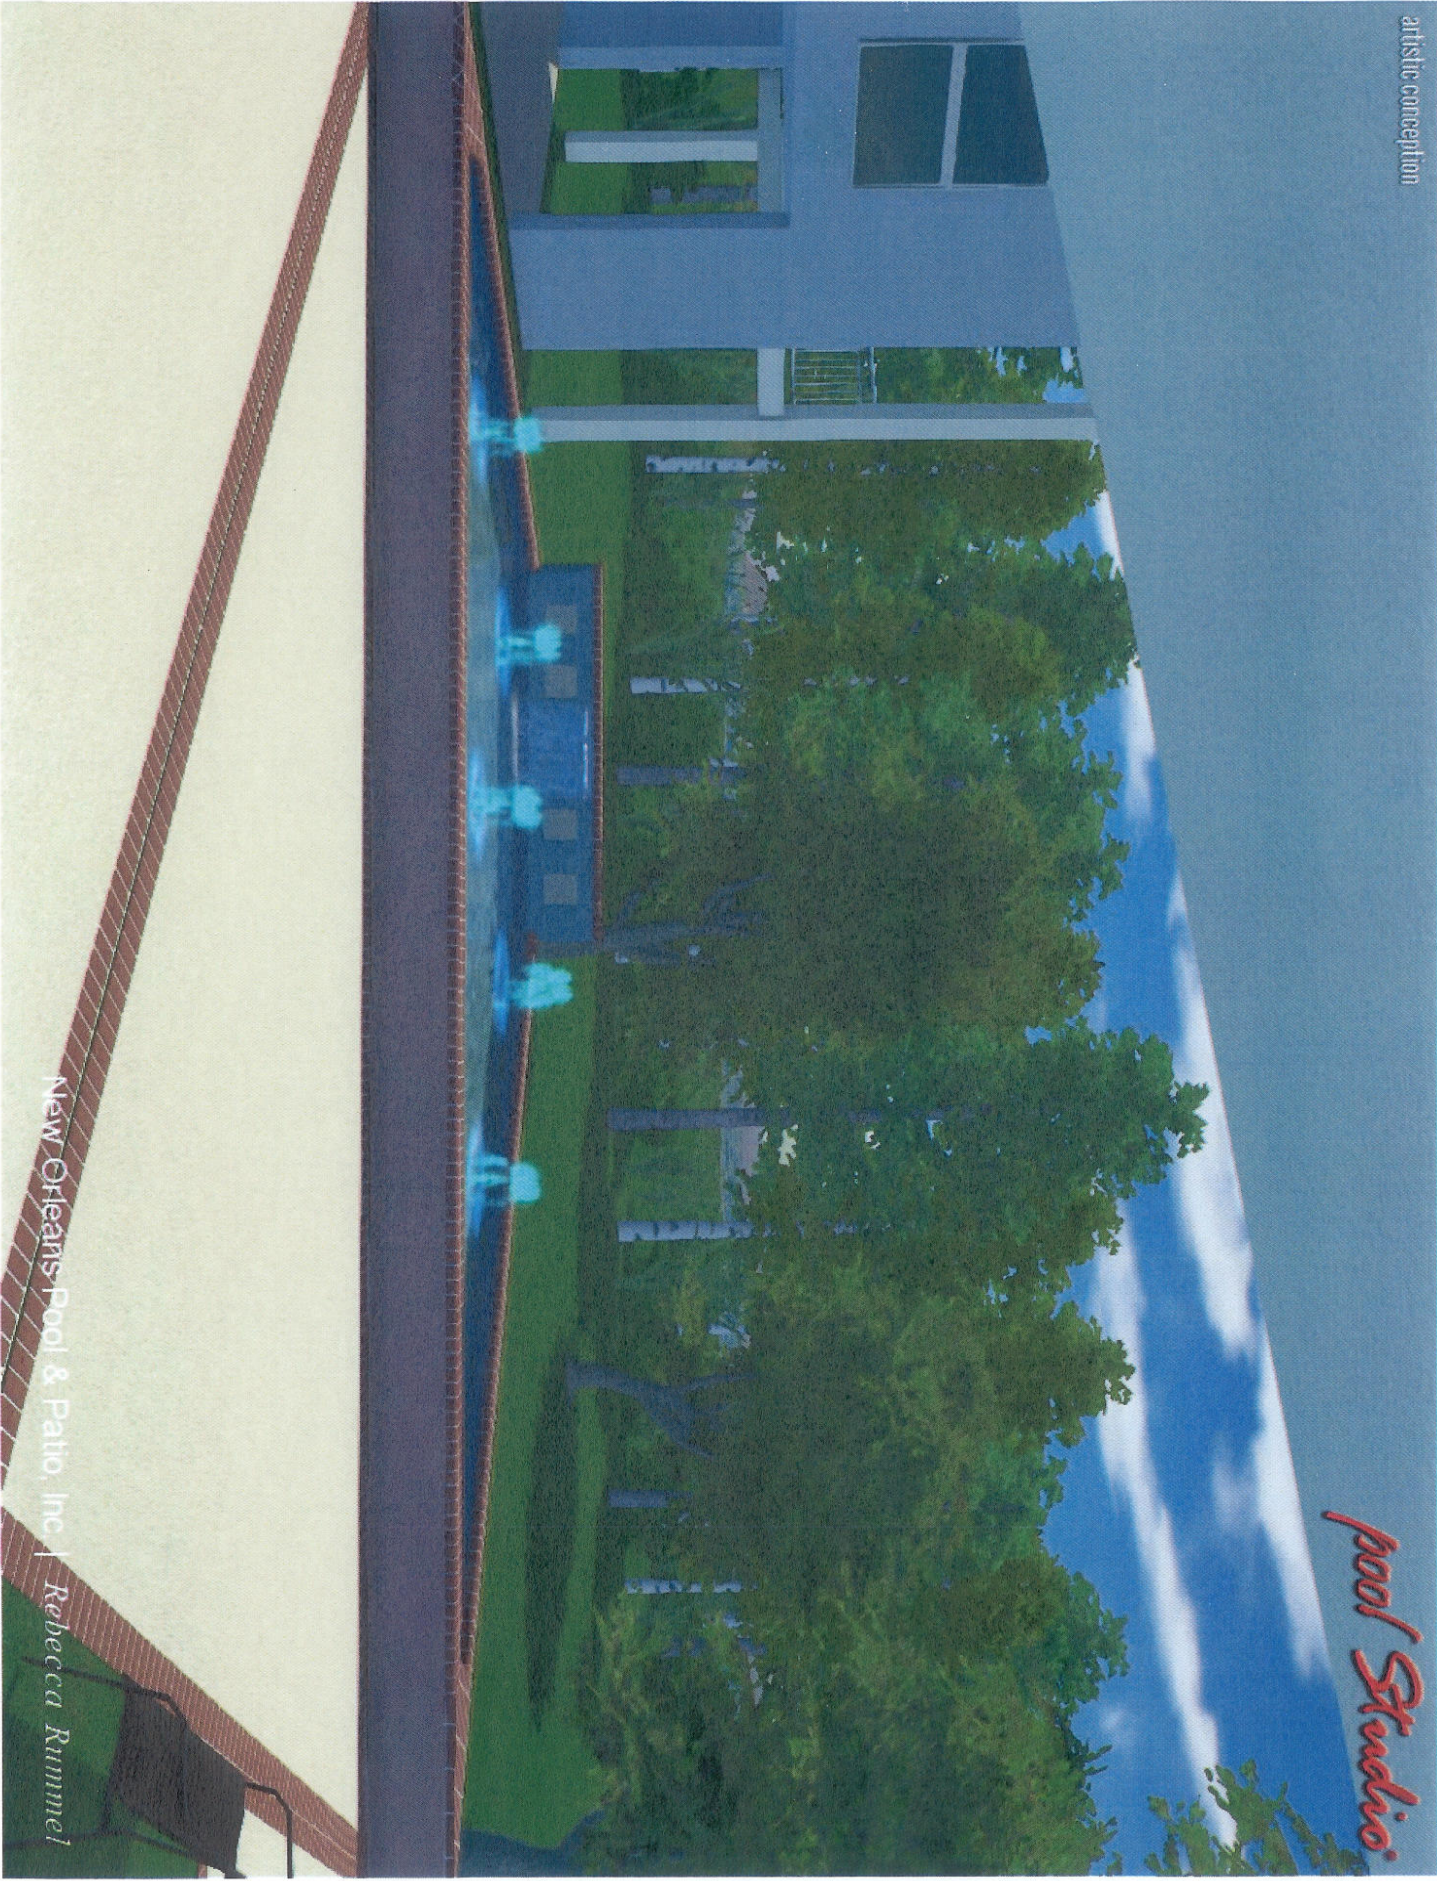

New Orleans Pool & Patio, Inc | Rebecca Rummel