


DHHS Furniture Placement Proposal

Dated 04/27/2016

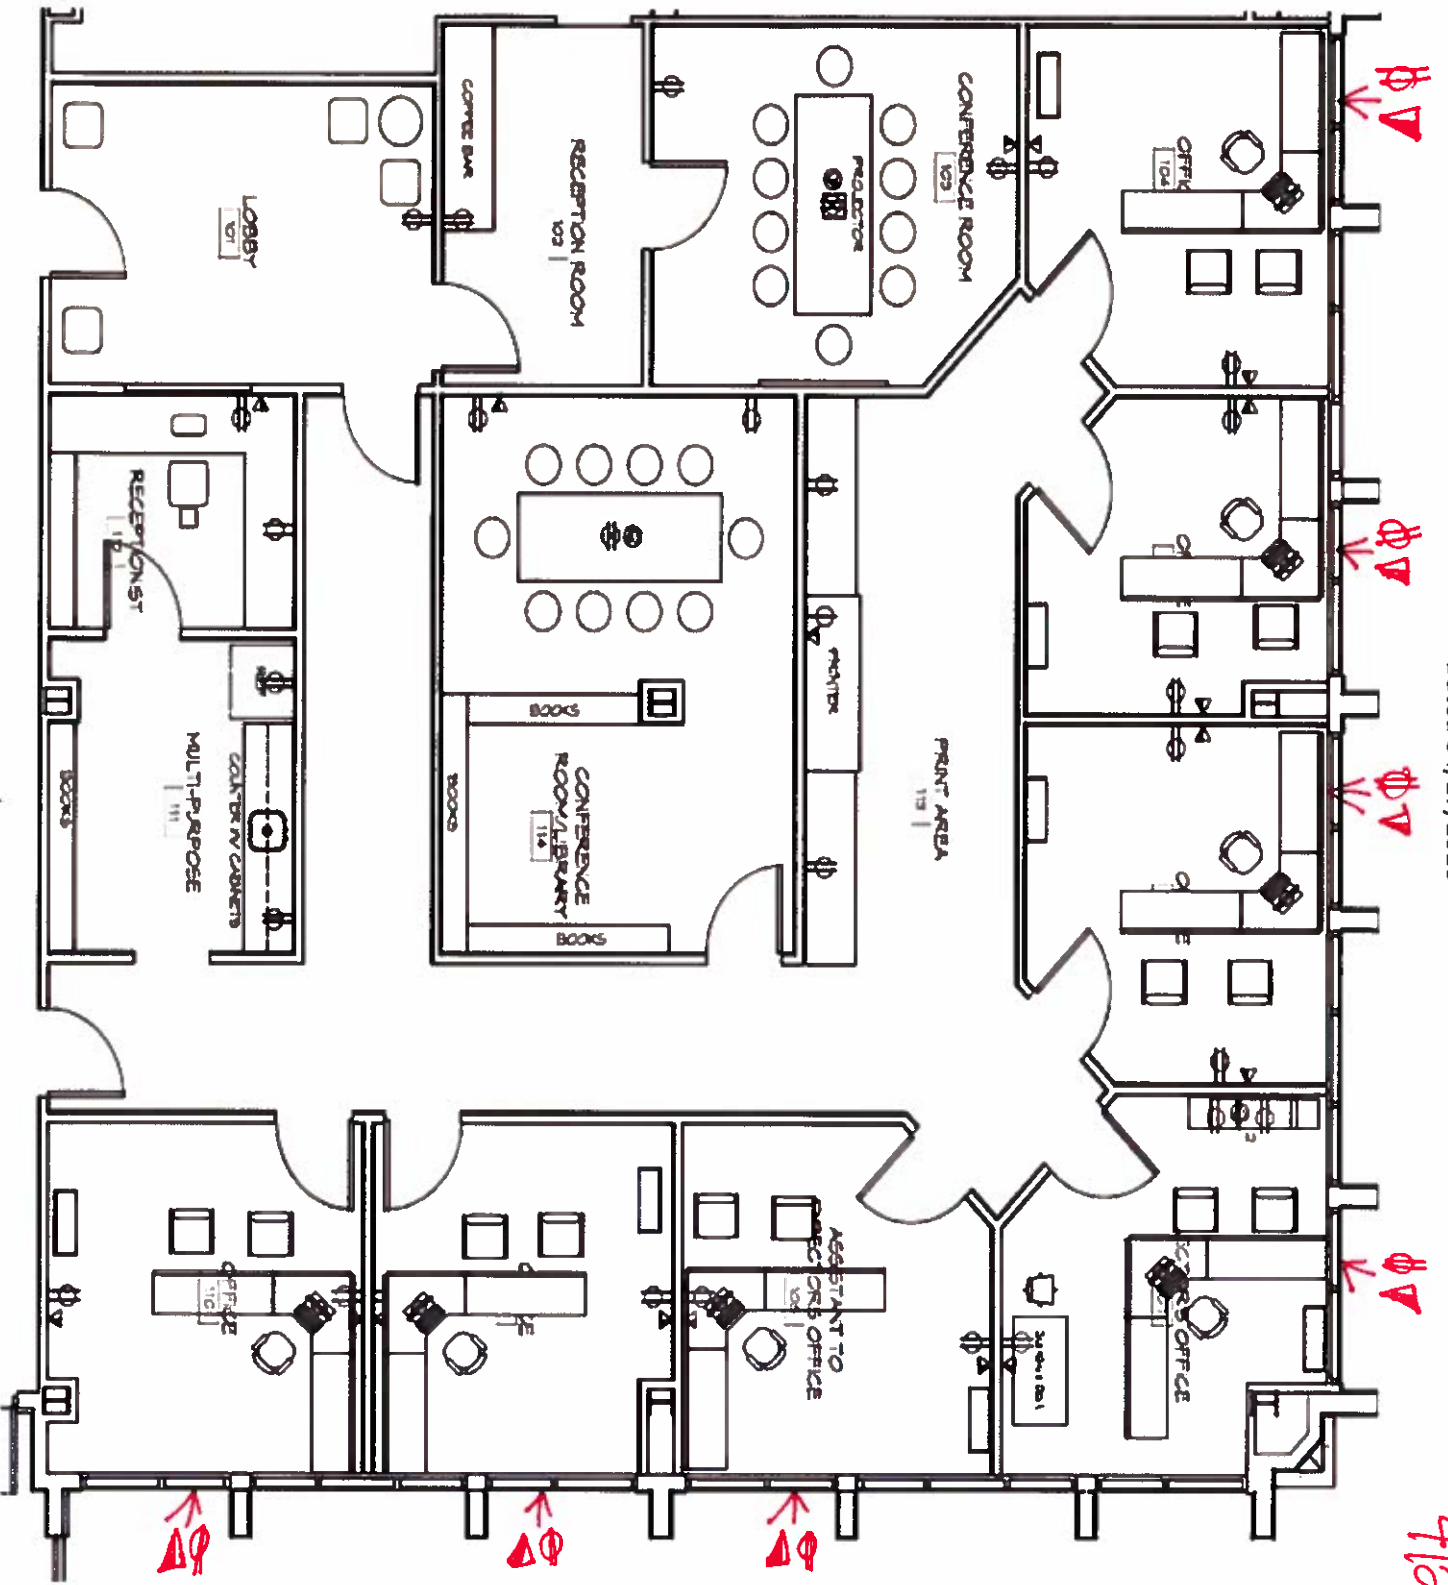

R
4/27/2016