



SGT. ALFRED DRIVE

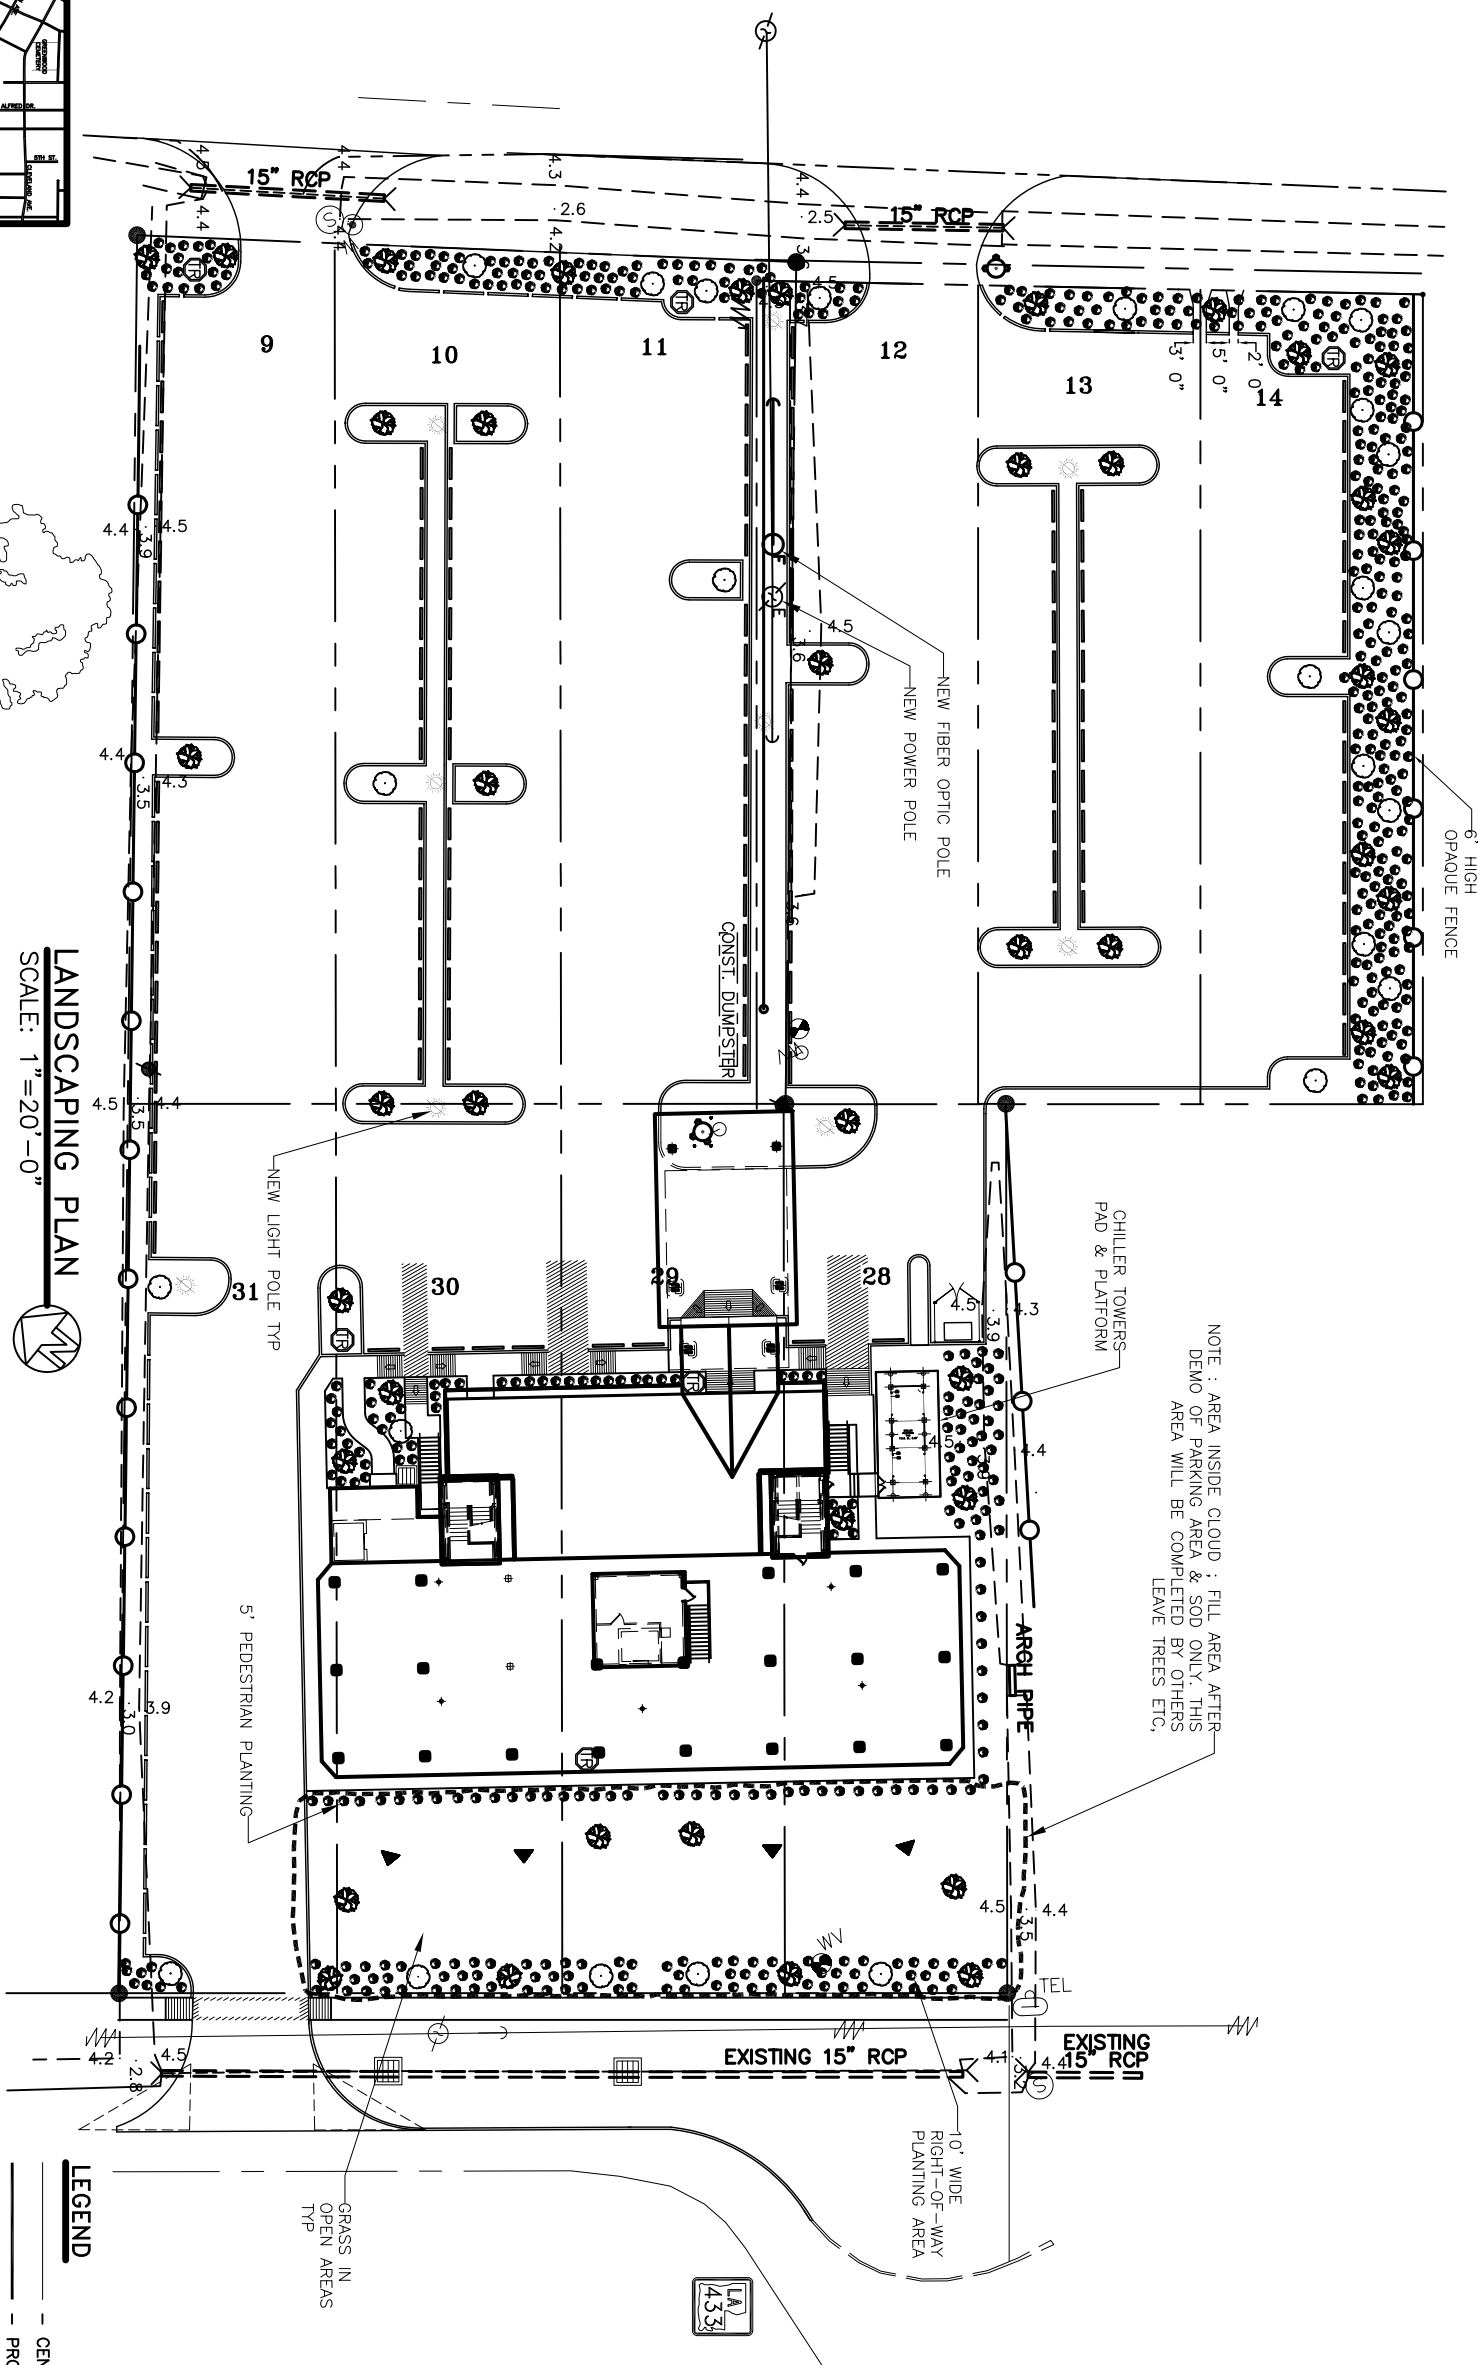


NOTE: AREA INSIDE CLOUD: FILL AREA AFTER DEMO OF PARKING AREA & SOD ONLY. THIS AREA WILL BE COMPLETED BY OTHERS LEAVE TREES ETC.


NOTE: PROVIDE SERVICES OF LAWN SPRINKLER CO. TO DESIGN & INSTALL LAWN SPRINKLER SYSTEM FOR ENTIRE SITE, EXCLUDING DITCH AREAS.

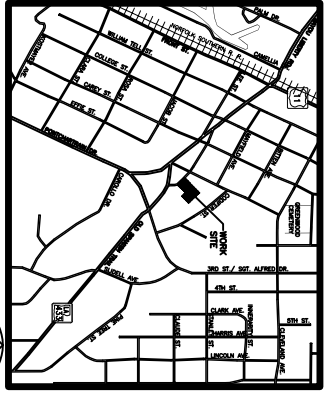


VICINITY MAP

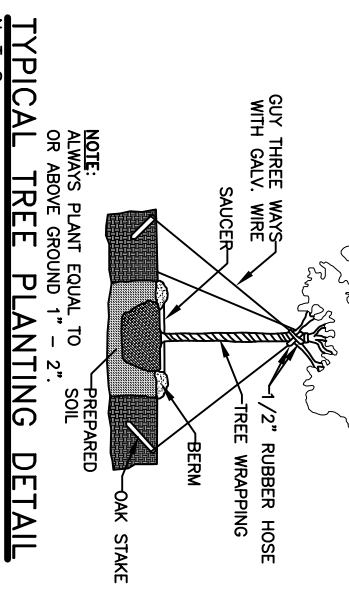

TYPICAL TREE PLANTING DETAIL

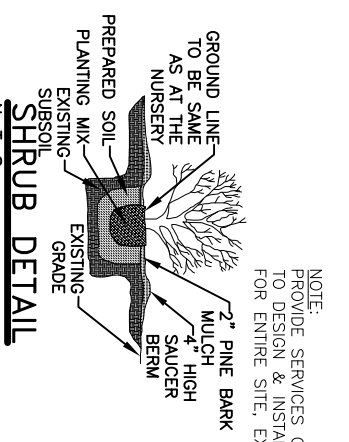

SHRUB DETAIL

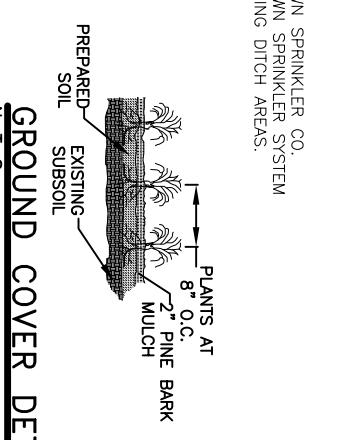

GROUND COVER DETAIL

LANDSCAPING PLAN
SCALE: 1"=20'-0"

LEGEND

- CENTERLINE OF ROAD
- PROPERTY LINE
- NEW BUILDING
- EXISTING FENCE LINE
- SETBACK LINE
- GRAPE MYRTLE
- SHUMARD OAK
- LARGE CAMELLIA
- HORN BEAM
- SHRUB
- SEASONAL COLOR BED
- SHRUB BED
- GRASS IN OPEN AREAS TYP
- 10' WIDE RIGHT-OF-WAY PLANTING AREA
- TEL
- ARCH PIPE
- CHILLER TOWERS PAD & PLATFORM
- NEW LIGHT POLE TYP
- 5' PEDESTRIAN PLANTING
- CONST. DUMPSTER
- NEW FIBER OPTIC POLE
- NEW POWER POLE
- 6' HIGH OPAQUE FENCE

REVISED: 02/19/07

OF 1 SHEET

JOB NO. 1729

DATE: 1-8-07

SCALE: 1"=20'

FILE:

RENOVATE OFFICE BUILDING

DAMMON ENGINEERING, INC.

1095 FLORIDA AVENUE 985-649-5832 SLIDELL, LA. 70458

DAMMONENGINEERING.COM

LANDSCAPING PLAN

ST. TAMMANY PARISH OFFICE BUILDING
520 OLD SPANISH TRAIL
SLIDELL, LOUISIANA