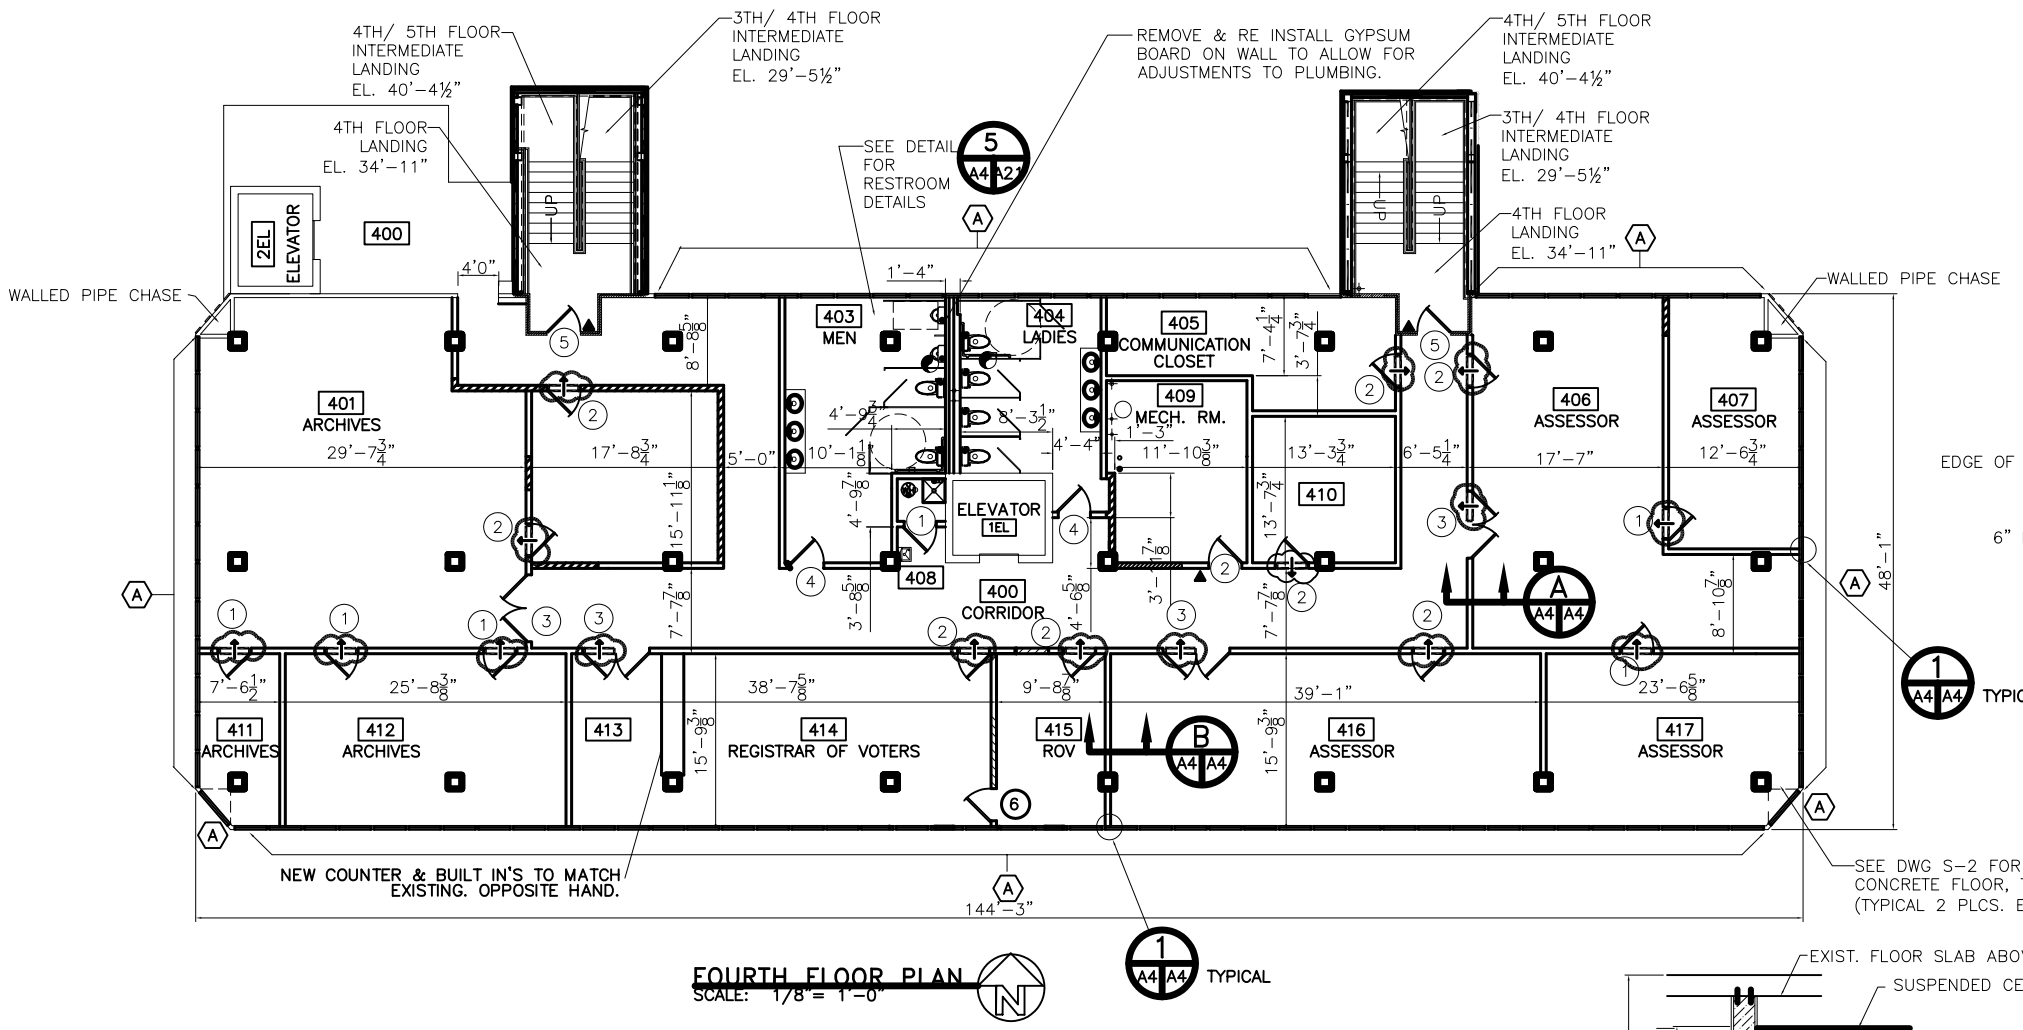

FOURTH FLOOR PLAN
SCALE: 1/8" = 1'-0"

LEGEND

- NEW WALL –
- NEW 1 HOUR – RATED WALL
- EXISTING WALL –
- CURTAIN WALL –
- SECURITY ACCESS DOOR – (SCANNER BY OTHERS) ▲
- RETURN AIR CASED OPENING IN WALL – (ROOM TO CEILING)

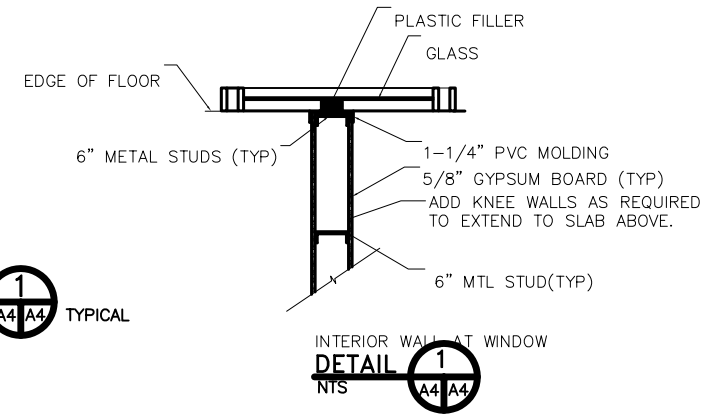

INTERIOR WALL AT WINDOW DETAIL 1 A4 A4
NTS

FINISH SCHEDULE

ROOM	FLOOR: CONCRETE	VINYL TILE	CARPET	CERAMIC TILE	PAINTED WOOD	BASE: VINYL	WOOD	NONE	WALLS: GYPSUM BOARD	GREENBOARD	CERAMIC TILE	PAINT	CEILING: ACOUSTIC TILE	GYPSUM BOARD	FRP BOARD	OPEN	TEXT. CONC.	CLG HT	REMARKS
400		●				●			●			●	●					8'-6"	
401		●				●			●			●	●					9'-0"	
402			●			●			●			●	●					9'-0"	
403				●		●				●	●	●	●					9'-0"	
404				●		●				●	●	●	●					9'-0"	
405		●				●			●			●	●					9'-0"	
406			●			●			●			●	●					9'-0"	
407			●			●			●			●	●					9'-0"	
408		●				●				●		●	●					9'-0"	
409	●							●				●				●		10'-4"	
410			●			●			●			●	●					9'-0"	
411			●			●			●			●	●					9'-0"	
412			●			●			●			●	●					9'-0"	
413			●			●			●			●	●					9'-0"	
414			●			●			●			●	●					9'-0"	
415			●			●			●			●	●					9'-0"	
416			●			●			●			●	●					9'-0"	
417			●			●			●			●	●					9'-0"	

UNDERCUT ALL DOORS 3/4" TO ALL FOR PROPER EXHAUST AIR FLOW

DOOR & HARDWARE SCHEDULE

○ DOOR	TYPE: SOLID WOOD	HOLLOW	ALUM./GLASS	STEEL	MASONITE	FRAME: STEEL	ALUMINUM	WOOD	CASED OPENING	HINGE: DOUBLE SWING	BUTT 1 1/2 PR	BURGLARPROOF	SLIDING	MAGNETIC	LOCK: DEADBOLT	KEYED HANDLE	PUSH PULL	ACCESSORIES: PANIC	THRESHOLD	WEATHERSTRIP	DOOR STOP	CLOSER	WIRED GLASS	VIEW GLASS	REMARKS
1	3/0x7/0																								EXISTING TO REMAIN –REFINISH
2	3/0x7/0	●				●					●					●					●	●			
3	(2)3/0x7/0																								EXISTING–REHANG AS REQUIRED FOR FIT
4	3/0x7/0	●				●					●						●				●	●			
5	3/0x7/0	●				●					●					●		●			●	●			1 HOUR RATED
6	3/0x7/0	●				●					●					●					●				

DOORS SHOWN WITH ▲ SHALL BE EQUIPPED WITH ELECTRIC STRIKE FOR CARD READER

WINDOW SCHEDULE

○ WINDOW	TYPE: FIXED	VERTICAL SLIDE	HORIZ SLIDE	STORE FRONT	FRAME: STEEL	ALUMINUM	WOOD	GLASS: TINTED	PLAIN	GLAZED	WIREGLASS	LITES: NONE	2/2	4/4	6/6	8/8	ACCESSORIES: ALARM	SCREEN	SHUTTER	NONE	REMARKS
A	*4/0x5/0	●				●						●								●	APPROXIMATELY 3,700 SQ. FT.

*FINAL SIZES TO BE DETERMINED BY VENDOR FROM FIELD MEASUREMENTS [TYP. ALL FLOORS]

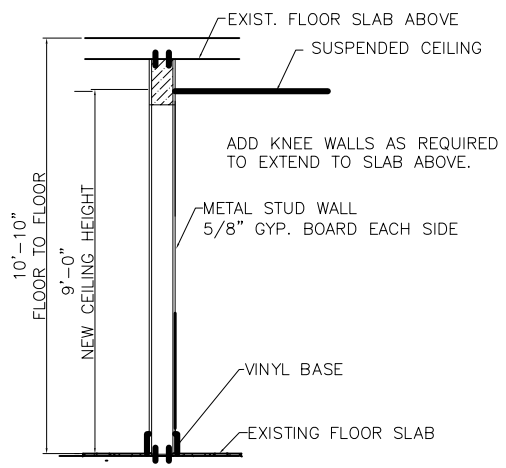

SECTION B A4 A4
NTS

TYPICAL ONLY WHERE WALL IS NOT 9 FT HIGH

ALTERNATE BID #2

HVAC FAN COIL UNITS
IN LIEU OF VAV SYSTEM

NOTES:

1. ONLY WORK PERTAINING TO HVAC SYSTEM IS PART OF ALTERNATE #2. ALL OTHER WORK IS PART OF BASE BID. ARCHITECTURAL WORK NOT PERTAINING TO ALTERNATE #2 IS SHOWN AS:

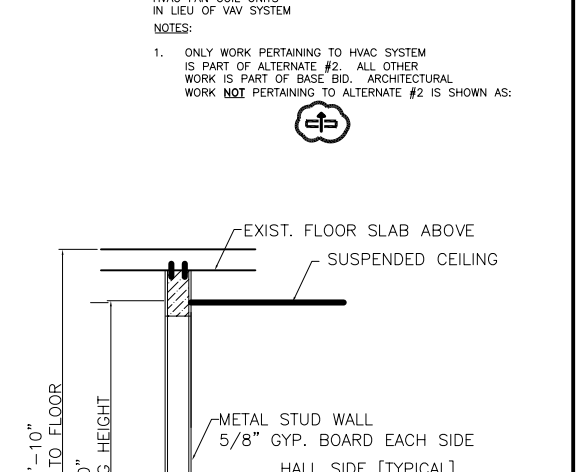

SECTION A A4 A4
NTS

TYPICAL ONLY WHERE WALL IS NOT 9 FT HIGH

REVISED: 05/17/07ab
REVISED: 04/11/07ab
REVISED: 02/19/07
REVISED: 01/23/07

4TH FLOOR RENOVATE PLAN

ST. TAMMANY PARISH ADMIN. COMPLEX
520 OLD SPANISH TRAIL
SLIDELL, LOUISIANA

RENOVATE OFFICE BUILDING

DAMMON ENGINEERING. INC.
1095 FLORIDA AVENUE 985-649-5832 SLIDELL, LA. 70458
DAMMONENGINEERING.COM

SCALE:AS NOTED
FILE:
JOB NO. 1729
DATE:1-8-07
SHEET
A-4
OF