


## CONSTRUCTION JOINT
N. T. S.

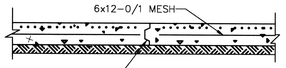


## CONTRACTION JOINT
N. T. S.




## TYPICAL CURB DETAIL
N. T. S.

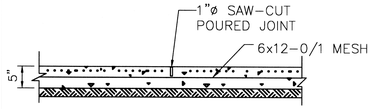


## DRIVEWAY SECTION
N. T. S.

NOTE:
DRIVEWAY IN CITY RIGHT OF WAY SHALL BE 6" THICK REIFNFOCED CONCRETE.

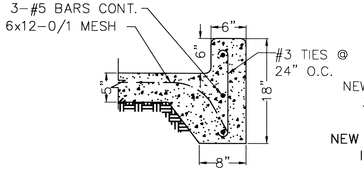


## DRAINABLE CURB DETAIL
N. T. S.

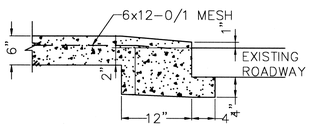


## PAVING PLAN
SCALE: 1"=20'-0"

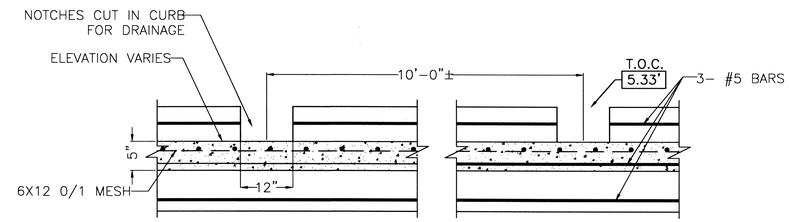


## VICINITY MAP
N. T. S.

NOTE:
VERIFY LOCATIONS OF ALL UNDER GROUND UTILITIES

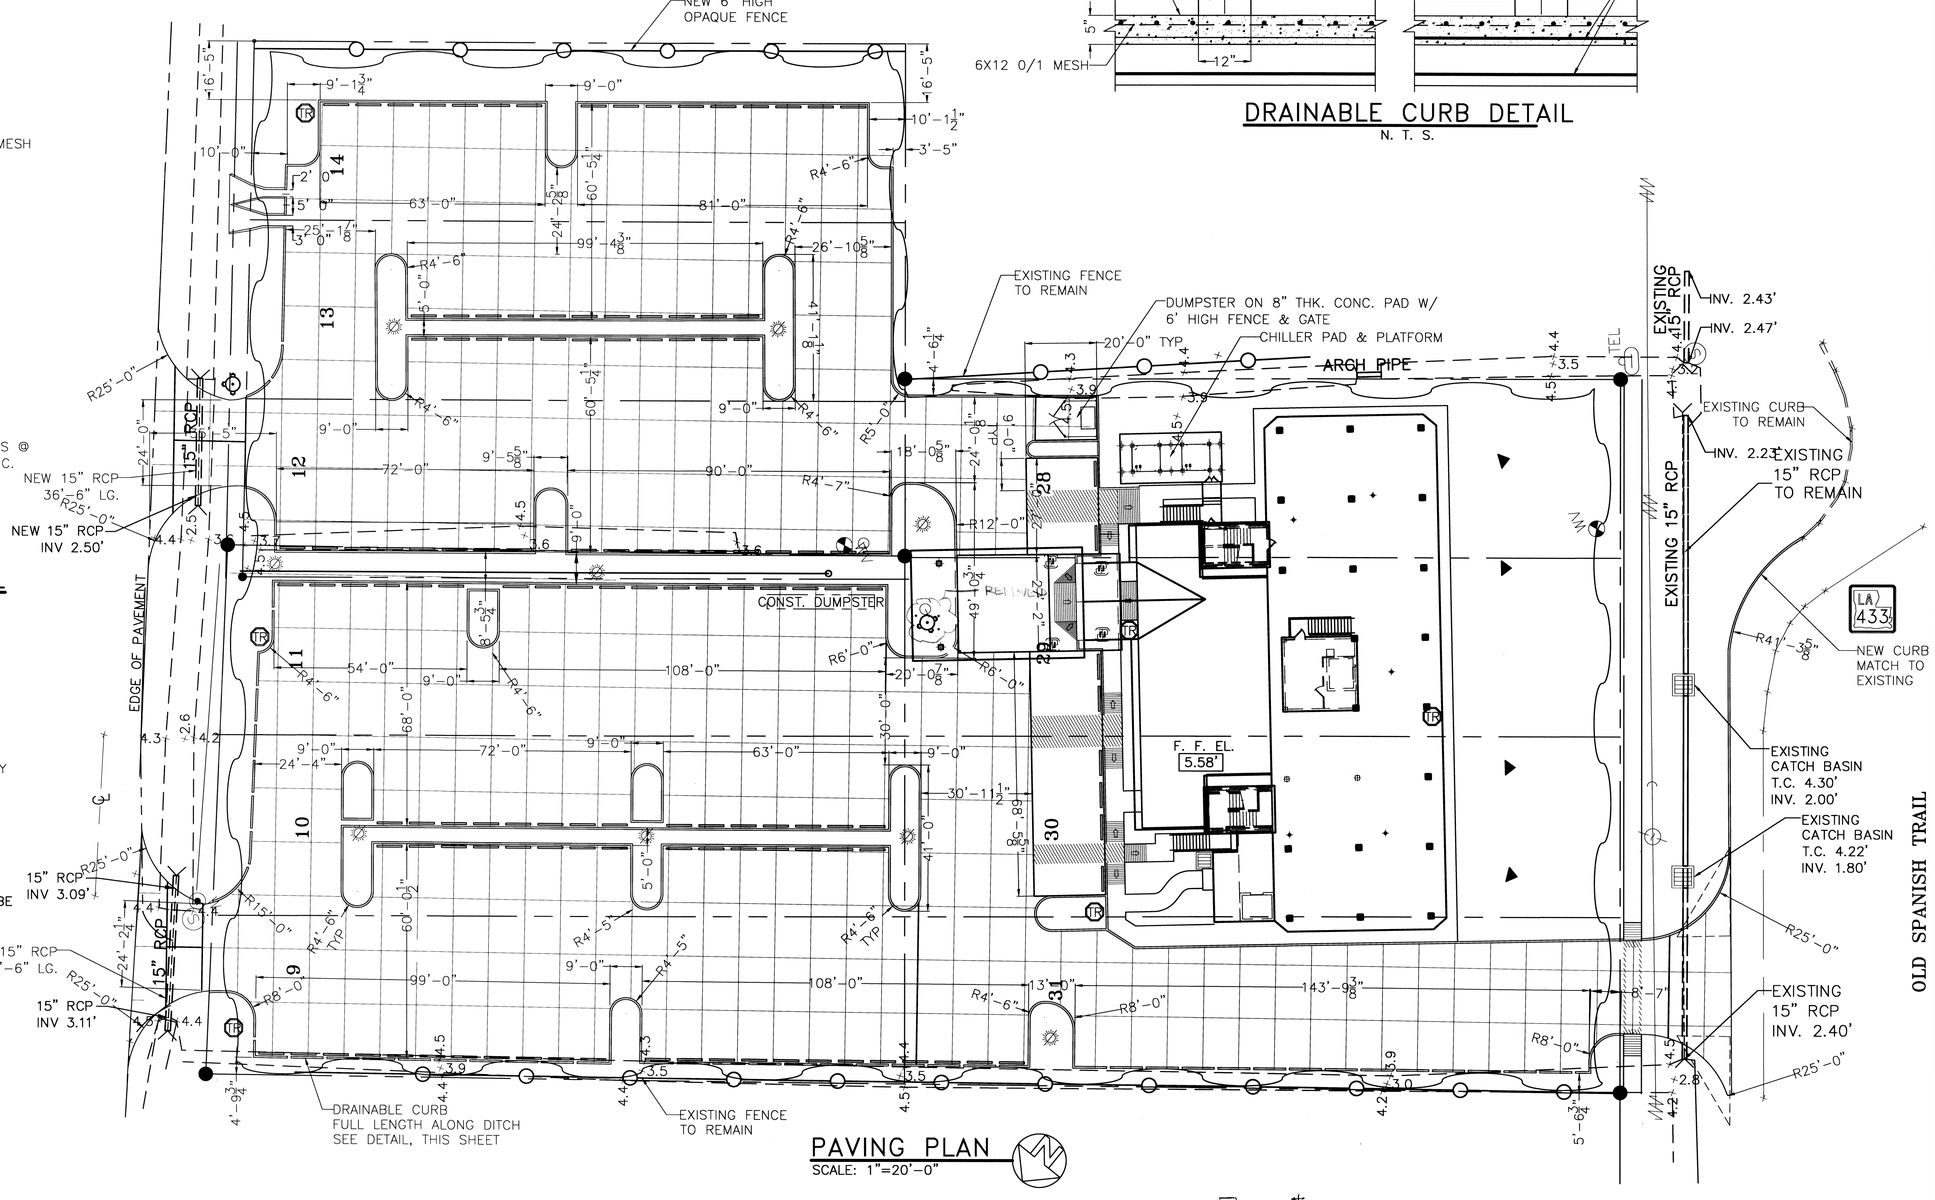SILT FENCE DRAWN DIAGRAMMATICALLY AND SHALL BE CONSTRUCTED INSIDE PROPERTY LINE.

☐ RFI #
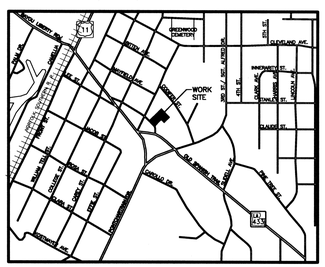
## LEGEND

- PROPERTY LINE
- SETBACK LINE
- NEW BUILDING
- NEW CURB
- CONSTRUCTION JOINT
- EXISTING CATCH BASIN
- TEMPORARY SILT FENCE

REVISED: 03-01-07ab
REVISED: 02-28-07

CONTRACT SET- 10/10/07

PAVING PLAN

ST. TAMMANY PARISH ADMIN. COMPLEX
520 OLD SPANISH TRAIL
SLIDELL, LOUISIANA

RENOVATE OFFICE BUILDING

DAMMON ENGINEERING, INC.
1095 FLORIDA AVENUE 985-649-5832 SLIDELL, LA. 70458
DAMMONENGINEERING.COM

SCALE: 1"=20'
FILE:
JOB NO. 1729
DATE:1-8-07
SHEET C-5
OF