☐ RFI #2 ○ CHANGE ORDER #2

FINISH SCHEDULE

ROOM	FLOOR: CONCRETE	FLOOR: VINYL TILE	FLOOR: CARPET	FLOOR: CERAMIC TILE	FLOOR: PAINTED WOOD	BASE: VINYL	BASE: WOOD	BASE: NONE	WALLS: GYPSUM BOARD	WALLS: GREENBOARD	WALLS: CMU	WALLS: PAINT	WALLS: CERAMIC TILE	CEILING: ACOUSTIC TILE	CEILING: GYPSUM BOARD	CEILING: FRP BOARD	CEILING: OPEN	CEILING: TEXT. CONC.	CLG HT	REMARKS
200		●				●			●			●		●					9'-0"	CHAIR RAIL/
201		●				●			●			●		●					9'-0"	
202	●							●	●			●					●		9'-0"	
203																			9'-0"	NOT USED
204	●					●			●			●			●				9'-0"	1HR RATED RM.
205				●						●		●	●						9'-0"	WAINSCOT
206				●						●		●	●	●					9'-0"	WAINSCOT
207																			9'-0"	NOT USED
208																			9'-0"	NO INTERIOR FINISHES
209		●				●			●			●		●					9'-0"	
210		●				●			●			●		●					9'-0"	
211		●				●			●			●		●					9'-0"	
212		●				●				●		●		●					9'-0"	
213	●							●				●					●		10'-4"	
214	●							●				●		●					9'-0 '	
215			●			●			●			●		●					9'-0"	
216			●			●			●			●		●					9'-0"	
217			●			●			●			●		●					9'-0"	
218			●			●			●			●		●					9'-0"	
		●				●			●			●		●					9'-0"	

DOOR & HARDWARE SCHEDULE

DOOR	TYPE: SOLID WOOD	TYPE: HOLLOW	TYPE: ALUM./GLASS	TYPE: STEEL	TYPE: MASONITE	FRAME: STEEL	FRAME: ALUMINUM	FRAME: WOOD	FRAME: CASED OPENING	HINGE: DOUBLE SWING	HINGE: BUTT 1 1/2 PR	HINGE: SLIDING	LOCK: PASSAGE	LOCK: MAGNETIC	LOCK: DEADBOLT	LOCK: KEYED HANDLE	ACCESSORIES: PUSH PULL	ACCESSORIES: PANIC	ACCESSORIES: THRESHOLD	ACCESSORIES: WEATHERSTRIP	ACCESSORIES: DOOR STOP	ACCESSORIES: ALARM	ACCESSORIES: VIEW GLASS	REMARKS
1 3/0x7/0	●					●					●					●							●	STAIN & VARNISH
2 3/0x7/0	●					●					●					●								
3 3/0x7/0																								EXISTING TO REMAIN
4 3/0x7/0	●					●					●						●							
5 (2) 3/0x7/0	●					●					●					●								
6 3/0x7/0	●					●					●			●				●	●					1 HOUR RATED
7 (2) 3/0x7/0															●									EXISTING TO REMAIN-REFINISH
8 3/0x7/0				●		●					●					●								
9 3/0x7/0																								EXISTING TO REMAIN-REFINISH
10 3/0x7/0																								RELOCATE FROM 1st FLOOR-REFINISH

DOORS SHOWN WITH ▲ SHALL BE EQUIPPED W/ ELECTRIC STRIKE (MAGNETIC LOCK ON DOUBLE DOORS) FOR CARD READER
UNDERCUT ALL DOORS 3/4" TO ALL FOR PROPER EXHAUST AIR FLOW

WINDOW SCHEDULE

WINDOW	TYPE: FIXED	TYPE: VERTICAL SLIDE	TYPE: HORIZONAL SLIDE	TYPE: STORE FRONT	FRAME: STEEL	FRAME: ALUMINUM	FRAME: WOOD	GLASS: TINTED	GLASS: PLAIN	GLASS: GLAZED	GLASS: WIREGLASS	LITES: NONE	LITES: 2/2	LITES: 4/4	LITES: 6/6	LITES: 8/8	ACCESSORIES: ALARM	ACCESSORIES: SCREEN	ACCESSORIES: SHUTTER	ACCESSORIES: NONE	REMARKS
A *4/0x5/0	●					●			●			●								●	APPROXIMATELY 3,000 SQ. FT.
B																					
C																					
D																					

*FINAL SIZES TO BE DETERMINED BY VENDOR FROM FIELD MEASUREMENTS [TYP. ALL FLOORS]

LEGEND

NEW WALL —
NEW FIRE RATED WALL —
EXISTING WALL —
CURTAIN WALL —
SECURITY ACCESS DOOR – ▲
(SCANNER BY OTHERS)
RETURN AIR CASED OPENING IN WALL – (ROOM TO CEILING)– TO EQUAL 200 SQ. IN.

(1) 18" COUNTERTOP FINISHED AT 42" HIGH ABOVE. 2X6 WALL. 4' HIGH BY 8' WIDE SHEETROCK OPENING ABOVE

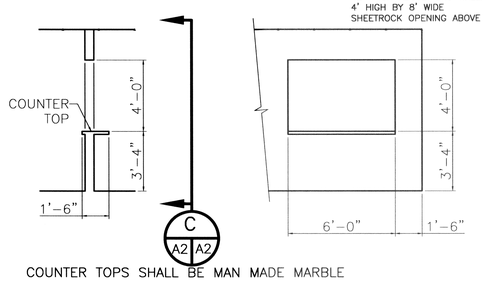

COUNTER TOPS SHALL BE MAN MADE MARBLE

SECTION B A2 A2
SCALE: 1/4" = 1'-0"

SECTION C A2 A2
SCALE: 1/4" = 1'-0"

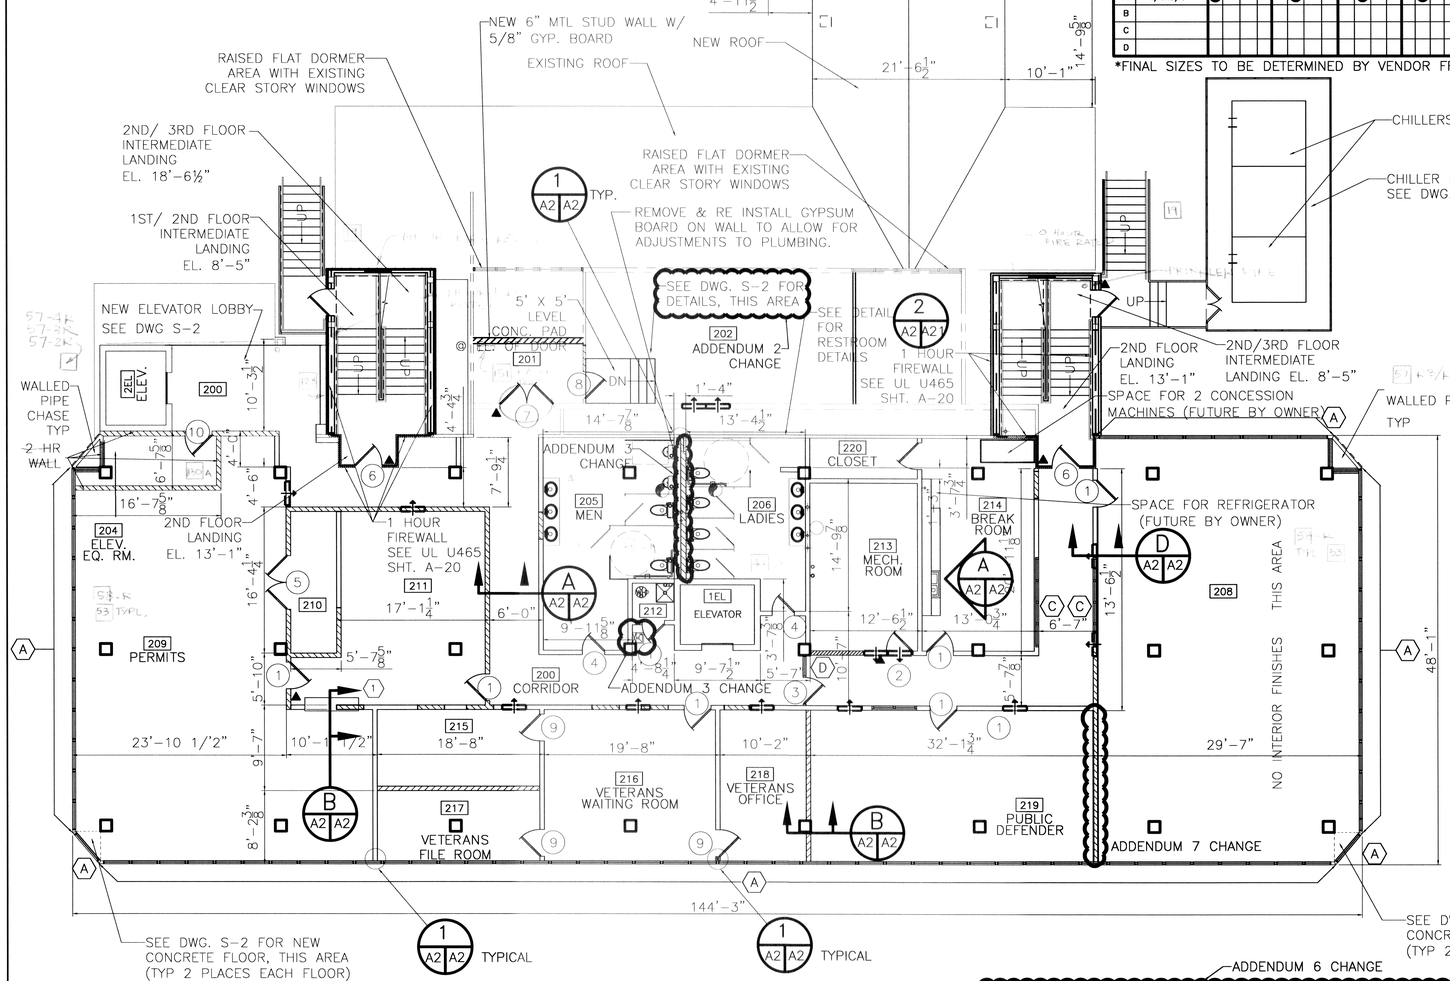

SECOND FLOOR PLAN
SCALE: 1/8"= 1'-0"

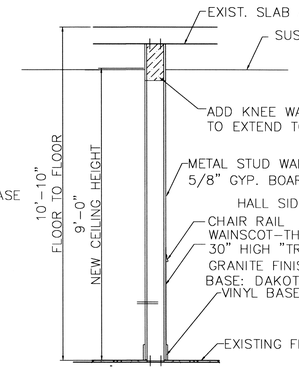

SECTION D A2 A2
NTS

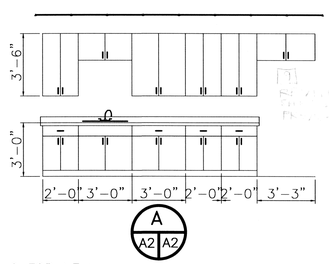

A A2 A2

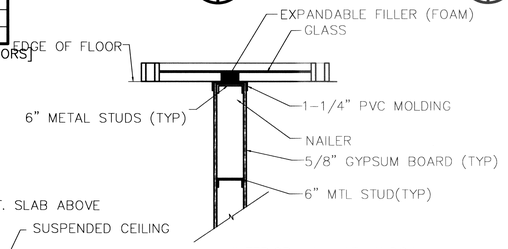

INTERIOR WALL AT WINDOW
DETAIL 1 A2 A2
NTS

NOTE:
INSTALL DUCTWORK ENTRANCES AS REQUIRED. SEE DWG. M-2 FOR A/C DETAILS

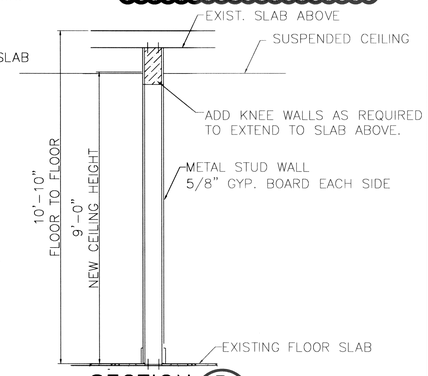

SECTION B A2 A2
NTS

NOTE:
KITCHEN CABINETS SHALL BE MEDIUM COMMERCIAL GRADE, FACTORY BUILT. COUNTER TOPS SHALL BE MANMADE MARBLE OR EQUAL.

ADDENDUM 6 CHANGE

= ADDENDUM CHANGE
= 09/19/07 CHANGE

ADDENDUM
REVISED: 11/05/07ab
REVISED: 09/19/07ab
REVISED: 08/20/07ab
REVISED: 05/21/07ab
REVISED: 05/17/07ab
REVISED: 04/09/07ab
REVISED: 03/07/07ab
REVISED: 02/19/07
REVISED: 01/22/07

CONTRACT SET- 10/10/07

2ND FLOOR RENOVATE PLAN

ST. TAMMANY PARISH ADMIN. COMPLEX
520 OLD SPANISH TRAIL
SLIDELL, LOUISIANA

RENOVATE OFFICE BUILDING

DAMMON ENGINEERING. INC.
1095 FLORIDA AVENUE 985-649-5832 SLIDELL, LA. 70458
DAMMONENGINEERING.COM

SCALE:AS NOTED
FILE:
JOB NO. 1729
DATE:1-9-07
SHEET A-2
OF