☐ RFI #'s

◯ CHANGE ORDER #'s

LEGEND

NEW WALL —

NEW 1 HOUR – RATED WALL

EXISTING WALL —

CURTAIN WALL —

SECURITY ACCESS DOOR – ▲ (SCANNER BY OTHERS)

RETURN AIR CASED OPENING IN WALL – (ROOM TO CEILING)– TO EQUAL 200 SQ. IN.

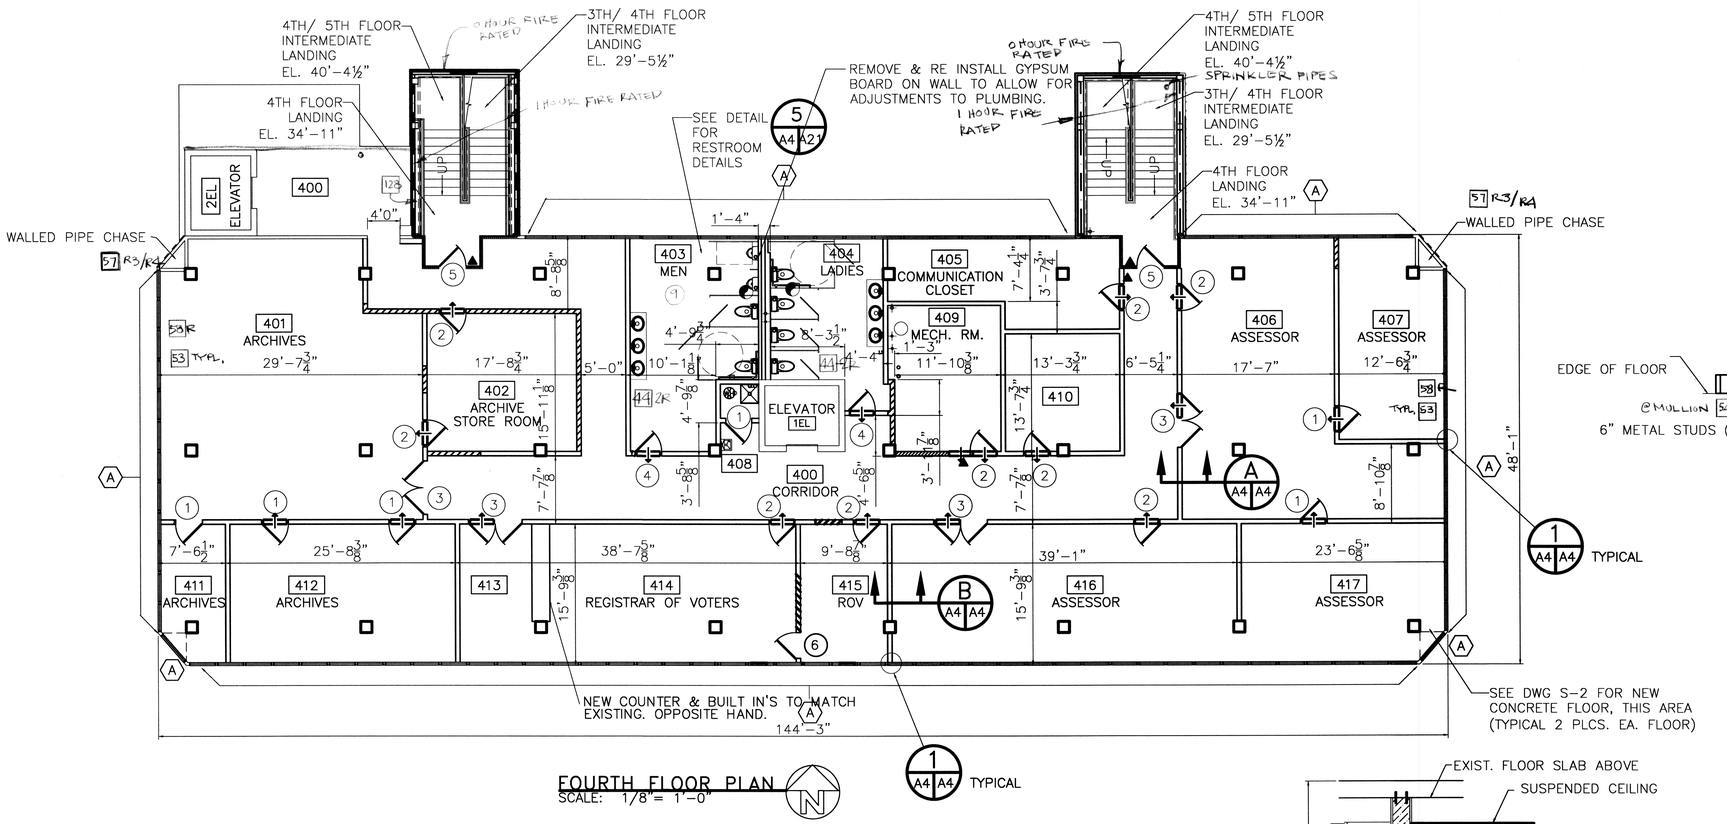

FOURTH FLOOR PLAN
SCALE: 1/8" = 1'-0"

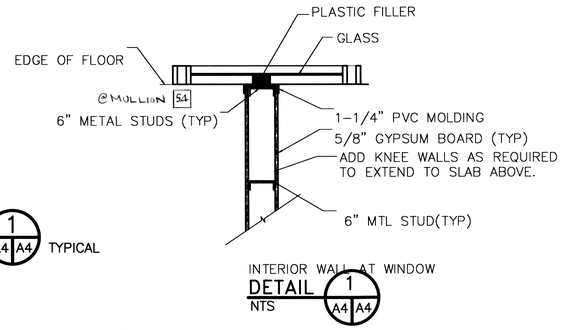

FINISH SCHEDULE

ROOM	FLOOR: CONCRETE	FLOOR: VINYL TILE	FLOOR: CARPET	FLOOR: CERAMIC TILE	FLOOR: PAINTED WOOD	BASE: VINYL	BASE: WOOD	BASE: NONE	WALLS: GYPSUM BOARD	WALLS: GREENBOARD	WALLS: CERAMIC TILE	WALLS: PAINT	CEILING: ACOUSTIC TILE	CEILING: GYPSUM BOARD	CEILING: FRP BOARD	CEILING: OPEN	CEILING: TEXT. CONC.	CLG HT	REMARKS
400		●				●			●			●	●					8'-6"	
401		●				●			●			●	●					9'-0"	
402			●			●			●			●	●					9'-0"	
403				●		●				●	●	●	●					9'-0"	
404				●		●				●	●	●	●					9'-0"	
405		●				●			●			●	●					9'-0"	
406			●			●			●			●	●					9'-0"	
407			●			●			●			●	●					9'-0"	
408		●				●					●	●	●					9'-0"	
409	●							●				●				●		10'-4"	
410			●			●			●			●	●					9'-0"	
411			●			●			●			●	●					9'-0"	
412			●			●			●			●	●					9'-0"	
413			●			●			●			●	●					9'-0"	
414			●			●			●			●	●					9'-0"	
415			●			●			●			●	●					9'-0"	
416			●			●			●			●	●					9'-0"	
417			●			●			●			●	●					9'-0"	

UNDERCUT ALL DOORS 3/4" TO ALL FOR PROPER EXHAUST AIR FLOW

DOOR & HARDWARE SCHEDULE

○ DOOR	TYPE: SOLID WOOD	TYPE: HOLLOW	TYPE: ALUM./GLASS	TYPE: STEEL	TYPE: MASONITE	FRAME: STEEL	FRAME: ALUMINUM	FRAME: WOOD	FRAME: CASED OPENING	HINGE: DOUBLE SWING	HINGE: BUTT 1 1/2 PR	HINGE: BURGLARPROOF	HINGE: SLIDING	LOCK: MAGNETIC	LOCK: DEADBOLT	LOCK: KEYED HANDLE	LOCK: PUSH PULL	ACCESSORIES: PANIC	ACCESSORIES: THRESHOLD	ACCESSORIES: WEATHERSTRIP	ACCESSORIES: DOOR STOP	ACCESSORIES: CLOSER	ACCESSORIES: WIRED GLASS	ACCESSORIES: VIEW GLASS	REMARKS
1	3/0x7/0																								EXISTING TO REMAIN –REFINISH
2	3/0x7/0	●				●					●					●					●	●		●	
3	(2)3/0x7/0																								EXISTING–REHANG AS REQUIRED FOR FIT
4	3/0x7/0	●				●					●						●				●	●			
5	3/0x7/0	●				●					●					●		●			●	●			1 HOUR RATED
6	3/0x7/0	●				●					●					●					●				

DOORS SHOWN WITH ▲ SHALL BE EQUIPPED WITH ELECTRIC STRIKE FOR CARD READER

WINDOW SCHEDULE

○ WINDOW	TYPE: FIXED	TYPE: VERTICAL SLIDE	TYPE: HORIZ SLIDE	TYPE: STORE FRONT	FRAME: STEEL	FRAME: ALUMINUM	FRAME: WOOD	GLASS: TINTED	GLASS: PLAIN	GLASS: GLAZED	GLASS: WIREGLASS	LITES: NONE	LITES: 2/2	LITES: 4/4	LITES: 6/6	LITES: 8/8	ACCESSORIES: ALARM	ACCESSORIES: SCREEN	ACCESSORIES: SHUTTER	ACCESSORIES: NONE	REMARKS
A	*4/0x5/0	●				●						●								●	APPROXIMATELY 3,700 SQ. FT.

*FINAL SIZES TO BE DETERMINED BY VENDOR FROM FIELD MEASUREMENTS [TYP. ALL FLOORS]

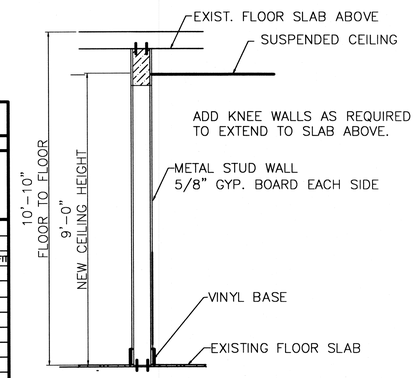

SECTION B
NTS

TYPICAL ONLY WHERE WALL IS NOT 9 FT HIGH

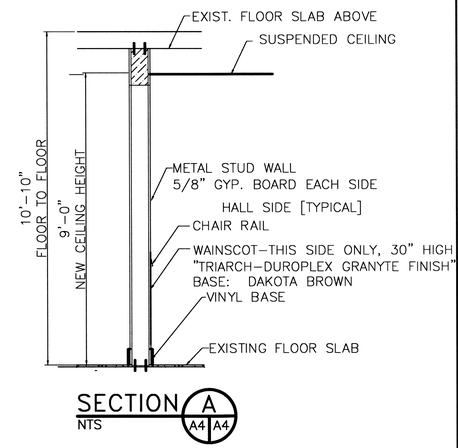

SECTION A
NTS

TYPICAL ONLY WHERE WALL IS NOT 9 FT HIGH

REVISED: 11/05/07 ab
REVISED: 05/17/07
REVISED: 02/19/07
REVISED: 01/23/07

4TH FLOOR RENOVATE PLAN

ST. TAMMANY PARISH ADMIN. COMPLEX
520 OLD SPANISH TRAIL
SLIDELL, LOUISIANA

RENOVATE OFFICE BUILDING

DAMMON ENGINEERING, INC.
1095 FLORIDA AVENUE 985-649-5832 SLIDELL, LA. 70458
DAMMONENGINEERING.COM

SCALE:AS NOTED

FILE:

JOB NO. 1729

DATE:1-8-07

SHEET
A-4
OF