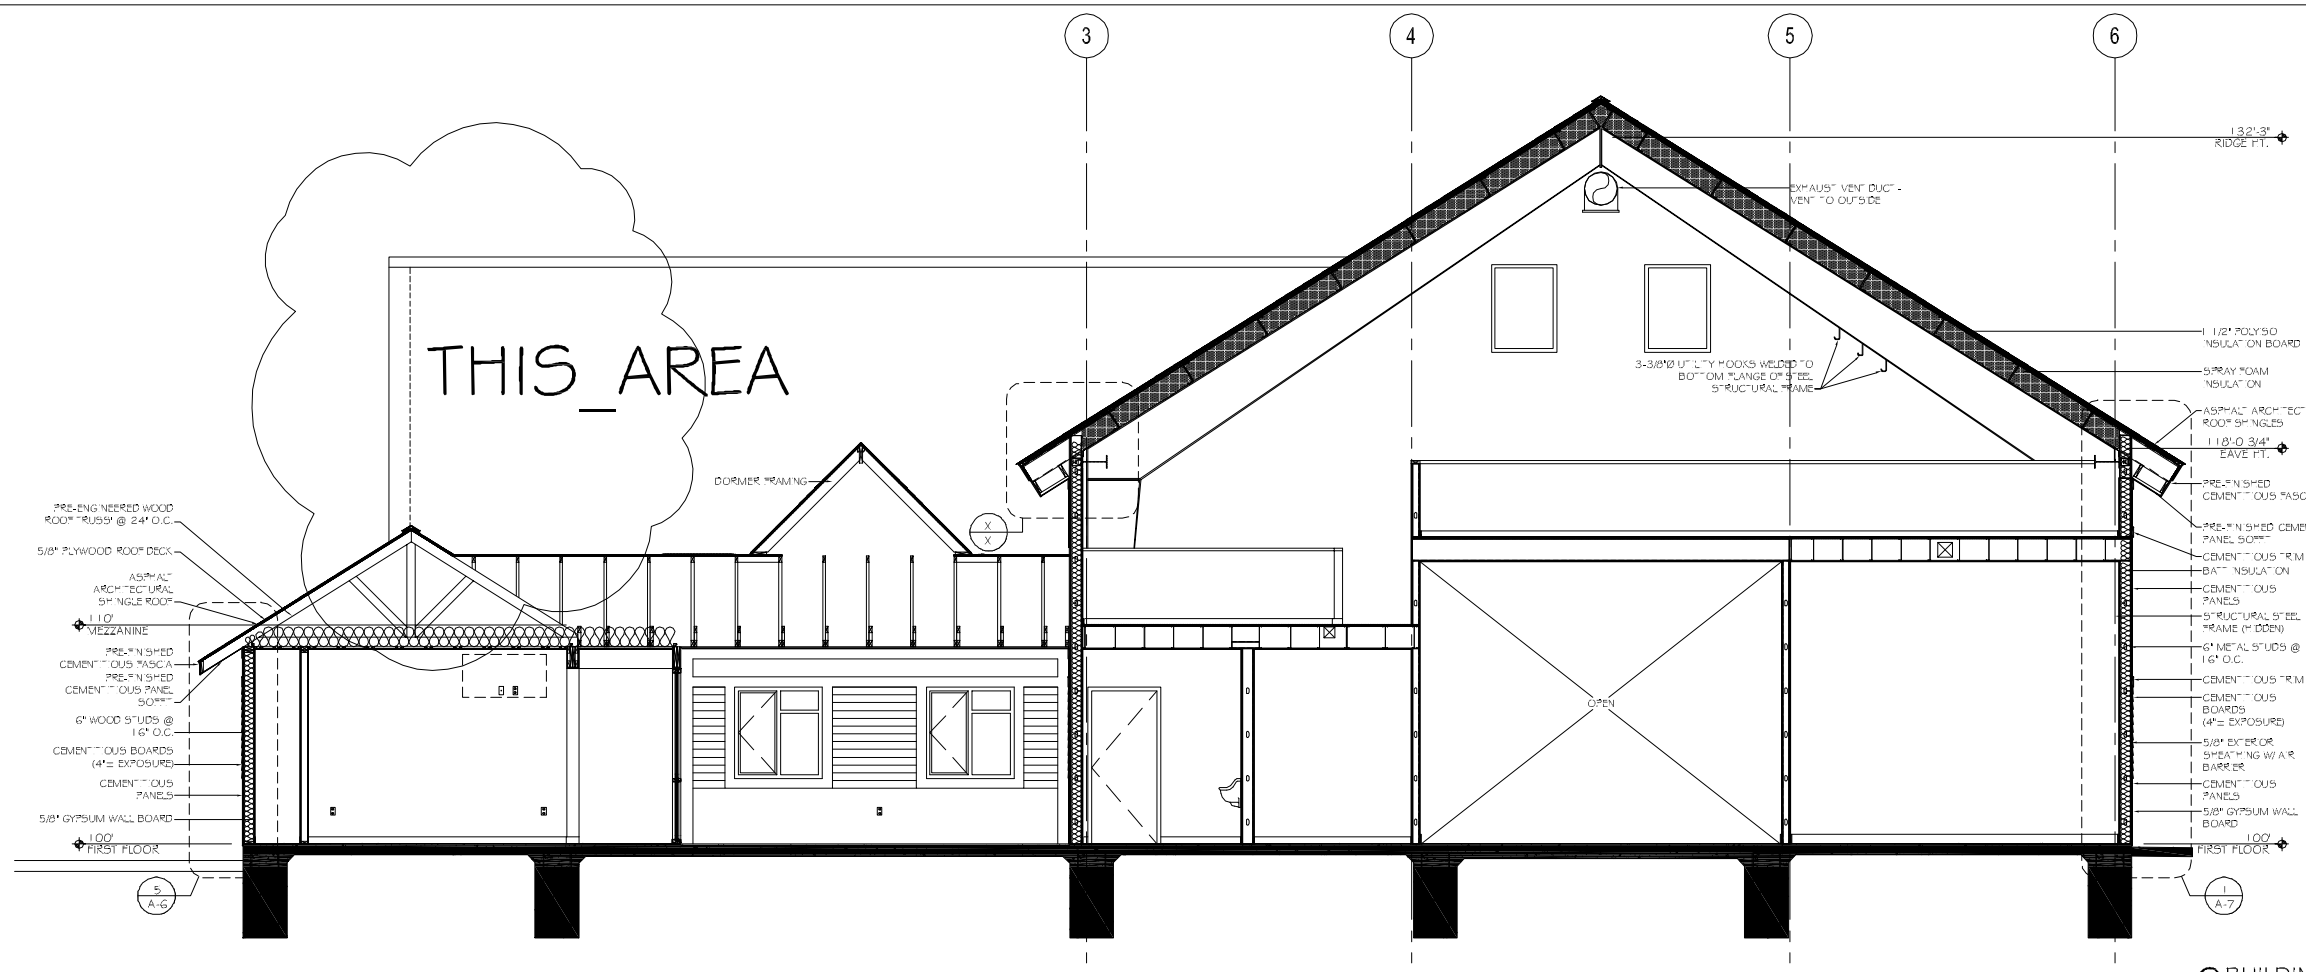

2 BUILDING SECTION
SCALE: 1/4" = 1'-0"

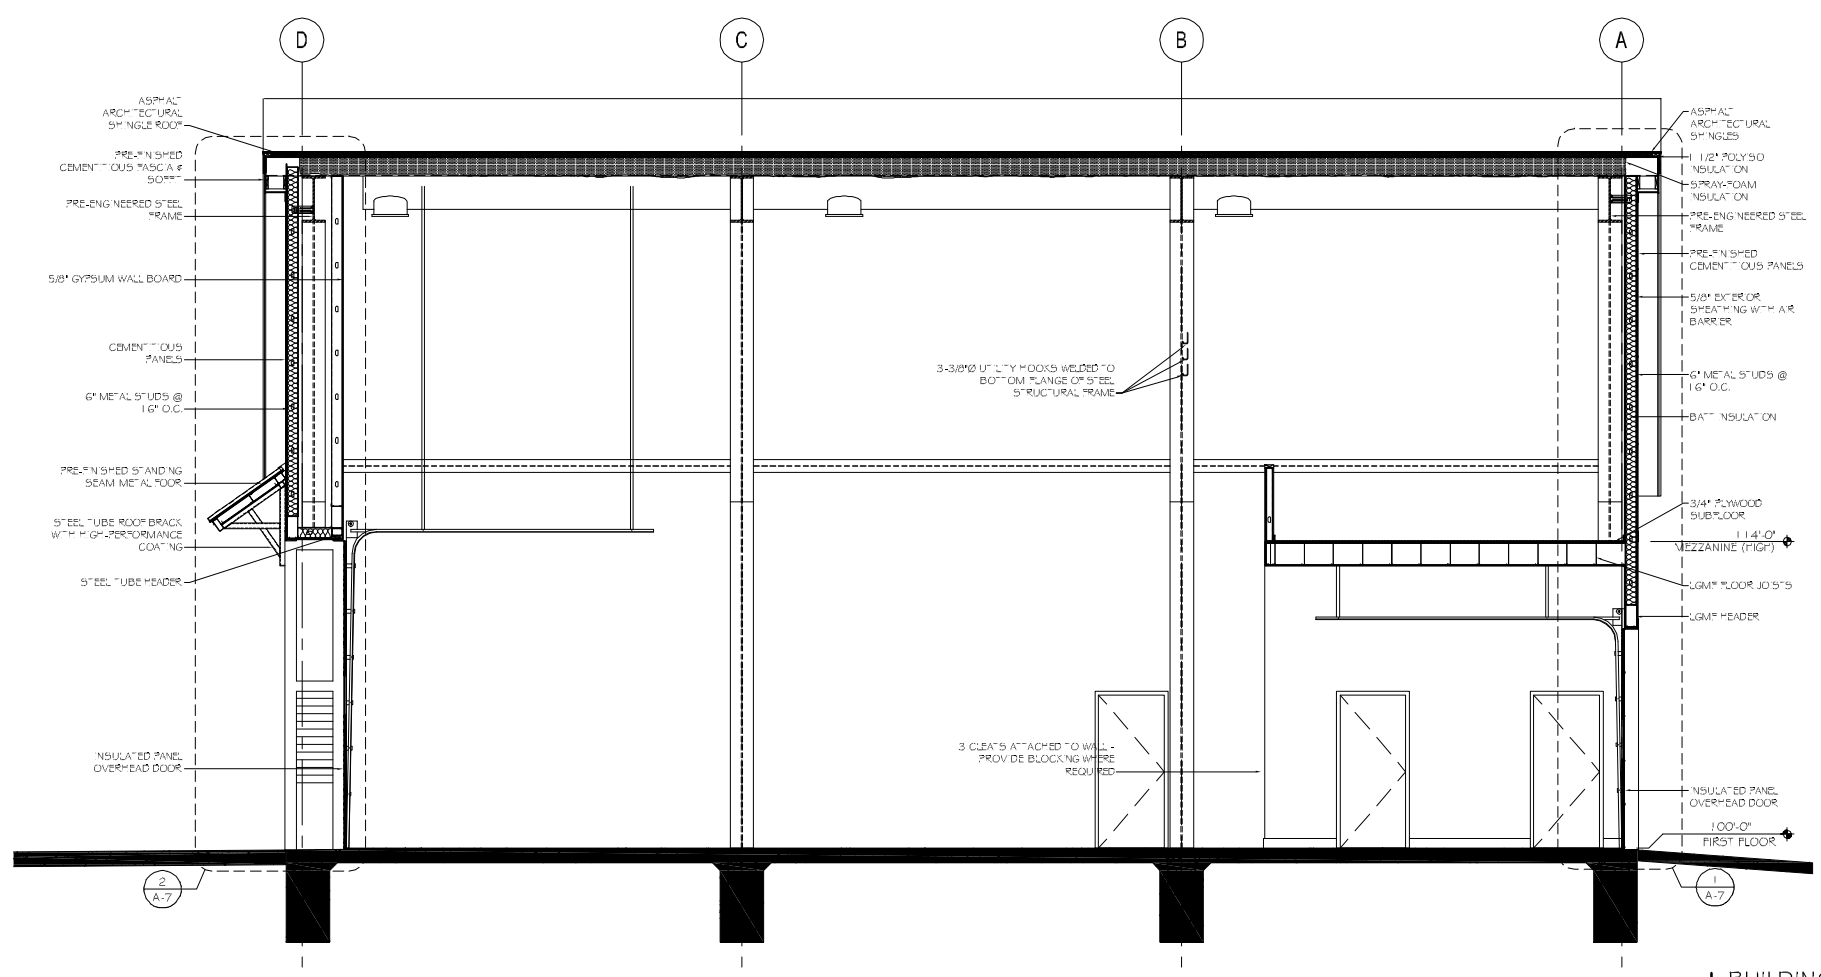

1 BUILDING SECTION
SCALE: 1/4" = 1'-0"

DAMMON ENGINEERING, INC.
Architects & Engineers
dammoneng@bellsouth.net
PHONE: 985-649-5932
FAX: 985-624-5950
CHIEF ENGINEER: EMMETT DAMMON, P.E.
CHIEF ARCHITECT: KEVIN KINCHEN
554 OLD SPANISH TRAIL
SLIDELL, LA 70458

These drawings & specifications are the property of Dammon Engineering, Inc. and shall not be reproduced or copied in whole or in part without written permission of Dammon Engineering, Inc. These drawings & specifications are not to be used on any other project.

DISTRICT 1
FIRE STATION 4

297 STEELE ROAD
SLIDELL, LA

JOB No:	DATE: 3/13/2013
DRAWN BY: KJK	CHECKED BY: KJK

#	DESCRIPTION	DATE
REVISIONS		

BUILDING SECTIONS

SHEET No: 01 OF 1

A-6.1