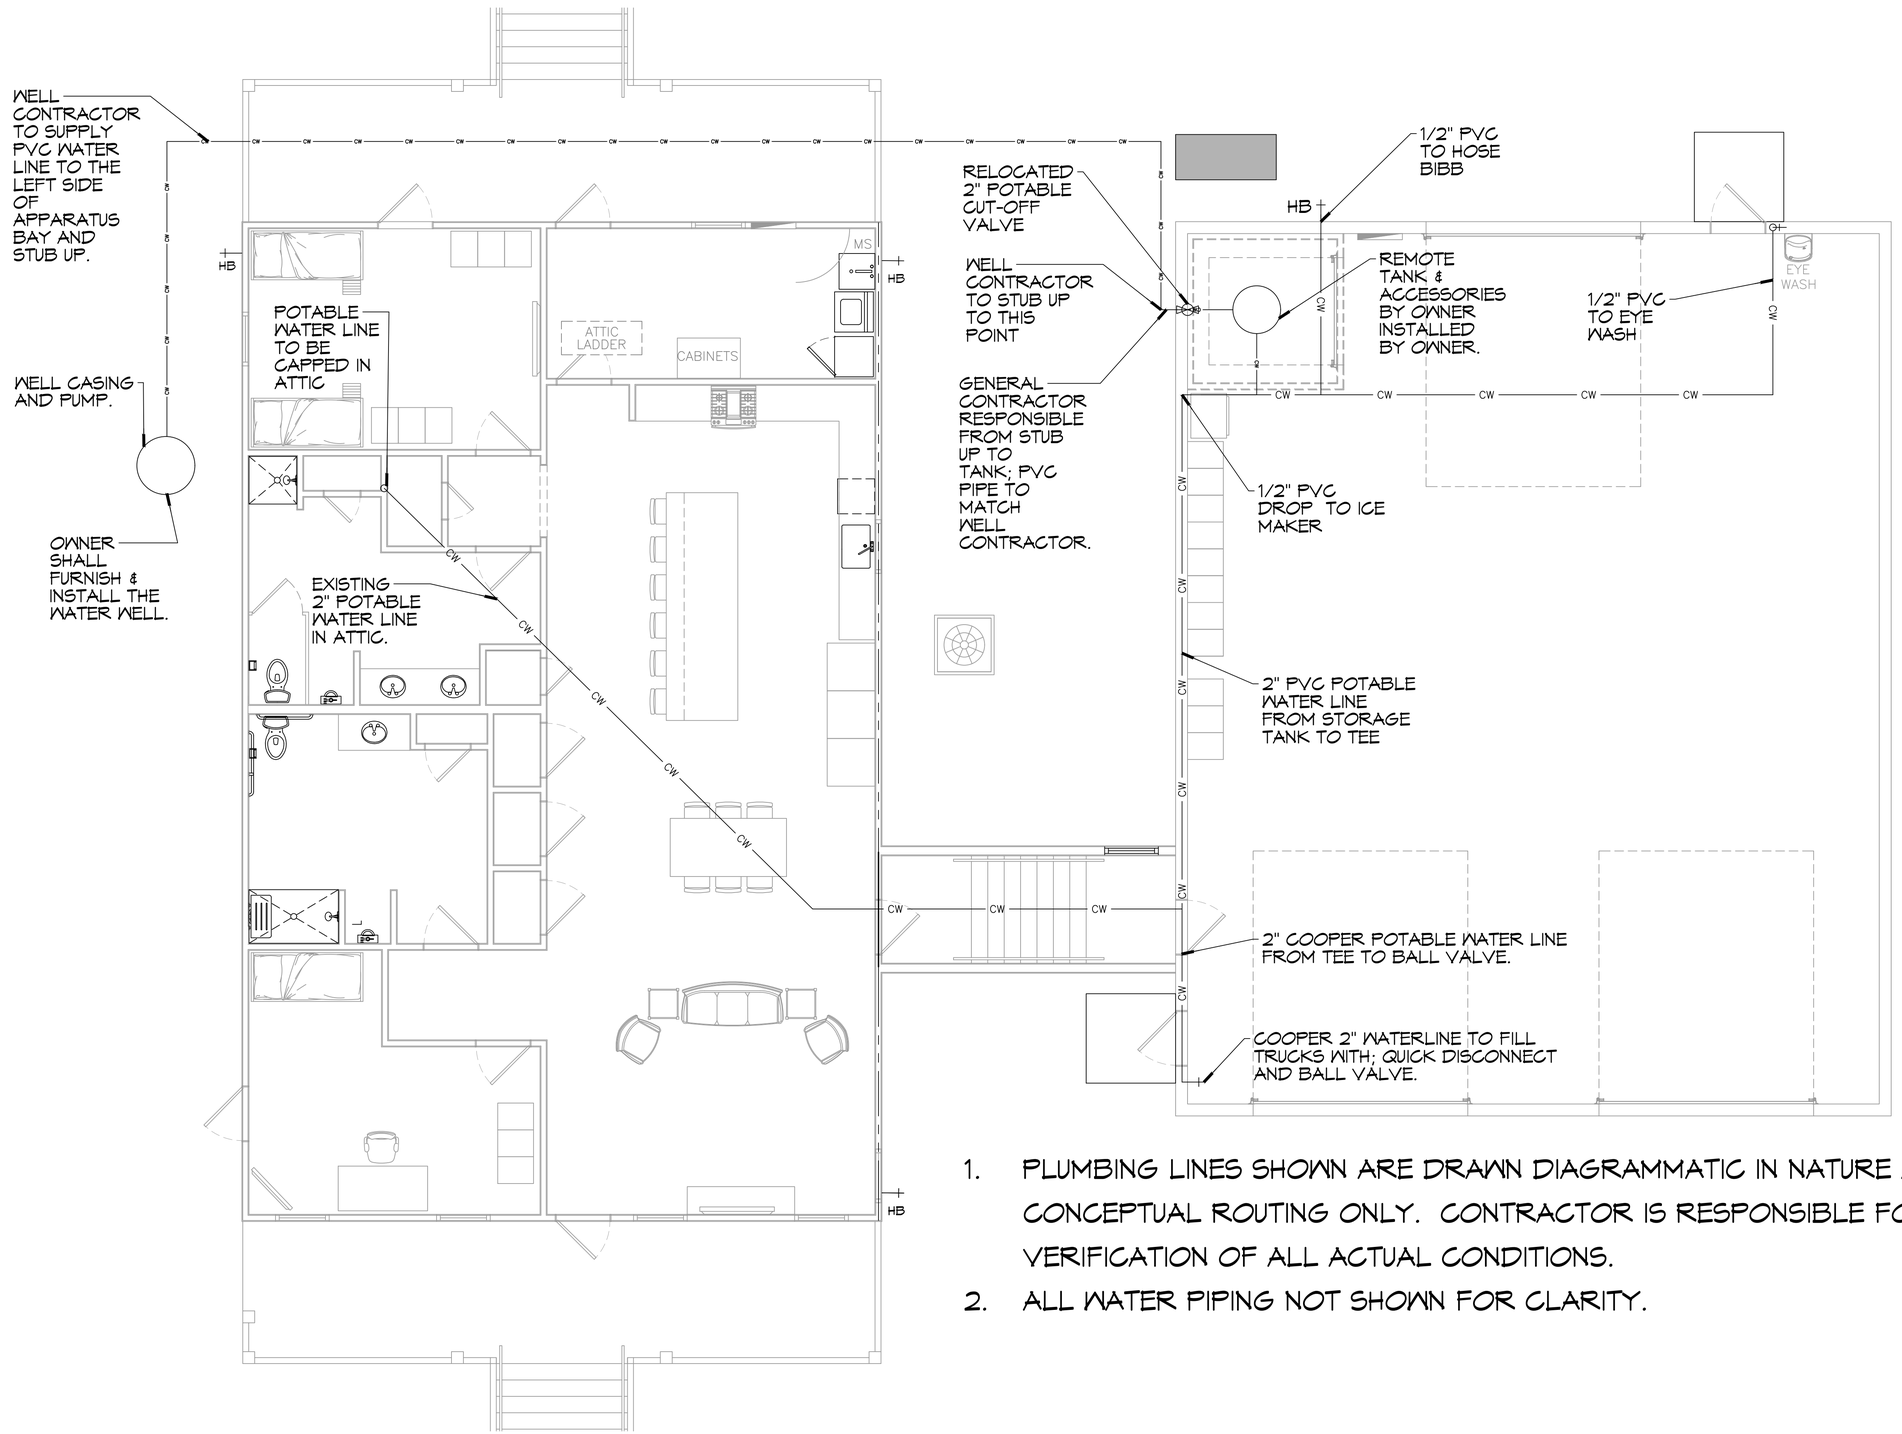

1. PLUMBING LINES SHOWN ARE DRAWN DIAGRAMMATIC IN NATURE AND REPRESENT CONCEPTUAL ROUTING ONLY. CONTRACTOR IS RESPONSIBLE FOR FIELD VERIFICATION OF ALL ACTUAL CONDITIONS.
2. ALL WATER PIPING NOT SHOWN FOR CLARITY.

1 WATER WELL AND WATER MAIN(S) PLAN
SCALE: 1/4"= 1'-0"

AS-BUILT
1-31-24

DAMMON ENGINEERING, INC.
LOUISIANA & MISSISSIPPI
www.dammonengineering.com
info@dammonengineering.com
PH: 985.649.5832
Chief Engineer: Brian Mistich, PE
5141 Salmen Park Trail
Slidell, LA 70458

#	DESCRIPTION	REVISIONS	DATE

STATE OF LOUISIANA
BRIAN A. MISTICH
License No. 30187
5/9/2022
PROFESSIONAL ENGINEER

ST. TAMMANY FIRE PROTECTION DISTRICT NO. 1

FIRE STATION 19

5104 ALLEN ROAD
SLIDELL, LOUISIANA 70461

JOB No: 2456
DATE: 05-16-2022
DRAWN BY: CKD
CHECKED BY: JVS

THE ABOVE CONTAINS THE INFORMATION, DESIGN CONTENT, AND SPECIFICATIONS THEREOF ARE THE PROPERTY OF DAMMON ENGINEERING, INC. AND SHALL NOT BE REPRODUCED IN WHOLE OR IN PART WITHOUT THE WRITTEN PERMISSION OF DAMMON ENGINEERING, INC. THIS DOCUMENT IS TRANSMITTED ONLY TO THE PARTIES TO WHOM IT IS ADDRESSED AND FOR THE PURPOSES STATED WITHIN THE DOCUMENT TO WHICH THIS NOTE IS ATTACHED. SUCH DOCUMENT IS PROVIDED AS INFORMATION ONLY AND MAY NOT BE RELIED UPON BY OTHER PERSONS OR ENTITIES FOR ANY PURPOSE WHATSOEVER.

SHEET TITLE:
WATER WELL & WATER MAIN(S) PLAN

DRAWING NUMBER:
P103

SHEET No: 23 of 30