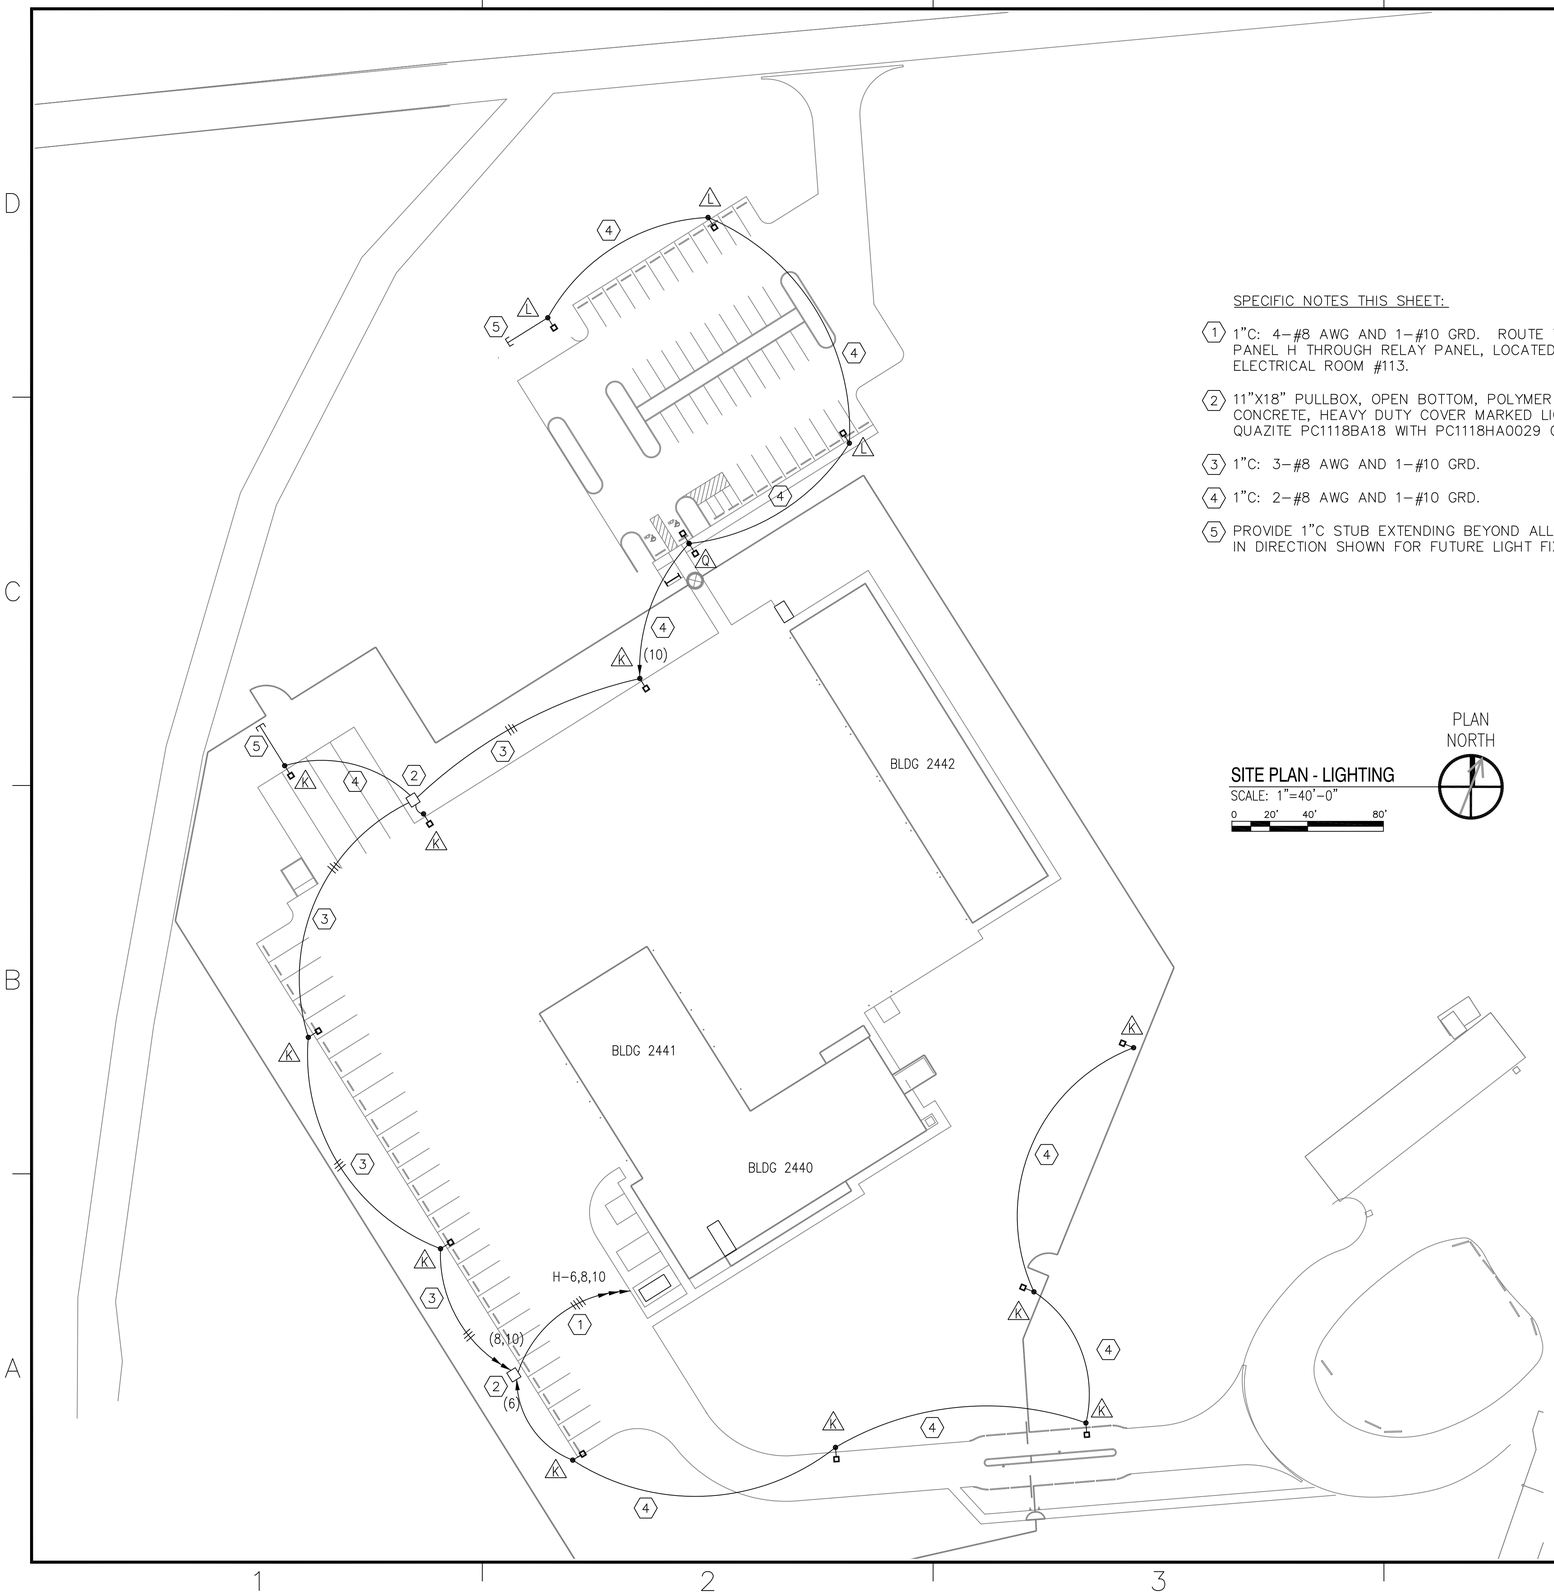

SPECIFIC NOTES THIS SHEET:

1. 1"C: 4–#8 AWG AND 1–#10 GRD. ROUTE TO PANEL H THROUGH RELAY PANEL, LOCATED IN ELECTRICAL ROOM #113.
2. 11"X18" PULLBOX, OPEN BOTTOM, POLYMER CONCRETE, HEAVY DUTY COVER MARKED LIGHTING. QUAZITE PC1118BA18 WITH PC1118HA0029 COVER.
3. 1"C: 3–#8 AWG AND 1–#10 GRD.
4. 1"C: 2–#8 AWG AND 1–#10 GRD.
5. PROVIDE 1"C STUB EXTENDING BEYOND ALL PAVING IN DIRECTION SHOWN FOR FUTURE LIGHT FIXTURES.

PLAN NORTH

SITE PLAN - LIGHTING
SCALE: 1"=40'-0"
0 20' 40' 80'

RECORD DRAWING
LETTER DATED
5-27-10

AS-BUILT REVISIONS

DESCRIPTION	DATE	APPR
	5-27-10	

NAVFAC

SCHLAFLY ENGINEERING LLC
121 SOUTH GENOIS STREET
NEW ORLEANS LA 70119
PHONE 504-415-3347
FAX 504-482-7943

M. KIMBALL SCHLAFLY, P.E.
LA REG 27699

SEPTEMBER 4, 2009

STATE OF LOUISIANA
M. KIMBALL SCHLAFLY
REG. No. 27699
REGISTERED PROFESSIONAL ENGINEER
IN
ELECTRICAL ENGINEERING
SEAL

DES: K. SCHLAFLY | DRW: K. SCHLAFLY
REVIEWED BY: R. WILTSE
PM/DM: T. ARTRIP
CHIEF ENG/ARCH: P. DAMMON

DEPARTMENT OF THE NAVY
NAVAL FACILITIES ENGINEERING COMMAND
NAVAL FACILITIES ENGINEERING COMMAND SOUTHEAST
NAVAL AIR STATION JACKSONVILLE
MISSISSIPPI
JOHN C. STENNIS SPACE CENTER
IPT SOUTH ATLANTIC

SOF RIVERINE AND COMBATANT CRAFT OPERATIONS FACILITY

SITE PLAN - LIGHTING

CODE ID. NO. N4412	SIZE D
SCALE:	1" = 40'-0"
MAXIMO NO.	######
STA. PROJ. NO.	P-210
WORK ORDER NO.	510247
CONSTR. CONTR. NO.	N62467-05-D-0096
NAVFAC DRAWING NO.	15026753
SHEET	106 OF 132

E2.1

DRAWFORM REVISION: 01 JAN 2009

REVDATE: FILE NAME: C:\ Schlafly ENGR\08010 SOF Riverine\Drawings\Elec\5-As-builts\E2.1.dwg LAYOUT NAME: E2.1 PLOTTED: Friday, May 28, 2010 - 2:54pm