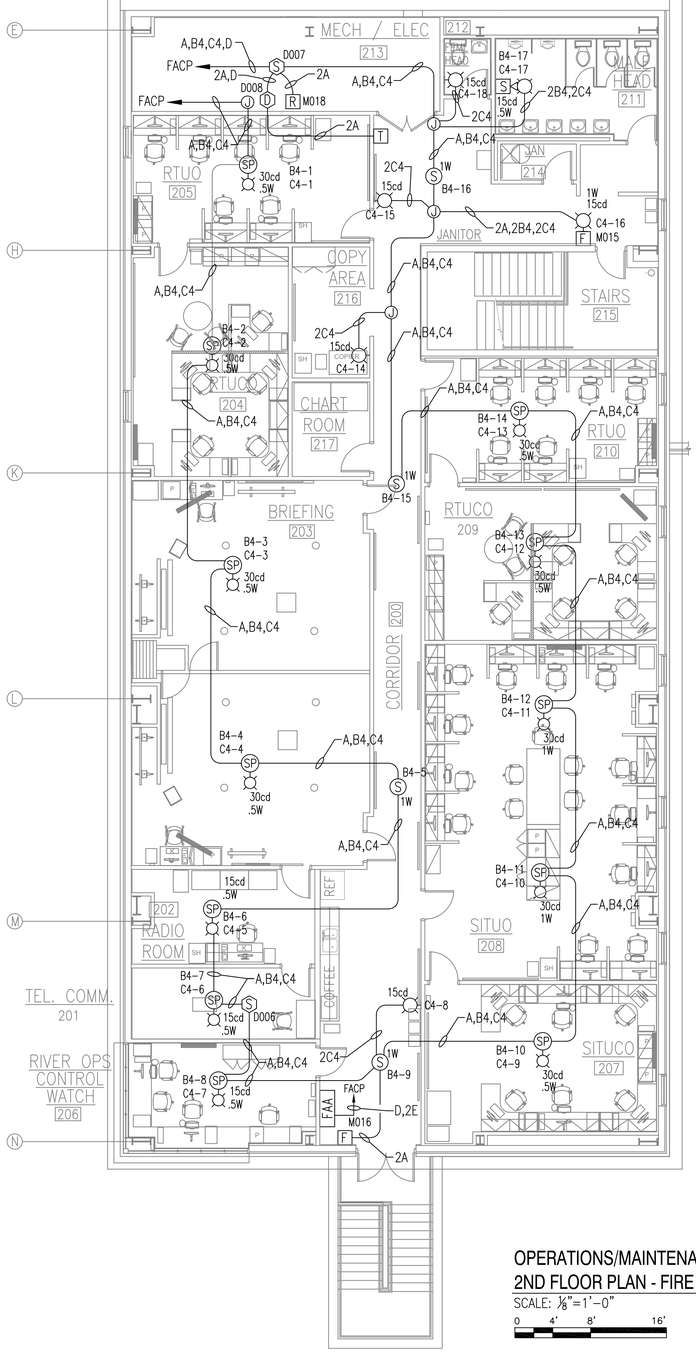

BLDG 2440/2441 SPEAKER WATTAGE CALCULATION

DAA-5025 #1		DAA-5025 #2	
SPEAKER CIRCUIT B1:	12@0.5W = 6W 2@1W = 2W TOTAL = 8W	SPEAKER CIRCUIT B2:	1@0.5W = 0.5W 6@1W = 6W TOTAL = 6.5W
SPEAKER CIRCUIT B4:	11@0.5W = 5.5W 6@1W = 6W TOTAL = 11.5W	SPEAKER CIRCUIT B3:	7@2W = 14W TOTAL = 20.5W
TOTAL = 19.5W 50W AVAILABLE, 61% SPARE CAPACITY		TOTAL = 20.5W 50W AVAILABLE, 59% SPARE CAPACITY	

OPERATIONS/MAINTENANCE BLDG 2440/2441
2ND FLOOR PLAN - FIRE ALARM
SCALE: 1/8"=1'-0"
0 4' 8' 16'

PLAN NORTH

NICET CERTIFICATION
LARRY K. COOK
LEVEL IV / CERTIFICATION #75228
FIRE ALARM PROTECTION / FIRE ALARM SYS
EXPIRATION DATE: MARCH 01,2011

AS-BUILT
6-4-2010

DATE	DESCRIPTION	APPR
2/26/2010	REVISED PER URS AND NAVFAC COMMENTS	MJS

NAVFAC

SEAL

DES: DRW:
REVIEWED BY: R. WILTSE
PM/DM: T. ARTRIP
CHIEF ENG/ARCH: P. DAMMON

DEPARTMENT OF THE NAVY
NAVAL FACILITIES ENGINEERING COMMAND SOUTHEAST
IPT SOUTH ATLANTIC
NAVAL AIR STATION JACKSONVILLE MISSISSIPPI
JOHN C. STENNIS SPACE CENTER
SOF RIVERINE AND COMBATANT CRAFT OPERATIONS FACILITY

BLDG 2440 2ND FLOOR PLAN - FIRE ALARM

CODE ID. NO. N4412	SIZE D
SCALE:	1/8"=1'-0"
MAXIMO NO.	######
STA. PROJ. NO.	P-210
WORK ORDER NO.	510247
CONSTR. CONTR. NO.	N62467-05-D-0096
NAVFAC DRAWING NO.	######-##-#-####
SHEET	XXX OF XXX

FA1.2

DRAWFORM REVISION: 01 JAN 2009

REV/DATE: FILE NAME: C:\Schlafly ENGR\08010 SOF Riverine\Drawings\Elec\5-As-builts\ACC\10-06-04\FAS Drawings as-builts.dwg LAYOUT NAME: FA1.2 PLOTTED: Wednesday, June 09, 2010 - 1:04pm