


Part	Width	Thick.	Webthk	Depth	Approx. Lgth
SBX205	5"	.1345	.1345	11"	10'-0 1/16"
SBX206	8"	.2500	.1345	9"	19'-10 13/16"
SBX207	8"	.2500	.1345	9"	19'-10 15/16"
SBX208	5"	.1345	.1345	10"	10'-0 1/16"

Id	Qty	Bolt Diam.	Bolt Length
1	2	3/4"	1 1/2"

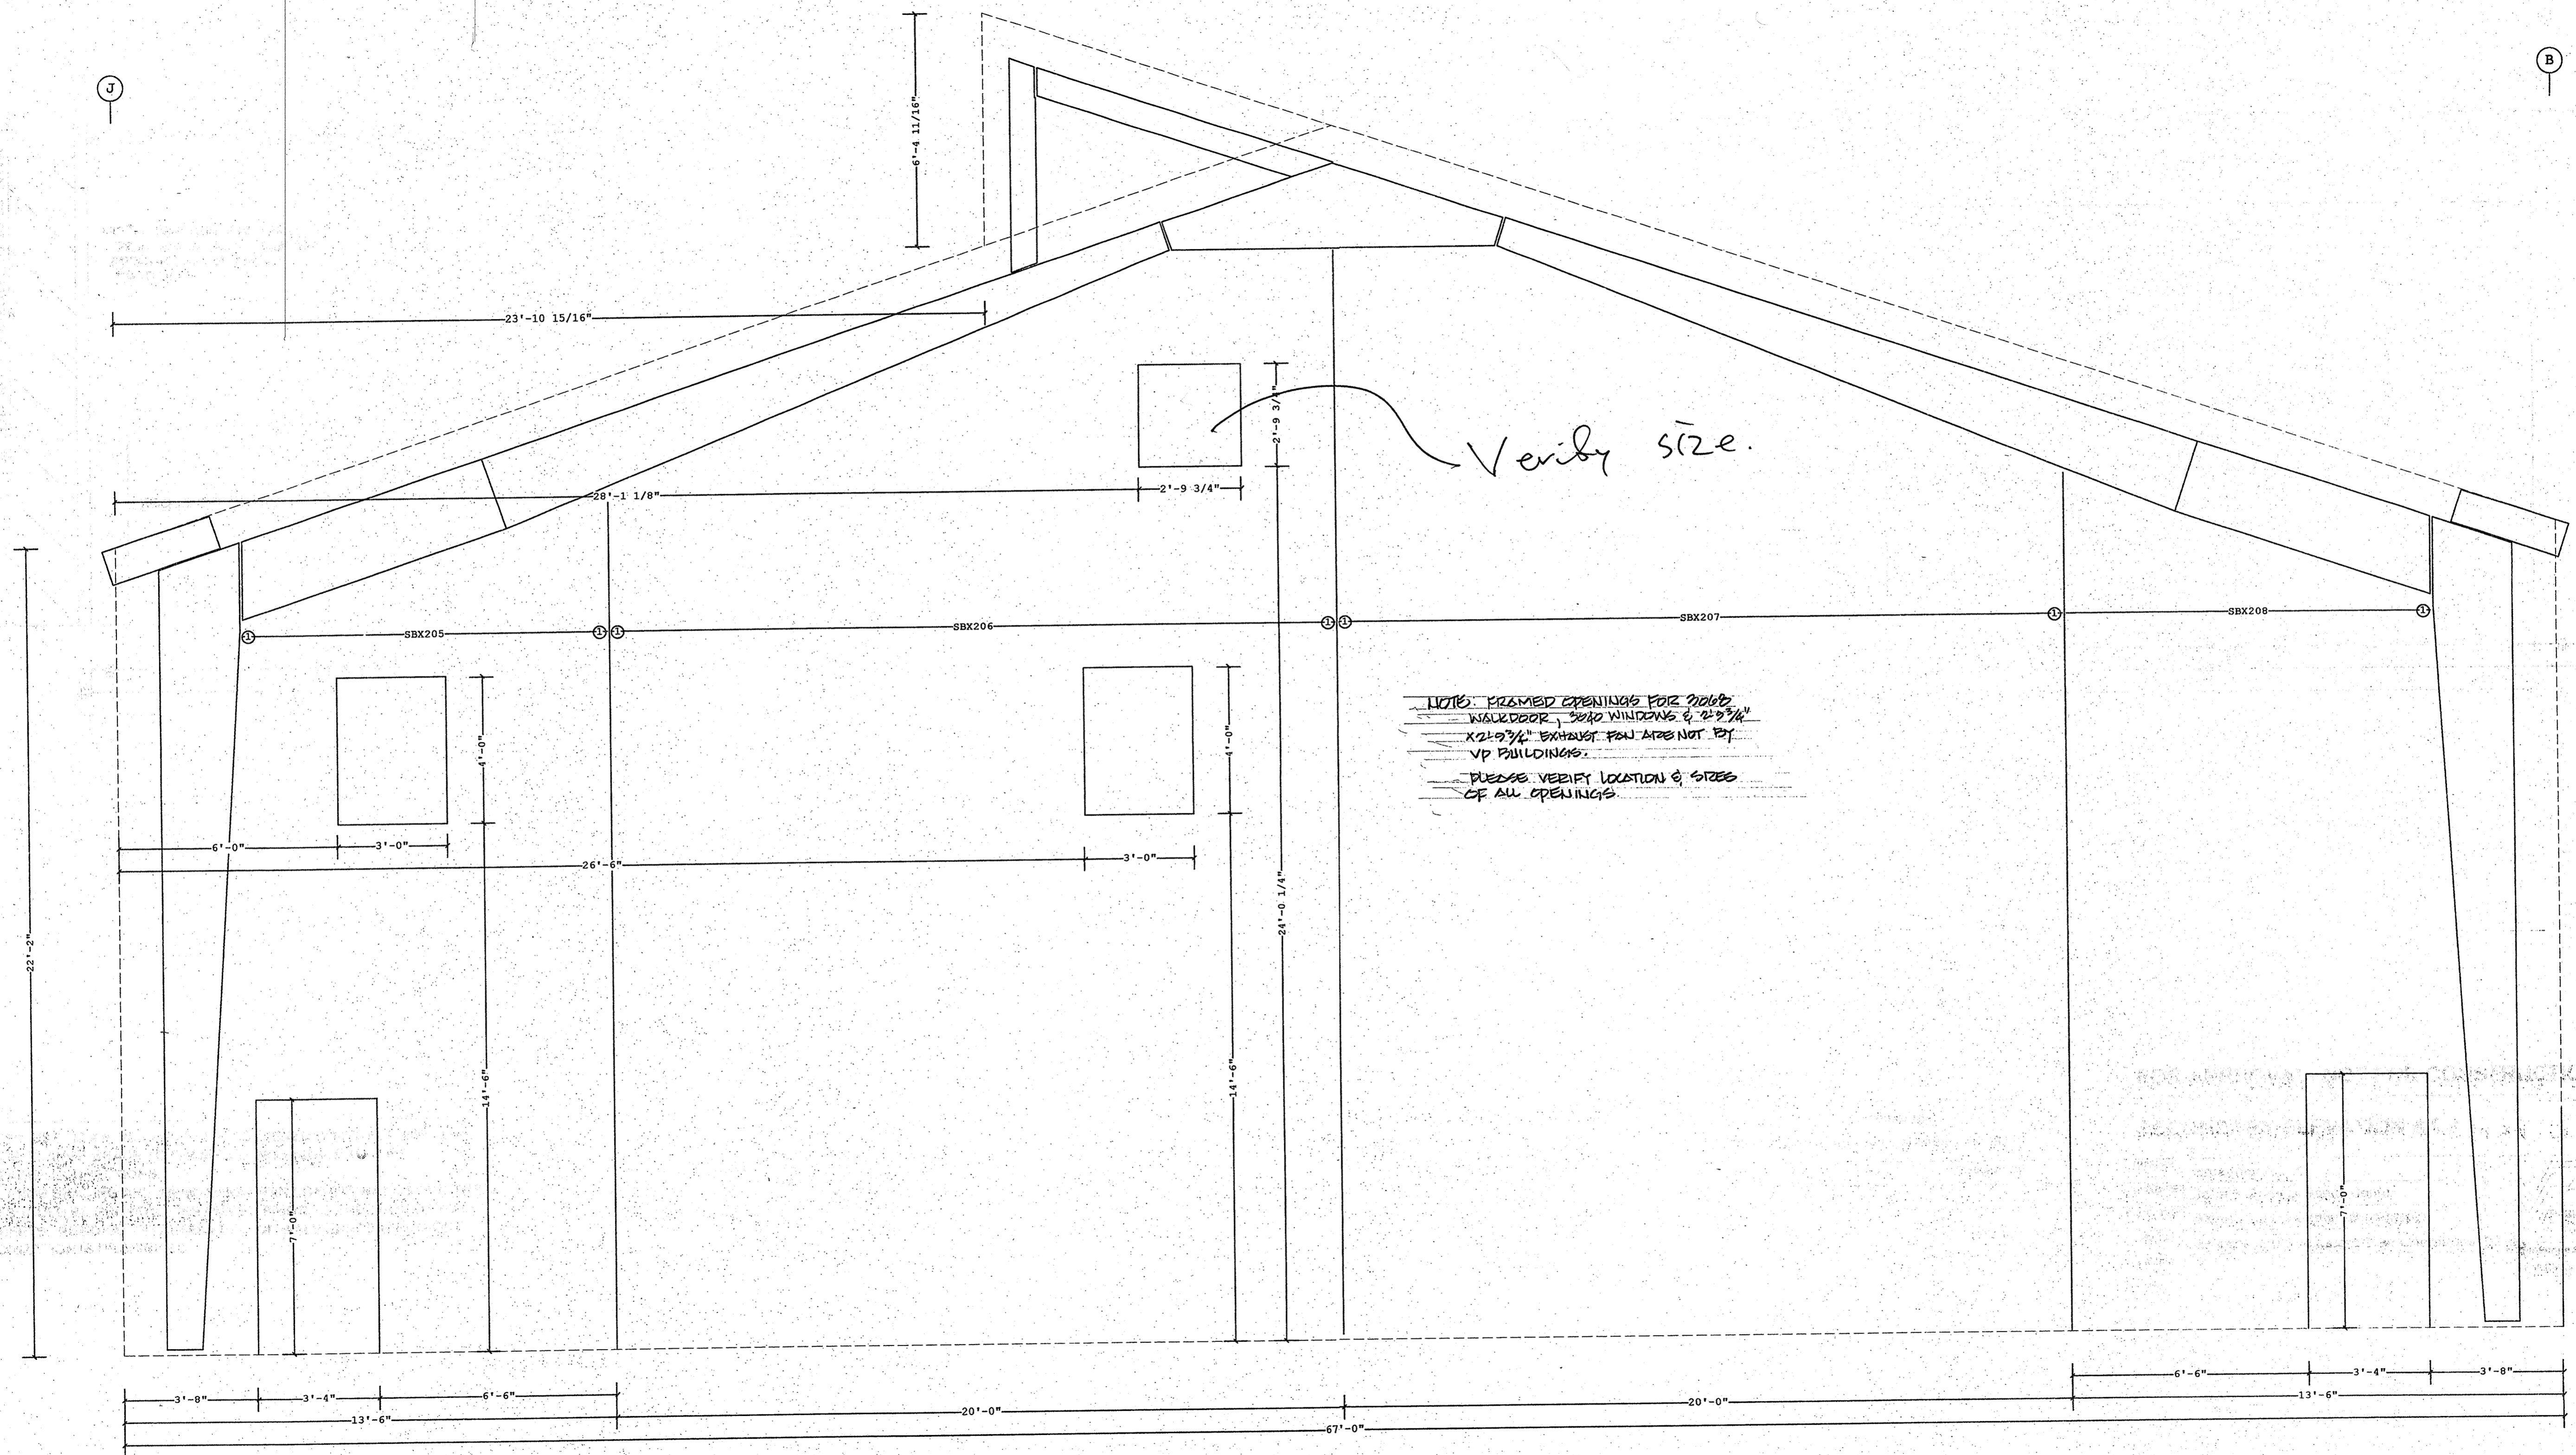

SECONDARY ELEVATION AT 14
Shape Name = Maintenance Area, Wall = 3

FOR APPROVAL- NOT FOR CONSTRUCTION

1. UNLESS NOTED, USE 1/2 X 1 1/2 A-325 SNUG TIGHTENED BOLTS FOR GIRT LAP, GIRT TO FRAME, FLANGE BRACE TO FRAME, FLANGE BRACE TO GIRT, JAMB AND HEADER CONNECTIONS.
2. WIND AND FLANGE BRACING ARE AN INTEGRAL PART OF THE WALL STRUCTURAL SYSTEM AND SHOULD BE PROPERLY INSTALLED PRIOR TO ERECTION OF WALL AND ROOF SHEETS. REMOVAL OR ALTERATION OF WALL BRACING WITHOUT PRIOR AUTHORIZATION IS PROHIBITED.

THE VP ENGINEER'S SEAL APPLIES ONLY TO THE WORK PRODUCT OF VP AND DESIGN AND PERFORMANCE REQUIREMENTS SPECIFIED BY VP. THE VP ENGINEER'S SEAL DOES NOT APPLY TO THE PERFORMANCE OR DESIGN OF ANY OTHER PRODUCT OR COMPONENT FURNISHED BY VP EXCEPT TO ANY DESIGN OR PERFORMANCE REQUIREMENTS SPECIFIED BY VP.

THIS DRAWING, INCLUDING THE INFORMATION HEREON, REMAINS THE PROPERTY OF VP BUILDINGS. IT IS PROVIDED SOLELY FOR ERECTING THE BUILDING DESCRIBED IN THE APPLICABLE PURCHASE ORDER AND SHALL NOT BE MODIFIED, REPRODUCED OR USED FOR ANY OTHER PURPOSE WITHOUT PRIOR WRITTEN APPROVAL OF VP BUILDINGS.

THE GENERAL CONTRACTOR AND/OR ERECTOR IS SOLELY RESPONSIBLE FOR ACCURATE, GOOD QUALITY WORKMANSHIP IN ERECTING THIS BUILDING IN CONFORMANCE WITH THIS DRAWING, DETAILS REFERENCED IN THIS DRAWING, ALL APPLICABLE VP ERECTION GUIDES, AND INDUSTRY STANDARDS PERTAINING TO PROPER ERECTION, INCLUDING THE CORRECT USE OF TEMPORARY BRACING.

VP Buildings			
3200 Players Club Circle Memphis TN 38125			
REV	DATE	BY	DESCRIPTION
NTS			

SECONDARY ELEVATION AT 14		VP BUILDINGS VARCO PRUDEN A BlueScope Steel Company VPC VERSION: 7.1c	JOBNO 08-28914 EP2 DATE 2/9/09 DRAWN/CHECK MLM PAGE 17
BUILDER	Broadmoor, LLC		
CUSTOMER	John F. Stennis Space Center		
LOCATION	Stennis Space Center, Mississippi		
PROJECT	Riverine and Combatant Craft Operations Facility		
BUILDERS PO#			
FILENAME:	08-28914 EP2 VPC		