
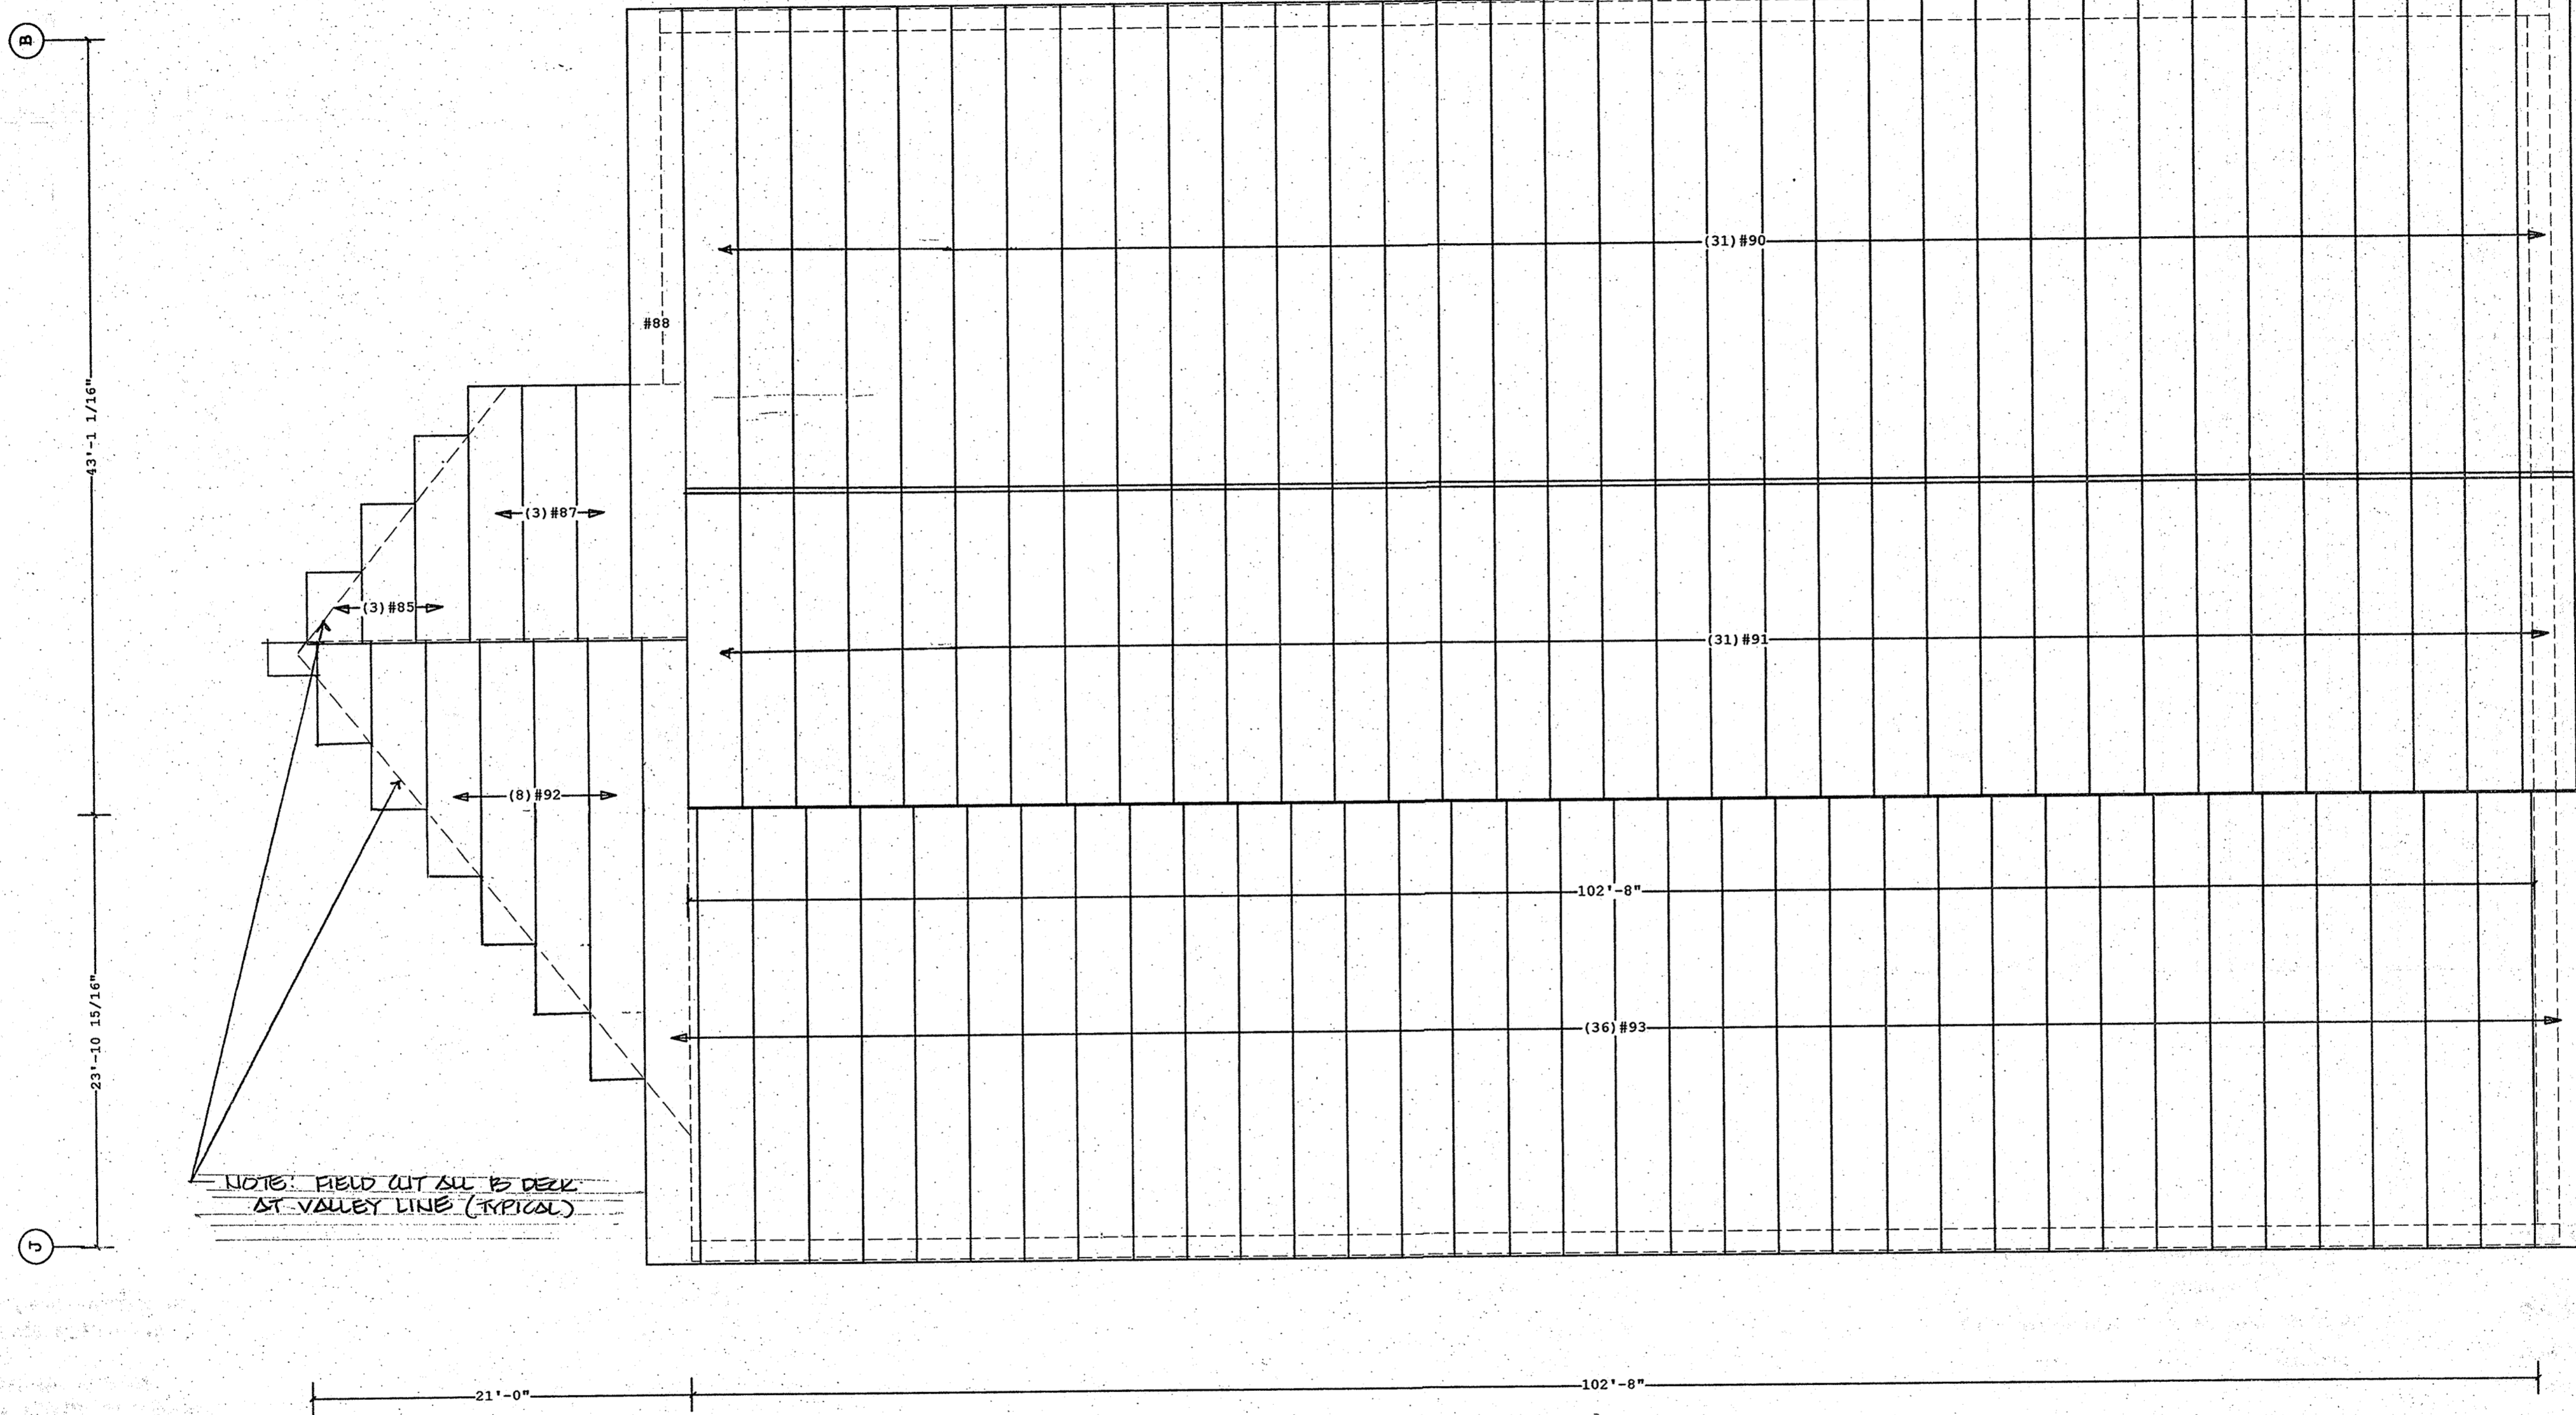


Id	Qty	Length	Type	Gage	OP	Fin.	Color	Direction
#85	3	4'-1 3/4"	B Deck 22	1	G	TD	TD	Left to Right
#87	3	14'-10 3/4"	B Deck 22	1	G	TD	TD	Left to Right
#88	1	36'-11"	B Deck 22	1	G	TD	TD	Left to Right
#89	4	46'-9 3/4"	B Deck 22	1	G	TD	TD	Left to Right
#90	31	28'-5 3/4"	B Deck 22	1	G	TD	TD	Left to Right
#91	31	18'-8 1/8"	B Deck 22	1	G	TD	TD	Left to Right
#92	4		B Deck 22	1	G	TD	TD	Left to Right
#93	36	26'-7 1/4"	B Deck 22	1	G	TD	TD	Left to Right

Oper. Code:1=SQ,SQ  
 Finish:G=G 60 Galvanized  
 Color:TD= Galvanized

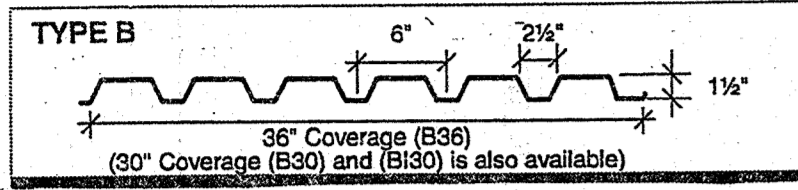

B DECK ROOF COVERING PLAN

- (Field Repair Fastener)  
 (1 bags) #55308 #17-14x1" S.S. Roof Fastener

☐ Dimension Key

- PRE-DRILLING 1/8 DIAMETER HOLES FOR ROOF STRUCTURAL FASTENERS MAY BE REQUIRED AT 11 GAGE PURLINS, NESTED PURLINS, PURLIN LAP LOCATIONS, AND/OR SECONDARY STRUCTURAL BEAMS
- ROOF SHEETS ARE AN INTEGRAL PART OF THE STRUCTURAL SYSTEM, REMOVAL OR ALTERATION WITHOUT PRIOR AUTHORIZATION IS PROHIBITED.
- PANELS SHOWN WITH A LENGTH LESS THAN 1-0, 5-0 FOR SSR, MAY HAVE TO BE FIELD CUT.
- SEE JOB DETAILS FOR SHEETING AND TRIM FASTENER SPECIFICATION.

THE VP ENGINEER'S SEAL APPLIES ONLY TO THE WORK PRODUCT OF VP AND DESIGN AND PERFORMANCE REQUIREMENTS SPECIFIED BY VP. THE VP ENGINEER'S SEAL DOES NOT APPLY TO THE PERFORMANCE OR DESIGN OF ANY OTHER PRODUCT OR COMPONENT FURNISHED BY VP EXCEPT TO ANY DESIGN OR PERFORMANCE REQUIREMENTS SPECIFIED BY VP.


THIS DRAWING, INCLUDING THE INFORMATION HEREON, REMAINS THE PROPERTY OF VP BUILDINGS. IT IS PROVIDED SOLELY FOR ERECTING THE BUILDING DESCRIBED IN THE APPLICABLE PURCHASE ORDER AND SHALL NOT BE MODIFIED, REPRODUCED OR USED FOR ANY OTHER PURPOSE WITHOUT PRIOR WRITTEN APPROVAL OF VP BUILDINGS. THE GENERAL CONTRACTOR AND/OR ERECTOR IS SOLELY RESPONSIBLE FOR ACCURATE, GOOD QUALITY WORKMANSHIP IN ERECTING THIS BUILDING IN CONFORMANCE WITH THIS DRAWING, DETAILS REFERENCED IN THIS DRAWING, ALL APPLICABLE VP ERECTION GUIDES, AND INDUSTRY STANDARDS PERTAINING TO PROPER ERECTION, INCLUDING THE CORRECT USE OF TEMPORARY BRACING.

VP Buildings			
3200 Players Club Circle Memphis TN 38125			
REV	DATE	BY	DESCRIPTION
NTS			

FOR APPROVAL- NOT FOR CONSTRUCTION

B DECK ROOF COVERING PLAN

BUILDER	Broadmoor, LLC
CUSTOMER	John F. Stennis Space Center
LOCATION	Stennis Space Center, Mississippi
PROJECT	Riverins and Combatant Craft Operations Facility
BUILDERS PO#	

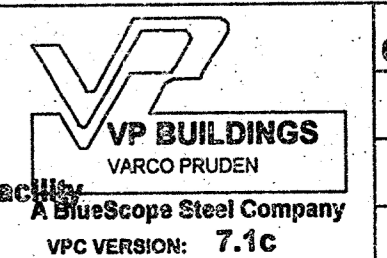

JOBNO	09-28914 EP2
DATE	2/9/2009
DRAWN/CHECK	MWM
PAGE	21