

Covering Schedule
 Id Qty Type Length Gage OP Fin. Color Direction
 #14 34 FP12 TBD TBD 1 A TBD Left to Right From Peak
 #16 34 FP12 TBD TBD 1 A TBD Left to Right From Peak
 Oper. Code:1=SQ,SQ
 Finish:A=AEP
 Color:TBD=To Be Determined
 NOTE: Panels to be FIELD SLOPE CUT


Trim Schedule
 Id Parts Color
 T1 HEADER TRIM TBD
 T2 SILL TRIM TBD
 T3 CORNER TRIM TBD
 T4 PURLIN CLOSURES & TRIM TBD
 T5 JAMB TRIM TBD
 T6 BOTTOM OF PANEL FLASHING TBD

Details
 WC24A2 (Similar)
 See pg.
 RC80A2, RC80A3, RC80C1, RC80C4, RC80D4, WC12A1 (Similar)
 WC24A1 (Similar)

FP12 FLUSH PANEL

Stiffening ribs are not required on the FP12 panel up to the maximum length of 30'. It is always recommended to use stiffening ribs on FP12 panel with lengths over 15'-0" to reduce the possibility of oil canning or unevenness of the flat surfaces of the panel. Oil canning is an inherent characteristic of steel products, not a defect, and therefore is not a cause for panel rejection.

PLEASE VERIFY
 1. Panel color
 2. Trim color

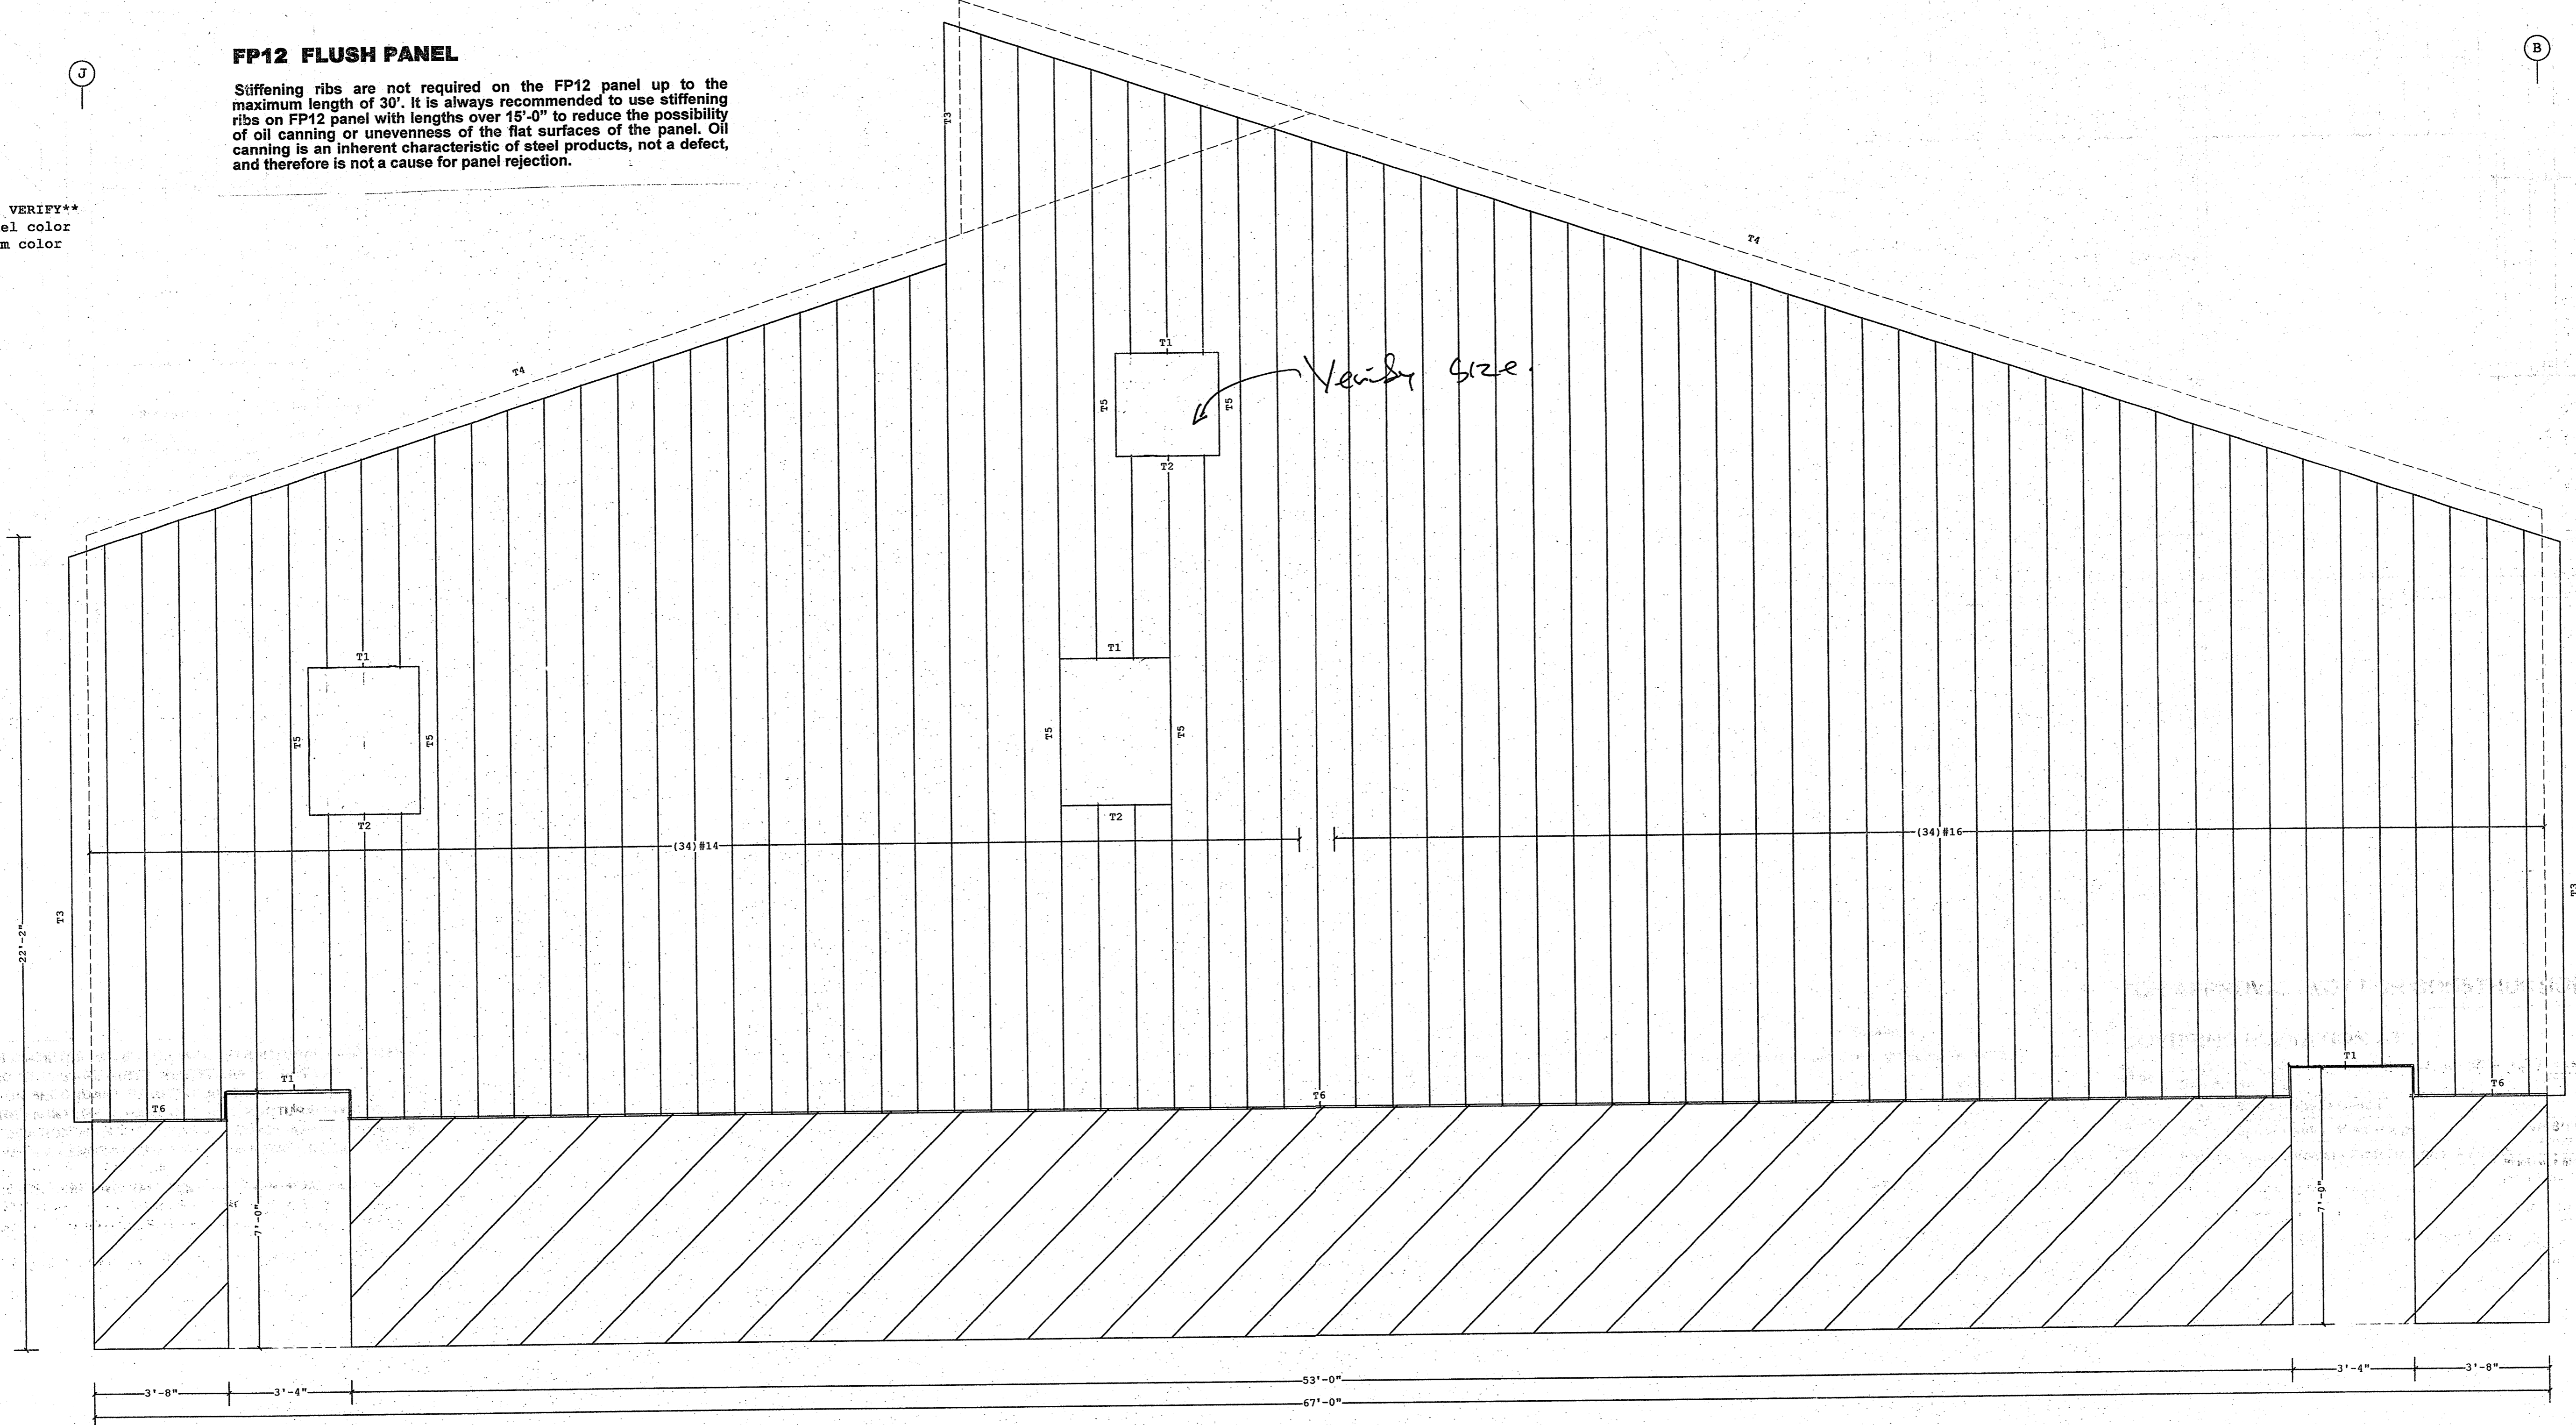

COVERING ELEVATION AT 14

Shape Name = Maintenance Area, Wall = 3

FOR APPROVAL- NOT FOR CONSTRUCTION

- PRE-DRILLING 1/8 DIAMETER HOLES FOR WALL STRUCTURAL FASTENERS MAY BE REQUIRED AT 11 GAGE GIRTS, NESTED GIRTS, GIRT LAP LOCATIONS, AND/OR SECONDARY STRUCTURAL BEAMS
- WALL SHEETS ARE AN INTEGRAL PART OF THE STRUCTURAL SYSTEM, REMOVAL OR ALTERATION WITHOUT PRIOR AUTHORIZATION IS PROHIBITED.
- PANELS SHOWN WITH A LENGTH LESS THAN 1-0, 5-0 FOR SSR, MAY HAVE TO BE FIELD CUT.
- SEE JOB DETAILS FOR SHEETING AND TRIM FASTENER SPECIFICATION.

THE VP ENGINEER'S SEAL APPLIES ONLY TO THE WORK PRODUCT OF VP AND DESIGN AND PERFORMANCE REQUIREMENTS SPECIFIED BY VP. THE VP ENGINEER'S SEAL DOES NOT APPLY TO THE PERFORMANCE OR DESIGN OF ANY OTHER PRODUCT OR COMPONENT FURNISHED BY VP EXCEPT TO ANY DESIGN OR PERFORMANCE REQUIREMENTS SPECIFIED BY VP.

THIS DRAWING, INCLUDING THE INFORMATION HEREON, REMAINS THE PROPERTY OF VP BUILDINGS. IT IS PROVIDED SOLELY FOR ERECTING THE BUILDING DESCRIBED IN THE APPLICABLE PURCHASE ORDER AND SHALL NOT BE MODIFIED, REPRODUCED OR USED FOR ANY OTHER PURPOSE WITHOUT PRIOR WRITTEN APPROVAL OF VP BUILDINGS.

THE GENERAL CONTRACTOR AND/OR ERECTOR IS SOLELY RESPONSIBLE FOR ACCURATE, GOOD QUALITY WORKMANSHIP IN ERECTING THIS BUILDING IN CONFORMANCE WITH THIS DRAWING, DETAILS REFERENCED IN THIS DRAWING, ALL APPLICABLE VP ERECTION GUIDES, AND INDUSTRY STANDARDS PERTAINING TO PROPER ERECTION, INCLUDING THE CORRECT USE OF TEMPORARY BRACING.

VP Buildings
 3200 Players Club Circle Memphis TN 38125

REV	DATE	BY	DESCRIPTION

NTS

COVERING ELEVATION AT 14

BUILDER	Broadmoor, LLC
CUSTOMER	John F. Stennis Space Center
LOCATION	Stennis Space Center, Mississippi
PROJECT	Riverine and Combatant Craft Operations Facility
BUILDERS POC	

VP BUILDINGS
 VARCO PRUDEN
 A BlueScope Steel Company
 VPC VERSION: 7.1c

JOBNO	08-28914 EP2
DATE	2/9/09
DRAWN/CHECK	MWM
PAGE	26