


Covering Schedule

Id	Qty	Type	Length	Gage	OP	Fin.	Color	Direction
#19	37	FP12	TBD	TBD	1	A	TBD	Left to Right
#20	8	FP12	TBD	TBD	1	A	TBD	Left to Right
#21	55	FP12	TBD	TBD	1	A	TBD	Left to Right

Oper. Code: 1=SQ, SQ
Finish: A=AEP
Color: TBD=To Be Determined

Trim Schedule	Color	Details
T1 INSIDE CORNER	TBD	See pg.
T2 BOTTOM OF PANEL FLASHING	TBD	WC24A1 (Similar)
T3 JAMB TRIM	TBD	RC38F1
T4 DOWNSPOUTS	TBD	WC11A1 (Similar), WC11A4 (Similar)
T5 TOP OF PANEL @ CANOPY	TBD	WC24A2 (Similar)
T6 HEADER TRIM	TBD	

****PLEASE VERIFY****
1. Panel color
2. Trim color

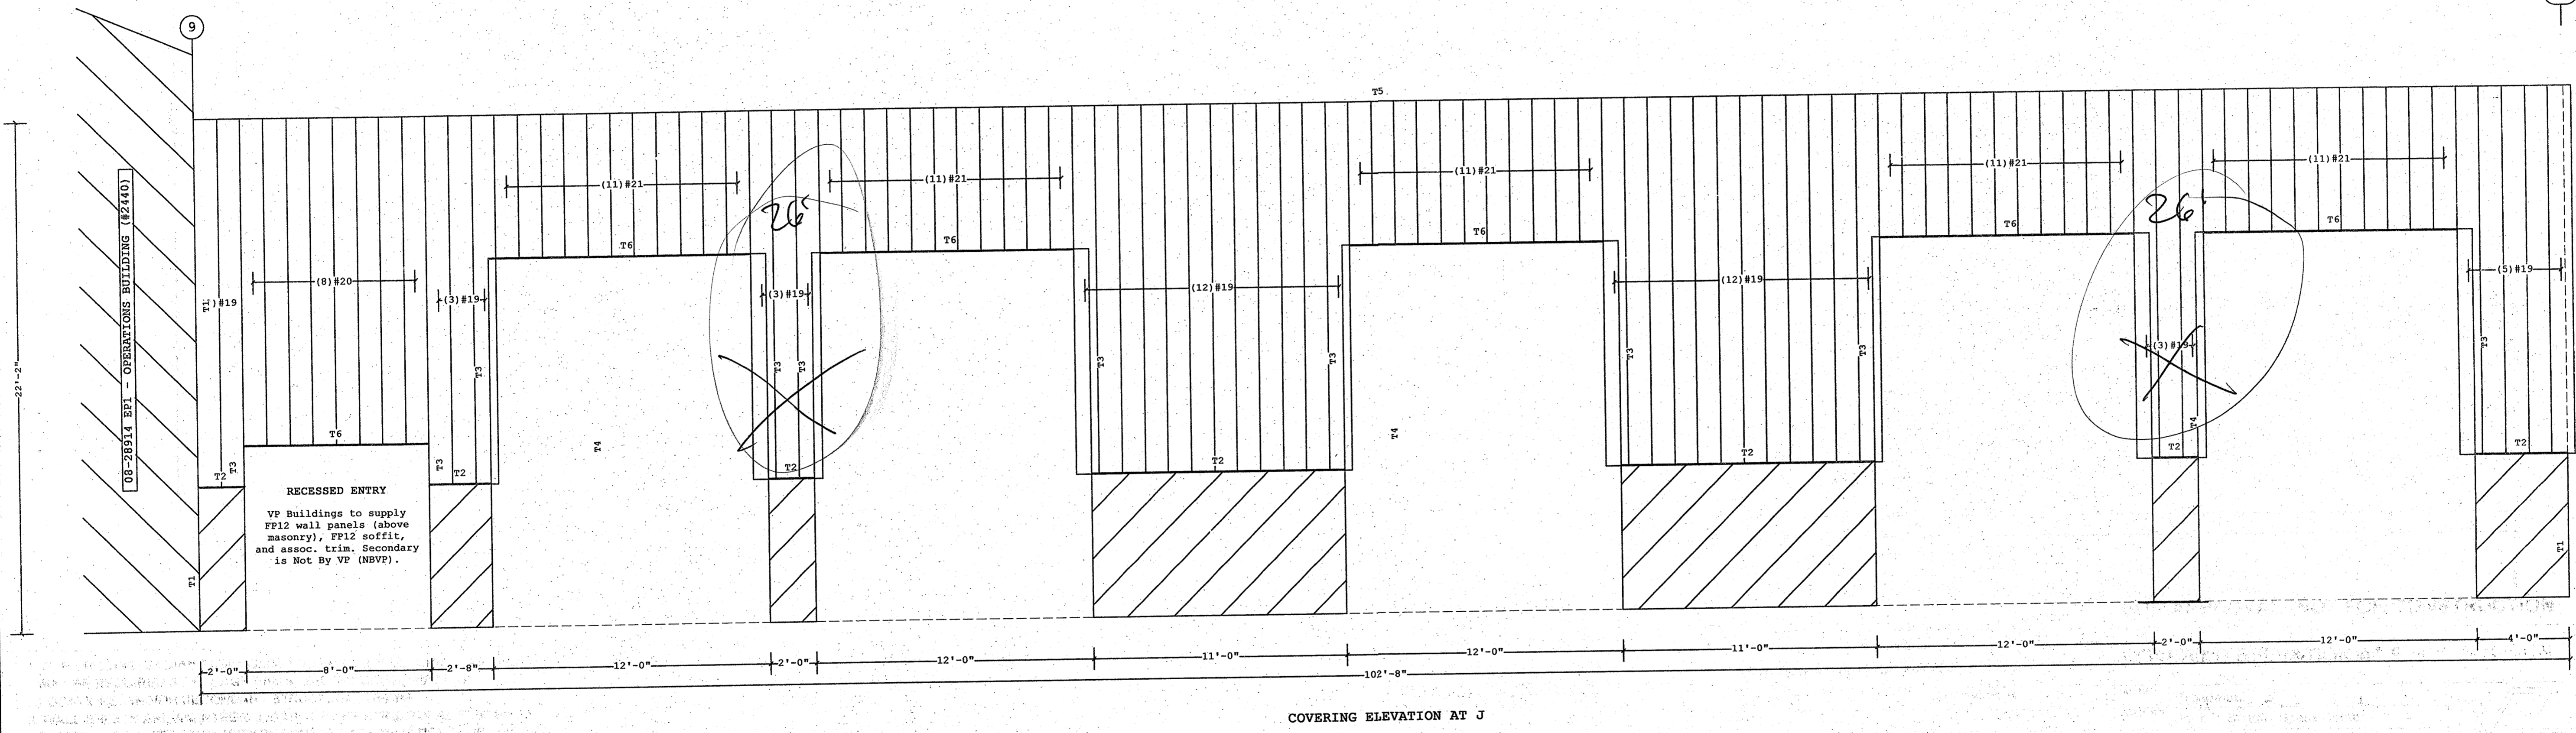

14

FOR APPROVAL - NOT FOR CONSTRUCTION

- PRE-DRILLING 1/8 DIAMETER HOLES FOR WALL STRUCTURAL FASTENERS MAY BE REQUIRED AT 11 GAGE GIRTS, NESTED GIRTS, GIRT LAP LOCATIONS, AND/OR SECONDARY STRUCTURAL BEAMS
- WALL SHEETS ARE AN INTEGRAL PART OF THE STRUCTURAL SYSTEM. REMOVAL OR ALTERATION WITHOUT PRIOR AUTHORIZATION IS PROHIBITED.
- PANELS SHOWN WITH A LENGTH LESS THAN 1-0, 5-0 FOR SSR, MAY HAVE TO BE FIELD CUT.
- SEE JOB DETAILS FOR SHEETING AND TRIM FASTENER SPECIFICATION.

THE VP ENGINEER'S SEAL APPLIES ONLY TO THE WORK PRODUCT OF VP AND DESIGN AND PERFORMANCE REQUIREMENTS SPECIFIED BY VP. THE VP ENGINEER'S SEAL DOES NOT APPLY TO THE PERFORMANCE OR DESIGN OF ANY OTHER PRODUCT OR COMPONENT FURNISHED BY VP EXCEPT TO ANY DESIGN OR PERFORMANCE REQUIREMENTS SPECIFIED BY VP.

Shape Name = Maintenance Area, Wall = 4

THIS DRAWING, INCLUDING THE INFORMATION HEREON, REMAINS THE PROPERTY OF VP BUILDINGS. IT IS PROVIDED SOLELY FOR ERECTING THE BUILDING DESCRIBED IN THE APPLICABLE PURCHASE ORDER AND SHALL NOT BE MODIFIED, REPRODUCED OR USED FOR ANY OTHER PURPOSE WITHOUT PRIOR WRITTEN APPROVAL OF VP BUILDINGS.

THE GENERAL CONTRACTOR AND/OR ERECTOR IS SOLELY RESPONSIBLE FOR ACCURATE, GOOD QUALITY WORKMANSHIP IN ERECTING THIS BUILDING IN CONFORMANCE WITH THIS DRAWING, DETAILS REFERENCED IN THIS DRAWING, ALL APPLICABLE VP ERECTION GUIDES, AND INDUSTRY STANDARDS PERTAINING TO PROPER ERECTION, INCLUDING THE CORRECT USE OF TEMPORARY BRACING.

VP Buildings			
3200 Players Club Circle Memphis TN 38125			
REV	DATE	BY	DESCRIPTION
NTS			

COVERING ELEVATION AT J		 VP BUILDINGS VARCO PRUDEN A BlueScope Steel Company VPC VERSION: 7.1C	JOBNO 08-28914 EP2 DATE 2/9/09 DRAWN/CHECK MWM PAGE 27
BUILDER	Broadmoor, LLC		
CUSTOMER	John F. Stennis Space Center		
LOCATION	Stennis Space Center, Mississippi		
PROJECT	Riverine and Combatant Craft Operations Facility		
BUILDERS PO#			
FILENAME:	08-28914 EP2 VPC		