

Part Mark Key

- 1 GCC072084
- 2 H300
- 3 J322
- 4 H301
- 5 G386
- 6 GFA200
- 7 GFA106

Secondary Part Schedule


| Mark | Part | Thick. | Depth | Lap |
|------|-------------|--------|--------|-------|
| G330 | 42G2410416 | 0.0650 | 8 1/2" | 2'-0" |
| G331 | 44G2507517 | 0.0590 | 8 1/2" | 3'-0" |
| G332 | 40G1400317 | 0.0590 | 8 1/2" | 1'-0" |
| G361 | 40G1708017 | 0.0590 | 8 1/2" | 1'-0" |
| G374 | 44G2505014 | 0.0820 | 8 1/2" | 3'-0" |
| G375 | 42G2405016 | 0.0650 | 8 1/2" | 2'-0" |
| G376 | 44G2505015 | 0.0730 | 8 1/2" | 3'-0" |
| G377 | 44G2505016 | 0.0650 | 8 1/2" | 3'-0" |
| G386 | 01G0110017 | 0.0590 | 8 1/2" | |
| H300 | DH0304417 | 0.0590 | 8 1/2" | |
| H301 | DH0209617 | 0.0590 | 8 1/2" | |
| J321 | 001J1002017 | 0.0590 | 8 1/2" | |
| J322 | 002J0304417 | 0.0590 | 8 1/2" | |

Frame Member Schedule

| Part | Width | Thick. | Webthk | Depth | Approx. Lgth |
|---------|------------|--------|--------|-------|--------------|
| PCCX353 | CH9 x 13.4 | | | 9" | 1'-10 1/2" |
| PCCX354 | CH9 x 13.4 | | | 9" | 18'-9" |
| PCCX355 | CH9 x 13.4 | | | 9" | 25'-4 1/2" |

Framed Opening Locations

| Id | Width | Height | Sill Ht. | Frame | To | Dimen. |
|-----|-----------|-----------|------------|-------|--------|--------|
| FO1 | 2'-9 3/4" | 2'-9 3/4" | 23'-0 7/8" | 1 | Jamb-L | 1'-6" |

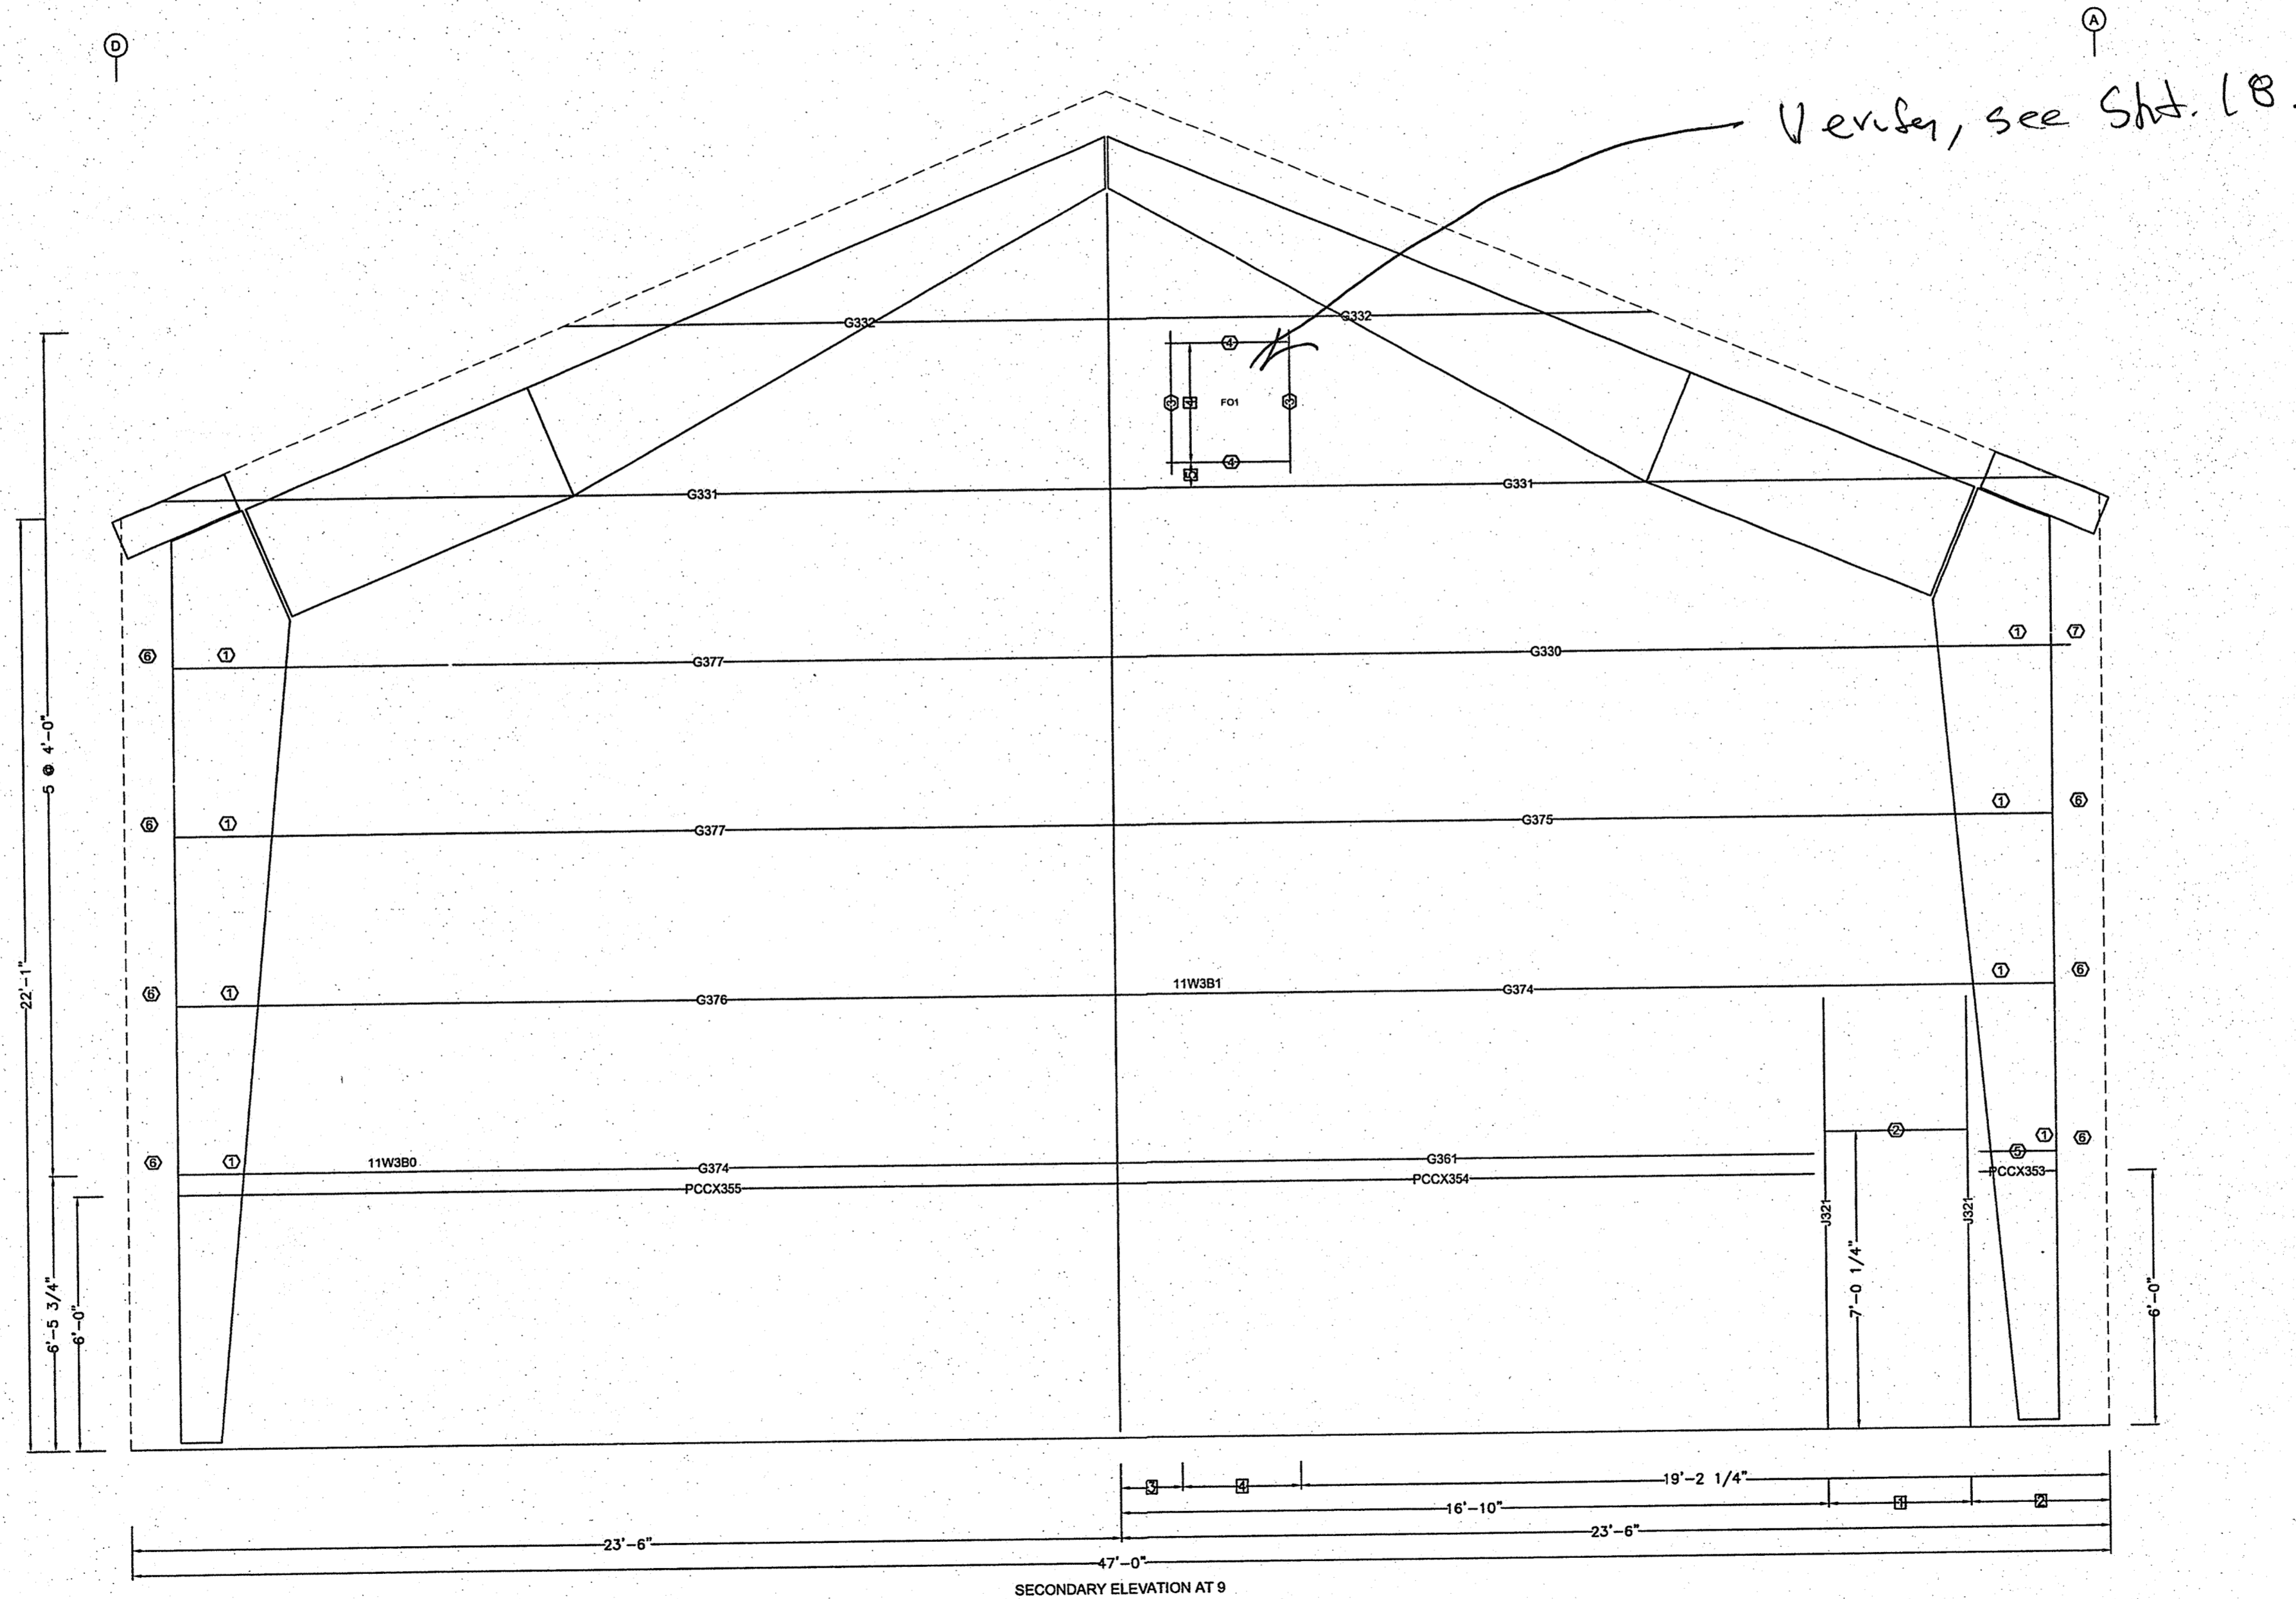

- 5 7 1/8"
- 4 2'-9 3/4"
- 3 1'-6"
- 2 3'-3 1/2"
- 1 3'-4 1/2"

Dimension Key

- UNLESS NOTED, USE 1/2 X 1 1/2 A-325 SNUG TIGHTENED BOLTS FOR GIRT LAP, GIRT TO FRAME, FLANGE BRACE TO FRAME, FLANGE BRACE TO GIRT, JAMB AND HEADER CONNECTIONS.
- WIND AND FLANGE BRACING ARE AN INTEGRAL PART OF THE WALL STRUCTURAL SYSTEM AND SHOULD BE PROPERLY INSTALLED PRIOR TO ERECTION OF WALL AND ROOF SHEETS. REMOVAL OR ALTERATION OF WALL BRACING WITHOUT PRIOR AUTHORIZATION IS PROHIBITED.

THE VP ENGINEER'S SEAL APPLIES ONLY TO THE WORK PRODUCT OF VP AND DESIGN AND PERFORMANCE REQUIREMENTS SPECIFIED BY VP. THE VP ENGINEER'S SEAL DOES NOT APPLY TO THE PERFORMANCE OR DESIGN OF ANY OTHER PRODUCT OR COMPONENT FURNISHED BY VP EXCEPT TO ANY DESIGN OR PERFORMANCE REQUIREMENTS SPECIFIED BY VP.

THIS DRAWING, INCLUDING THE INFORMATION HEREON, REMAINS THE PROPERTY OF VP BUILDINGS. IT IS PROVIDED SOLELY FOR ERECTING THE BUILDING DESCRIBED IN THE APPLICABLE PURCHASE ORDER AND SHALL NOT BE MODIFIED, REPRODUCED OR USED FOR ANY OTHER PURPOSE WITHOUT PRIOR WRITTEN APPROVAL OF VP BUILDINGS.

THE GENERAL CONTRACTOR AND/OR ERECTOR IS SOLELY RESPONSIBLE FOR ACCURATE, GOOD QUALITY WORKMANSHIP IN ERECTING THIS BUILDING IN CONFORMANCE WITH THIS DRAWING, DETAILS REFERENCED IN THIS DRAWING, ALL APPLICABLE VP ERECTION GUIDES, AND INDUSTRY STANDARDS PERTAINING TO PROPER ERECTION, INCLUDING THE CORRECT USE OF TEMPORARY BRACING.

VP Buildings, Inc.
3200 Players Club Circle Memphis TN 38125

| REV | DATE | BY | DESCRIPTION |
|-----|------|----|-------------|
| | | | |

NTS

| | |
|--------------|---|
| BUILDER | Broadmoor, LLC |
| CUSTOMER | John F. Stennis Space Center |
| LOCATION | Stennis Space Center, Mississippi |
| PROJECT | Riverine and Combatant Craft Operations |
| BUILDERS PO# | |

FOR APPROVAL - NOT FOR CONSTRUCTION

SECONDARY ELEVATION AT 9

| | |
|-------------|----------|
| JOBNO | 08-28914 |
| DATE | 2/3/2009 |
| DRAWN/CHECK | RAI |
| PAGE | 20 |

