

DAMMON ENGINEERING, INC.

CHIEF ENGINEER
EMMETT DAMMON, P.E.

CHIEF ARCHITECT
ROBERT WILTSE

1095 FLORIDA AVENUE
SUDELL, LA. 70458
OFFICE: 985-649-5832
FAX: 985-641-5950

WEBSITE:
WWW.DAMMONENGINEERING.COM

EMAIL:
DAMMONENG@BELLSOUTH.NET

ARCHITECTURE
ENGINEERING
STUDIES
PLANNING
INVESTIGATION
EXPERT WITNESS

SOUTHEAST
LOUISIANA
VETERANS
HEALTH CARE
SYSTEM

SITE
PLAN

REV:

SCALE: AS NOTED

JOB#: 2009

DATE: 02-03-09

SHEET 2

C-2

OF 14


PARKING REQUIREMENTS:

- 1 SPACE PER 350 SQ.FT. OF OFFICE SPACE
- 1 SPACE PER 750 SQ.FT. OF WAREHOUSE SPACE
- TOTAL REQUIRED=160
- TOTAL PROVIDED=162

LEGEND:


- PROPERTY LINE
- SETBACK LINE
- NEW BUILDING
- CLASS "A" TREE-MINIMUM OF 10' TO 12' HIGH. CALIPER OF 2-1/2" MEASURED AT 1-1/2 FT ABOVE THE GROUND
- CLASS "B" TREE-MINIMUM OF 8' TO 10' HIGH. CALIPER OF 1-1/2" MEASURED AT 1-1/2 FT ABOVE THE GROUND
- SHRUB

U.S. INTERSTATE HWY. 12

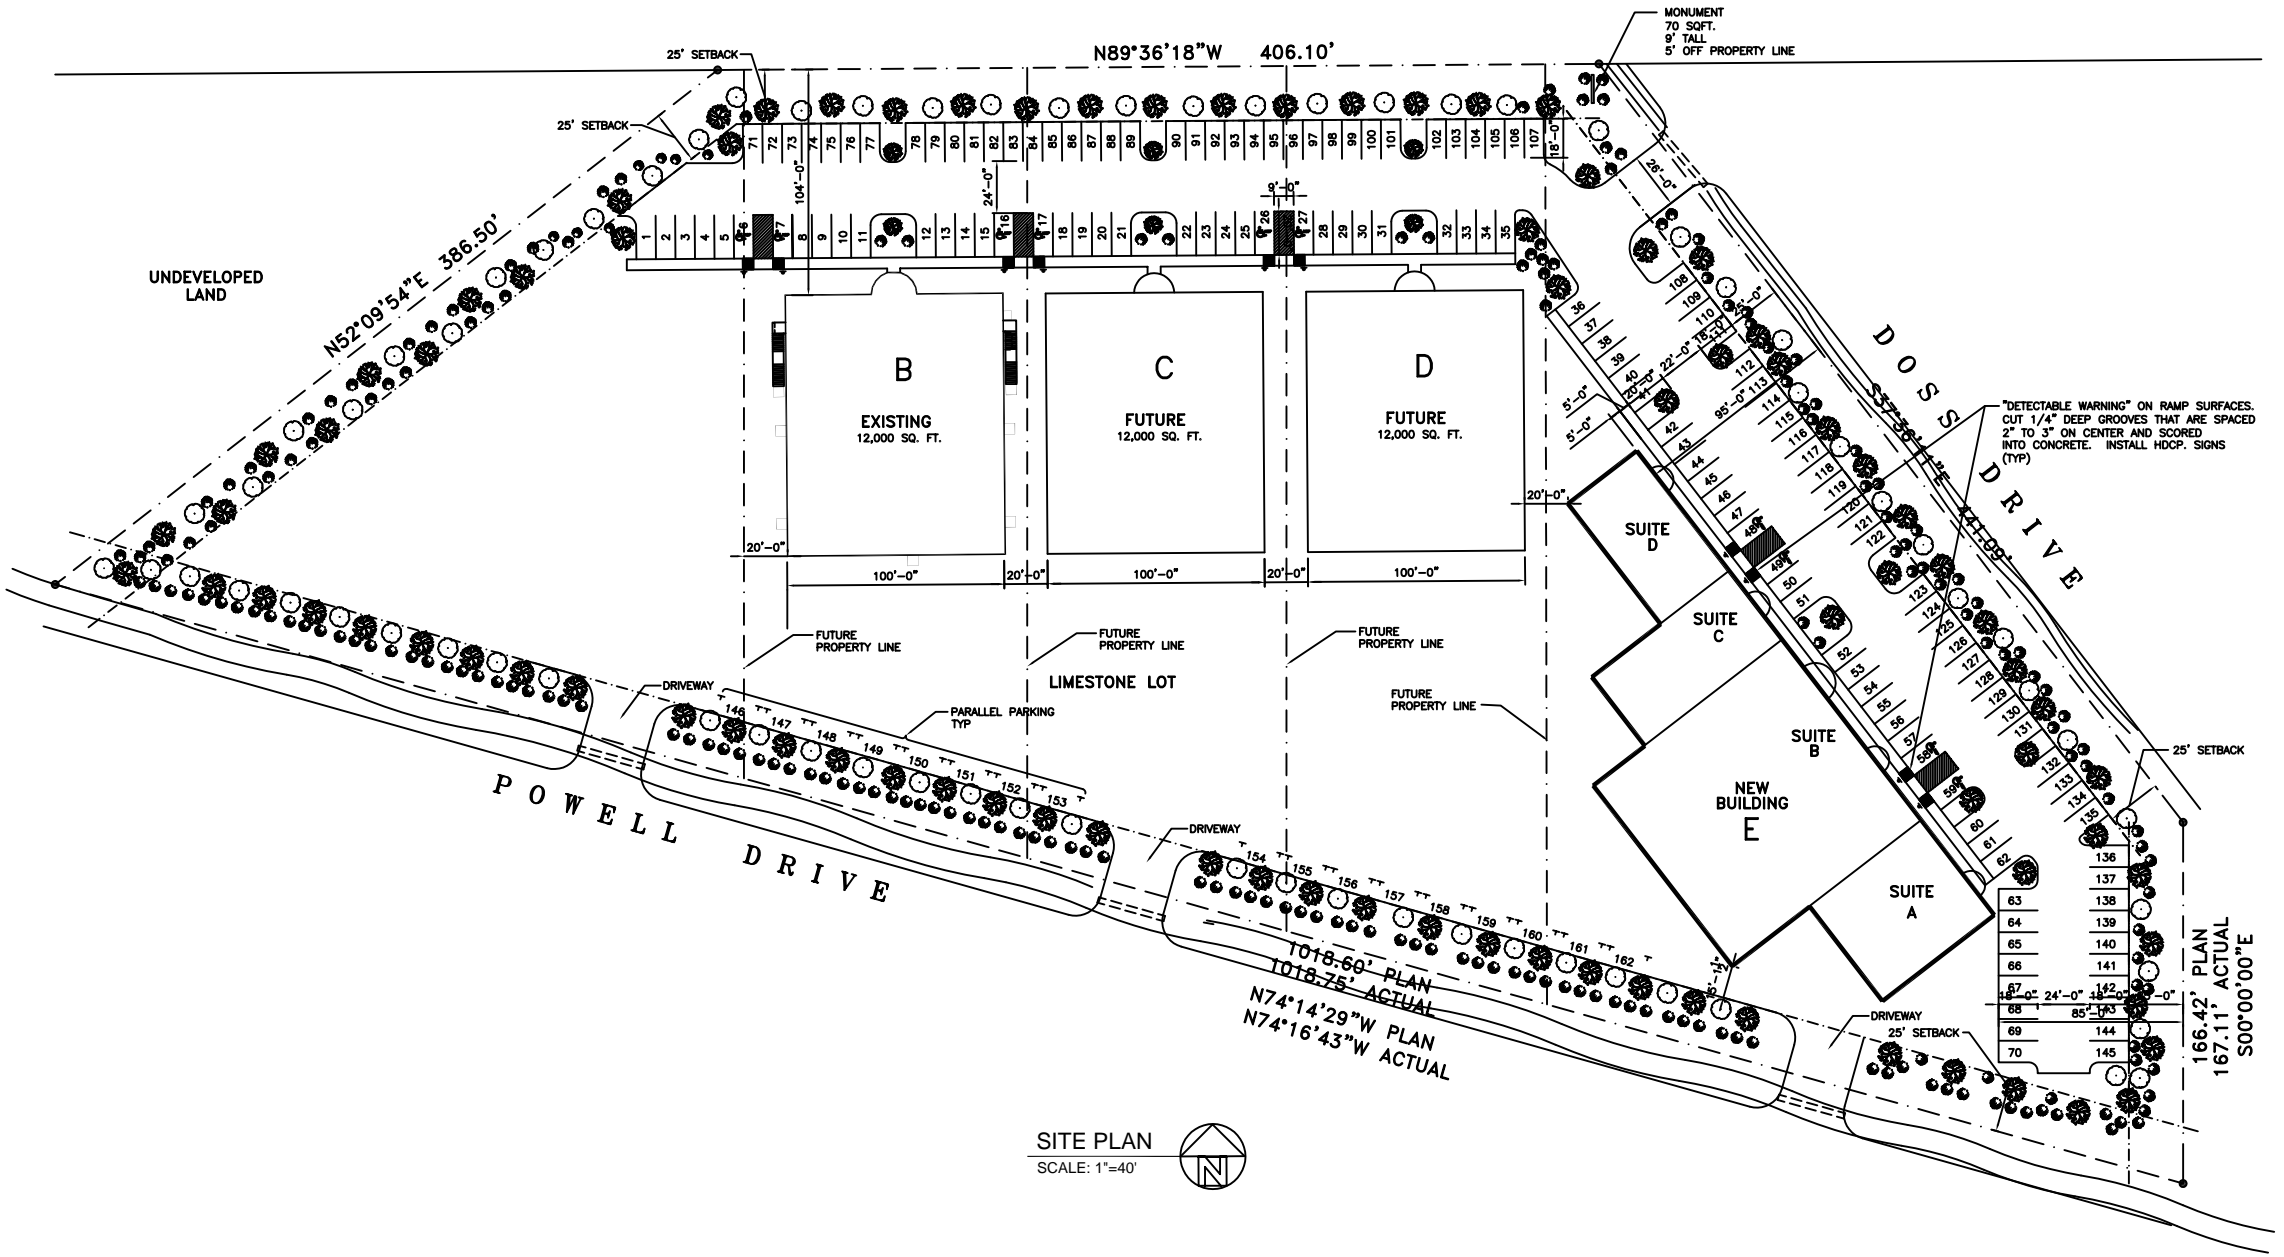

SITE PLAN
SCALE: 1"=40'



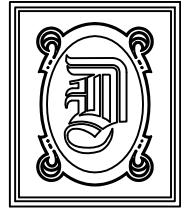

DAMMON ENGINEERING, INC.

CHIEF ENGINEER
EMMETT DAMMON, P.E.

CHIEF ARCHITECT
ROBERT WILTSE

1095 FLORIDA AVENUE
SLIDELL, LA. 70458
OFFICE: 985-649-5832
FAX: 985-641-5950

WEBSITE:
WWW.DAMMONENGINEERING.COM

EMAIL:
DAMMONENG@BELLSOUTH.NET

- ARCHITECTURE
- ENGINEERING
- STUDIES
- PLANNING
- INVESTIGATION
- EXPERT WITNESS

SOUTHEAST LOUISIANA VETERAN'S HEALTH CARE SYSTEM

UNIT B FLOOR PLAN

REV:

SCALE: AS NOTED


JOB#: 2009

DATE: 02-03-09


SHEET 4

A-1

OF 14

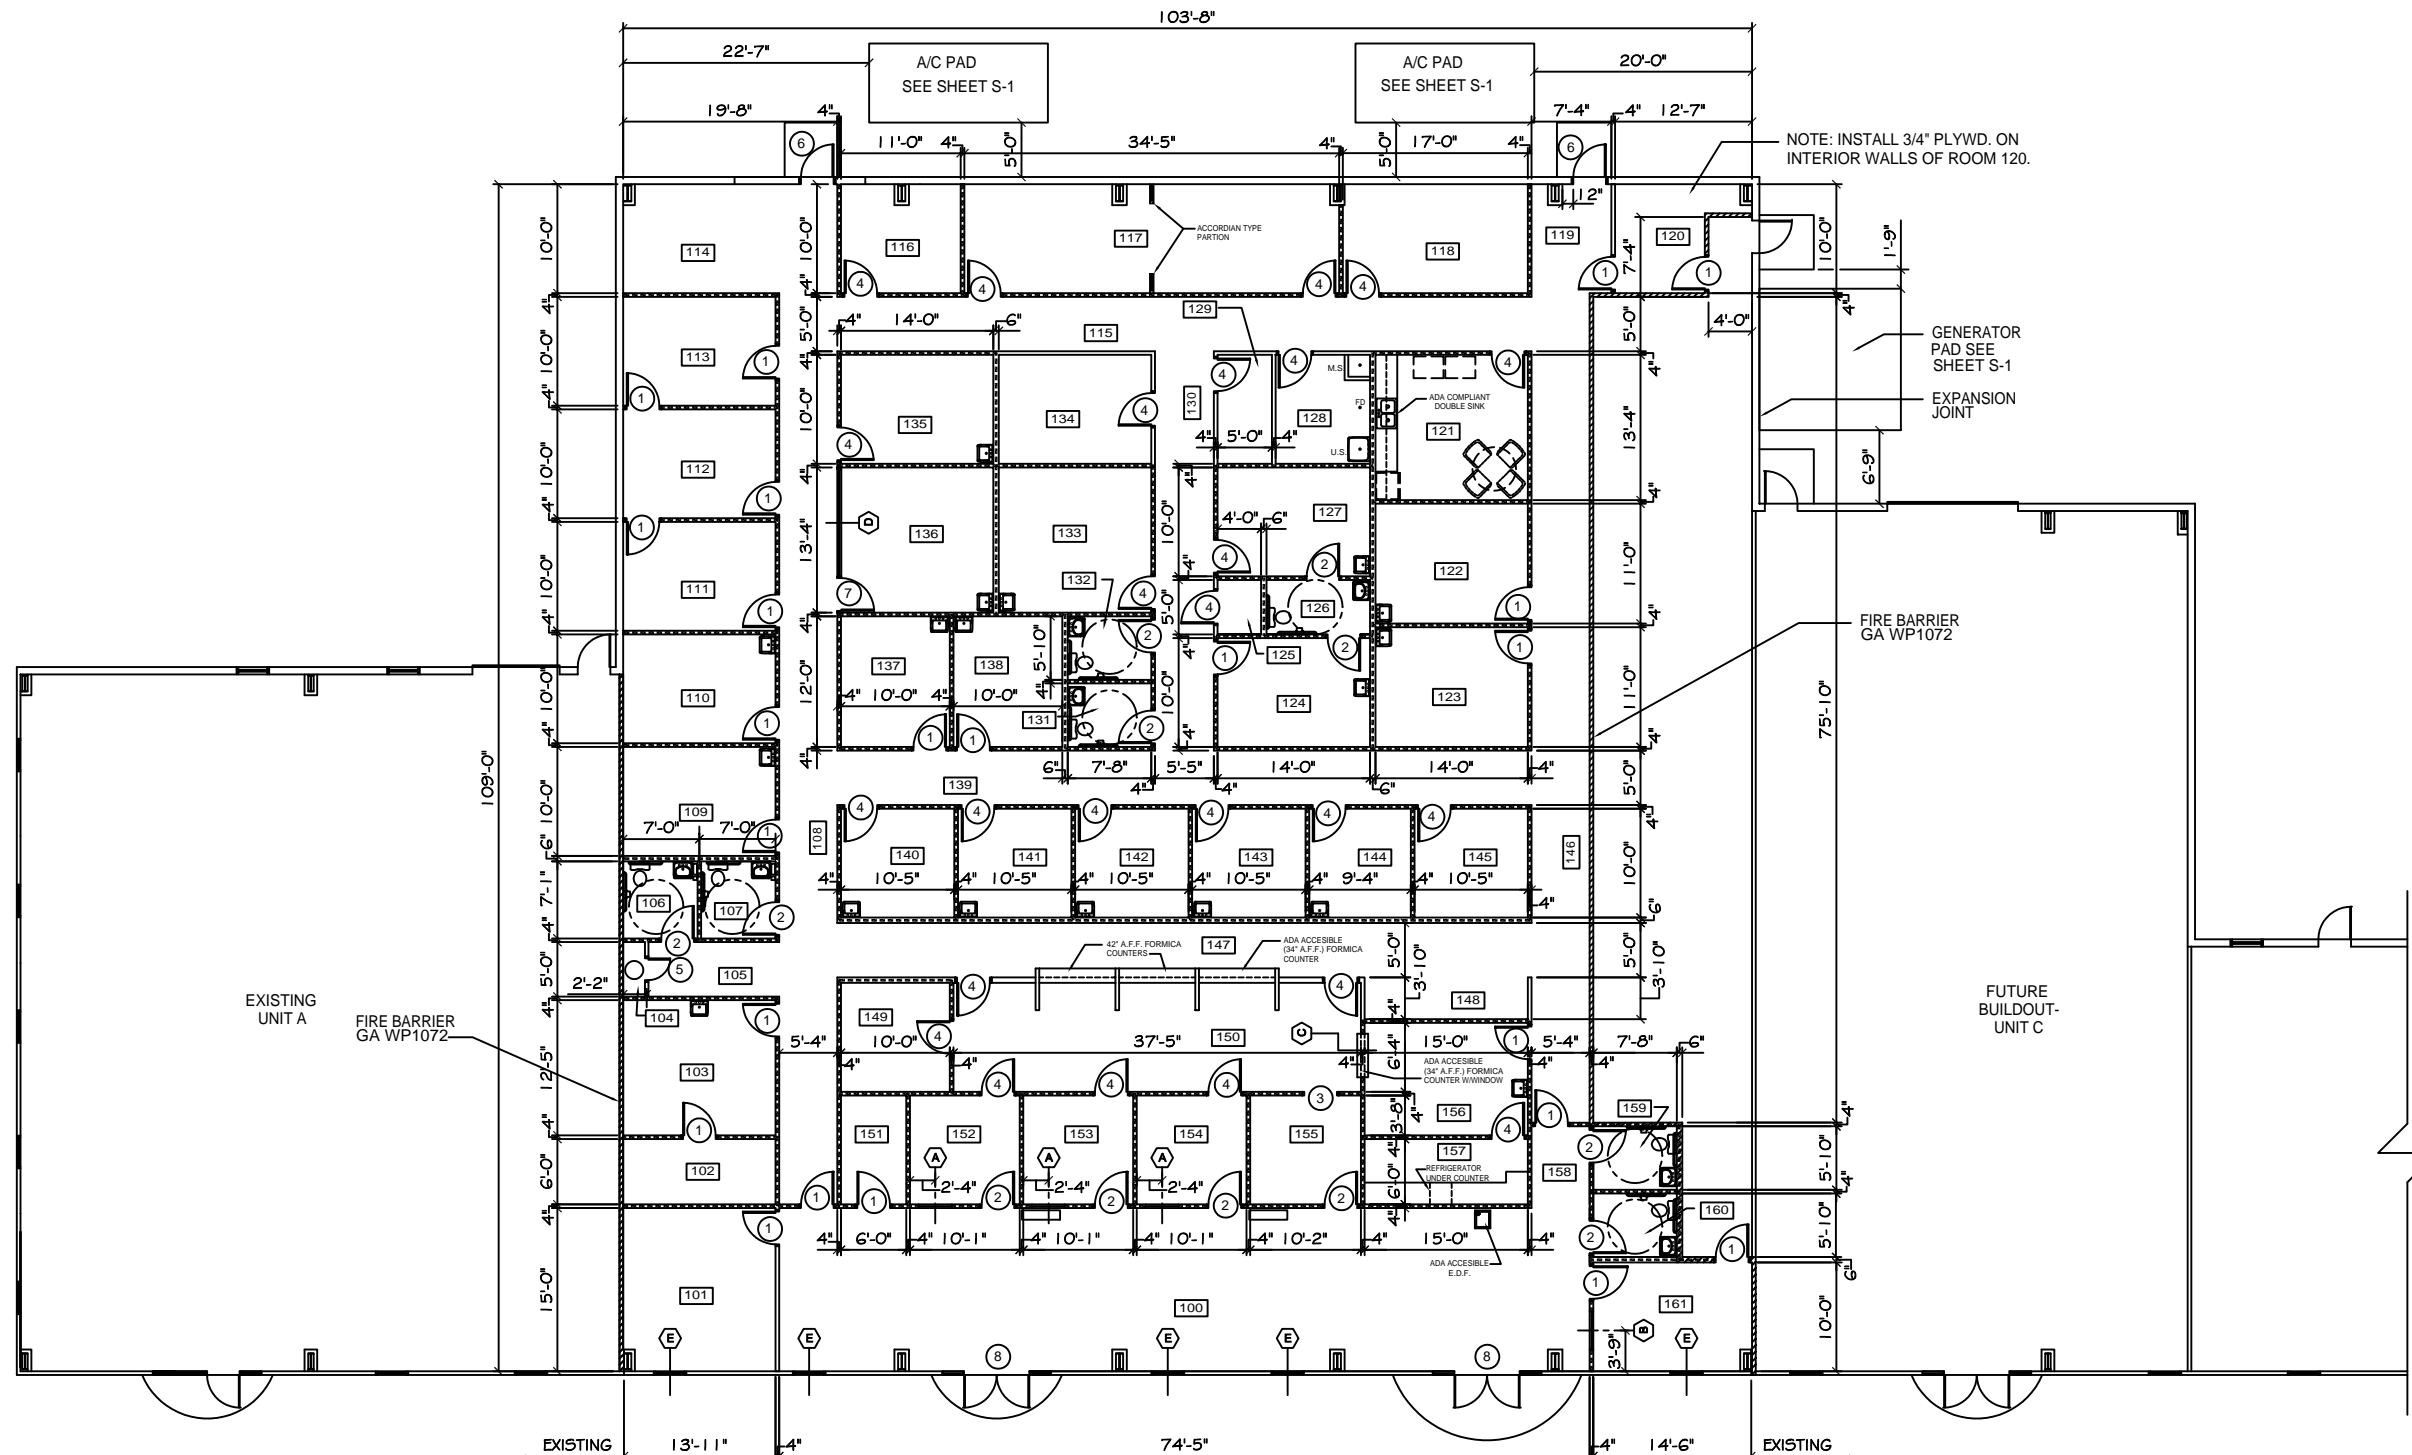

FLOOR PLAN - UNIT B
SCALE: 1/8"=1'

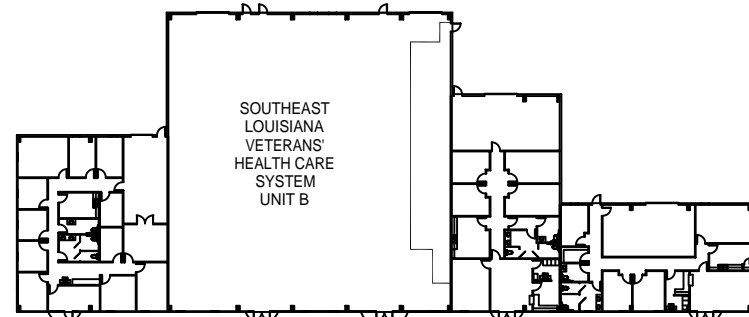

KEY PLAN
NTS

GA FILE NO. WP 1072 - GENERIC

ONE LAYER 5/8" TYPE X GYPSUM WALLBOARD OR GYPSUM VENEER BASE APPLIED PARALLEL OR AT RIGHT ANGLES TO EACH SIDE OF 3-5/8" STEEL STUDS 24" O.C. WITH 1" TYPE S DRYWALL SCREWS 8" O.C. AT VERTICAL JOINTS AND 12" O.C. AT FLOOR AND CEILING RUNNERS AND INTERMEDIATE STUDS.

JOINTS STAGGERED 24" ON EACH SIDE AND ON OPPOSITE SIDES. SOUND TESTED WITH 3-12" GLASS FIBER FRICTION FIT IN STUD SPACE. (NON-LOAD BEARING)

1 HOUR FIRE 45 TO 49 STC SOUND


THICKNESS: 4-7/8"
APPROX. WEIGHT: 6 PSF

FIRE TEST:
SEE WP 1200
(FM WP-45, 6-19-88);
OSU T-1770, 8-81;
ULC 79T484, 79T500, 79T497,
8-12-81, ULC DESIGN W415)
SOUND TEST:
NRCC 816-NV, 2-3-81

LEGEND

===== INSULATED WALLS

===== UNINSULATED WALLS

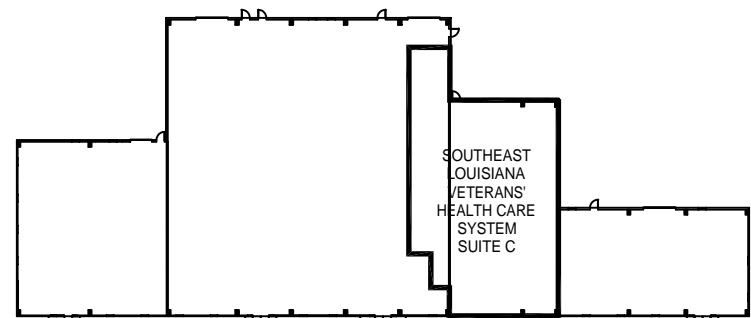

KEY PLAN
NTS

- LEGEND**
- INSULATED WALLS
 - UNINSULATED WALLS
 - EXISTING FIRE WALLS


GA FILE NO. WP 1072 GENERIC

1 HOUR FIRE 45 TO 49 STC SOUND


ONE LAYER 5/8" TYPE X GYPSUM WALLBOARD OR GYPSUM VENEER BASE APPLIED PARALLEL OR AT RIGHT ANGLES TO EACH SIDE OF 3-5/8" STEEL STUDS 24" O.C. WITH 1" TYPE S DRYWALL SCREWS 8" O.C. AT VERTICAL JOINTS AND 12" O.C. AT FLOOR AND CEILING RUNNERS AND INTERMEDIATE STUDS.

JOINTS STAGGERED 24" ON EACH SIDE AND ON OPPOSITE SIDES. SOUND TESTED WITH 3-12" GLASS FIBER FRICTION FIT IN STUD SPACE. (NON-LOAD BEARING)

THICKNESS: 4-7/8"
APPROX. WEIGHT: 6 PSF
FIRE TEST: SEE WP 1200 (FM WP-45, 6-19-68); OSU T-1770, 8-61; ULC 79T484, 79T500, 79T497, 8-12-81, ULC DESIGN W415)
SOUND TEST: NRCC 816-NV, 2-3-81

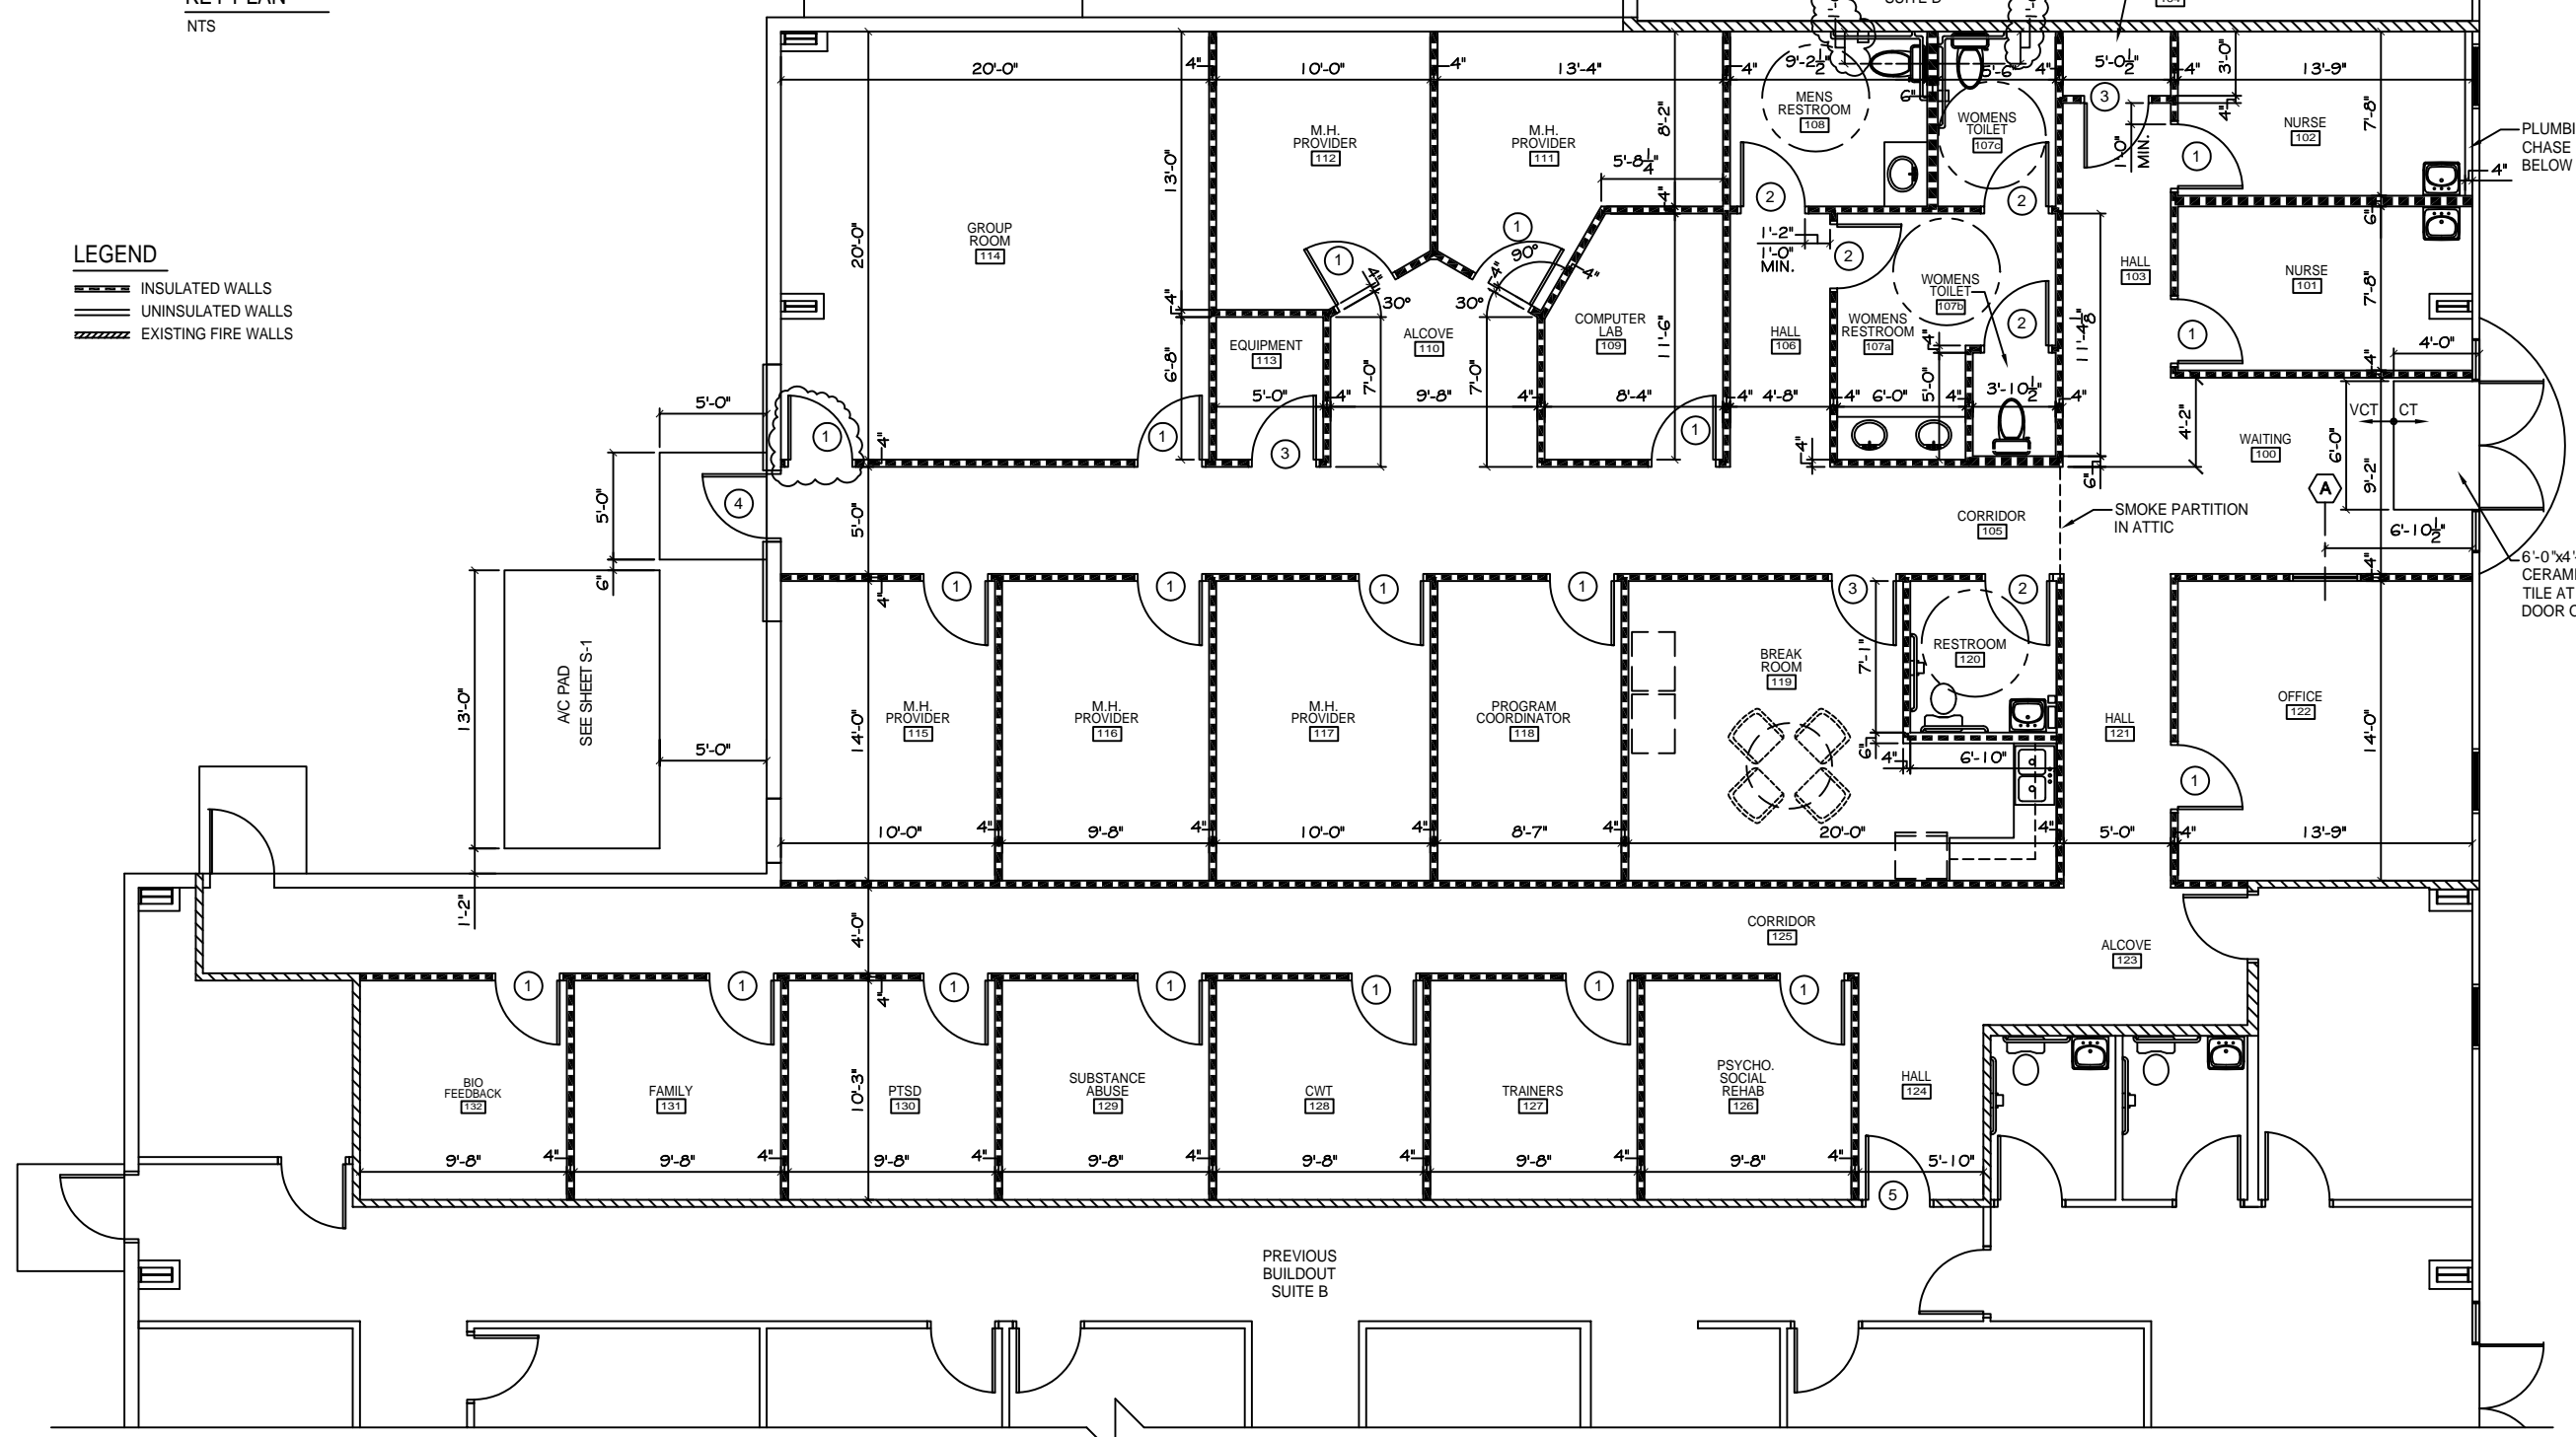

FLOOR PLAN - SUITE C
SCALE: 1/4"=1'

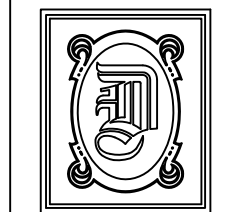

DAMMON ENGINEERING, INC.

CHIEF ENGINEER
EMMETT DAMMON, P.E.

CHIEF ARCHITECT
ROBERT WILTSE

1095 FLORIDA AVENUE
SLIDELL, LA. 70458
OFFICE: 985-649-5832
FAX: 985-641-5950

WEBSITE:
WWW.DAMMONENGINEERING.COM

EMAIL:
DAMMONENG@BELLSOUTH.NET

ARCHITECTURE
ENGINEERING
STUDIES
PLANNING
INVESTIGATION
EXPERT WITNESS

SOUTHEAST LOUISIANA VETERAN'S HEALTH CARE SYSTEM

SUITE C FLOOR PLAN

REV: 5-05-09

SCALE: AS NOTED


JOB#: 2011

DATE: 04-06-09

SHEET 4

A-1

OF 14

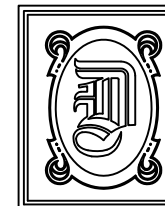

**DAMMON
ENGINEERING, INC.**

CHIEF ENGINEER
EMMETT
DAMMON, P.E.

CHIEF ARCHITECT
ROBERT
WILTSE

1095 FLORIDA AVENUE
SLIDELL, LA. 70458
OFFICE: 985-649-5832
FAX: 985-641-5950

WEBSITE:
WWW.DAMMONENGINEERING.COM

EMAIL:
DAMMONENG@BELLSOUTH.NET

ARCHITECTURE

ENGINEERING

STUDIES

PLANNING

INVESTIGATION

EXPERT WITNESS

SOUTHEAST
LOUISIANA
VETERAN'S
HEALTH CARE
SYSTEM

SUITE D
FLOOR PLAN

REV:

SCALE: AS NOTED

JOB#: 2012

DATE: 03-11-09



SHEET 3

A-1

OF 11

LEGEND

- INSULATED WALLS
- UNINSULATED WALLS
- EXISTING FIRE WALLS

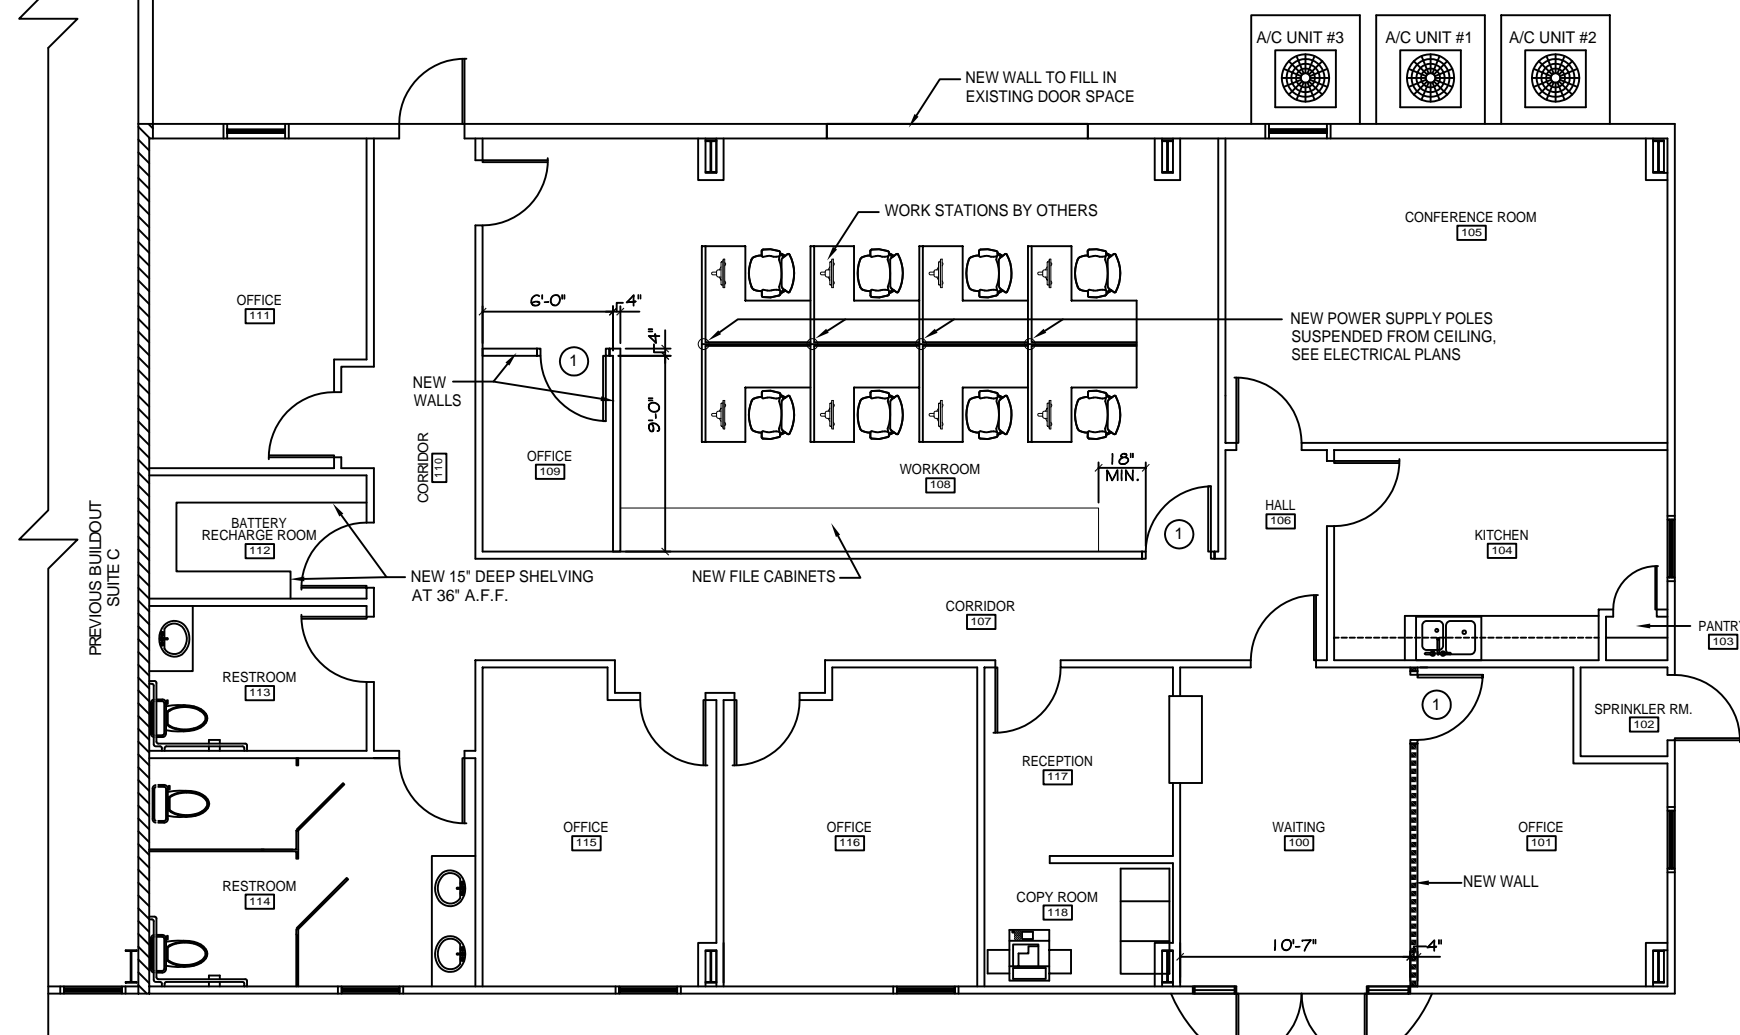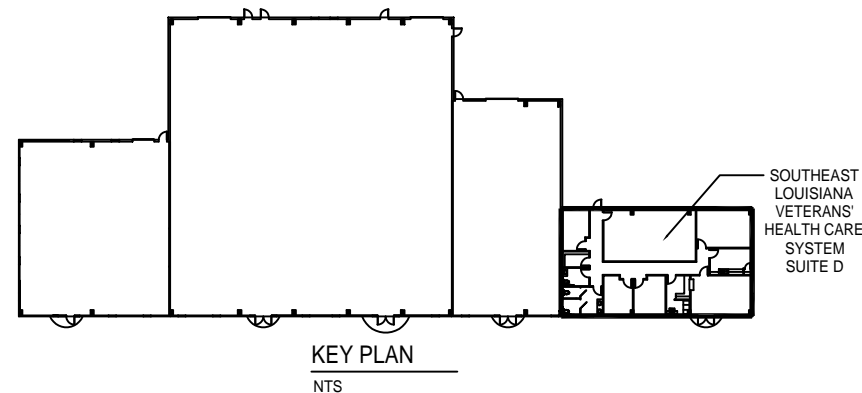

FLOOR PLAN - SUITE D
SCALE: 1/4"=1'

