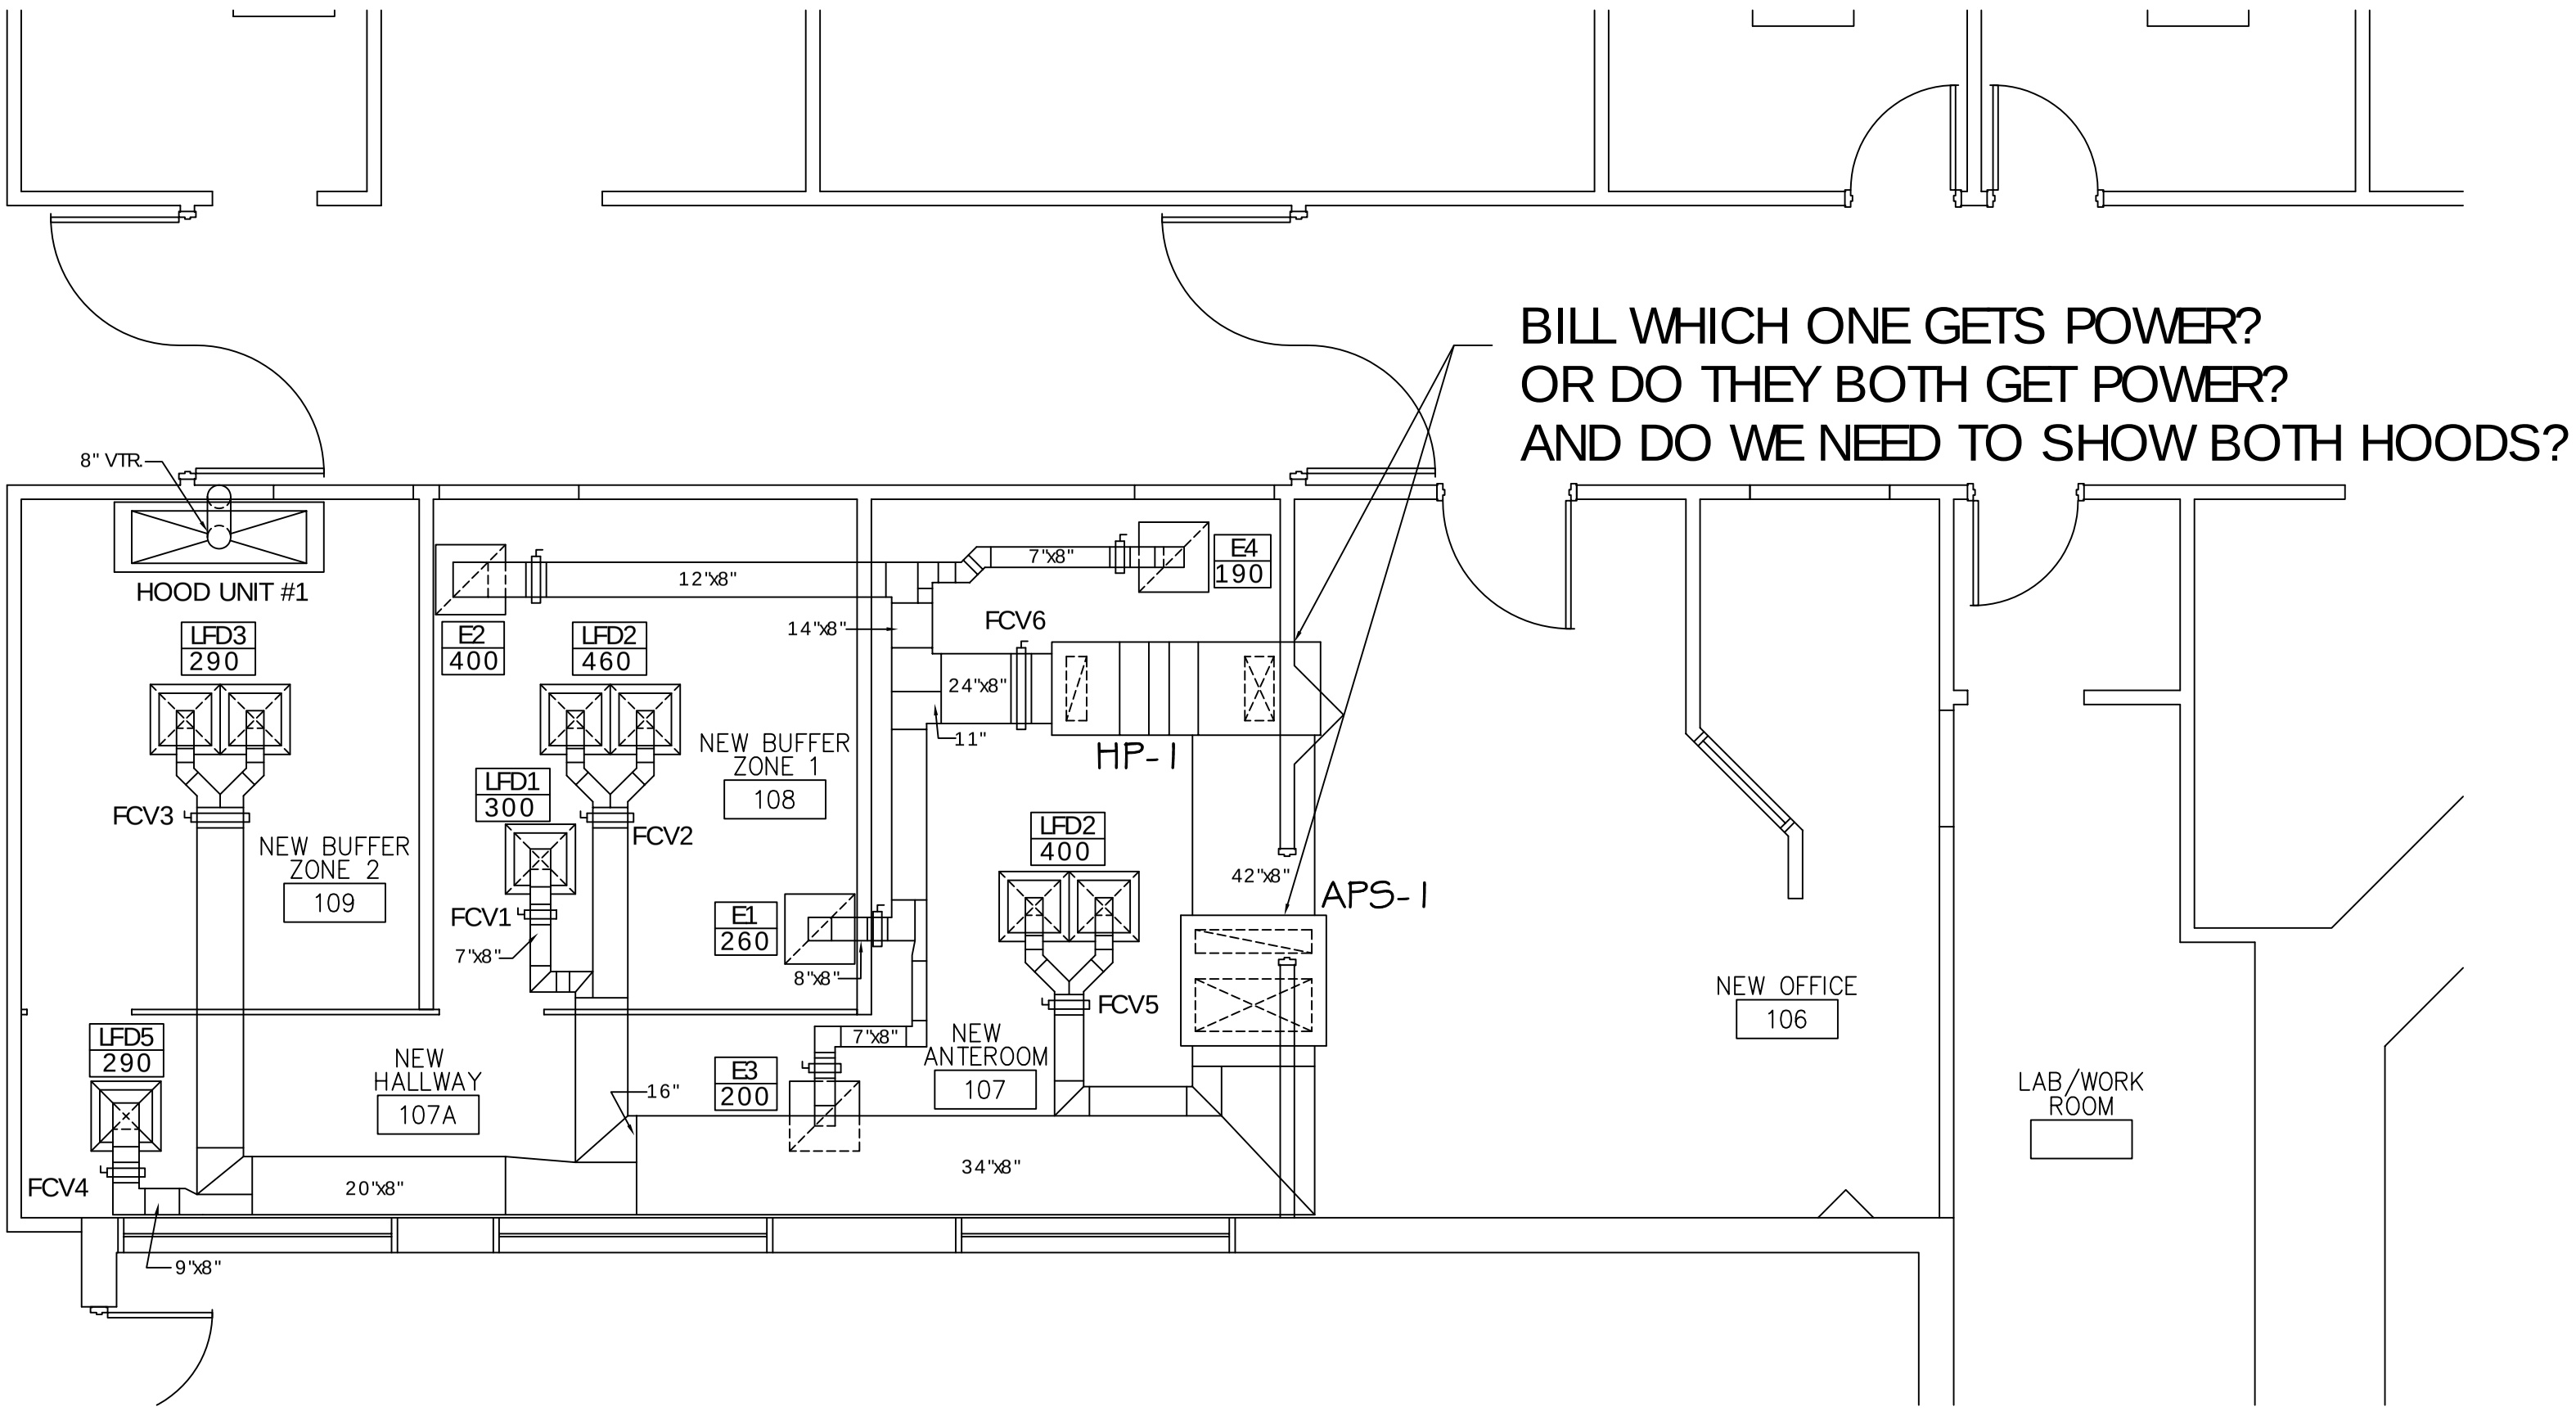
BILL WHICH ONE GETS POWER?
OR DO THEY BOTH GET POWER?
AND DO WE NEED TO SHOW BOTH HOODS?
8" VTR
HOOD UNIT #1
LFD3
290
FCV3
NEW BUFFER
ZONE 2
109
LFD5
290
FCV4
NEW
HALLWAY
107A
20"x8"
9"x8"
E2
400
12"x8"
LFD2
460
LFD1
300
FCV2
FCV1
7"x8"
16"
14"x8"
NEW BUFFER
ZONE 1
108
E1
260
8"x8"
E3
200
7"x8"
NEW
ANTEROOM
107
34"x8"
FCV6
24"x8"
11"
7"x8"
E4
190
HP-1
LFD2
400
FCV5
42"x8"
APS-1
NEW OFFICE
106
LAB/WORK
ROOM