

DAMMON ENGINEERING, INC.

CHIEF ENGINEER
EMMETT DAMMON, P.E.

CHIEF ARCHITECT
ROBERT WILTSE

1095 FLORIDA AVENUE
SLIDELL, LA, 70450
OFFICE: 985-649-5832
FAX: 985-641-5950


WEBSITE:
WWW.DAMMONENGINEERING.COM
EMAIL:
DAMMON@DAMMONENGINEERING.COM

ARCHITECTURE
ENGINEERING
STUDIOS
PLANNING
INVESTIGATION
EXPERT WITNESS


OFFICE &
WAREHOUSE
EXPANSION &
RENOVATION

PATTERSON
DENTAL SUPPLY
107 MALLARD ST.
SAINT ROSE, LA
70087

NEW
FLOOR PLAN

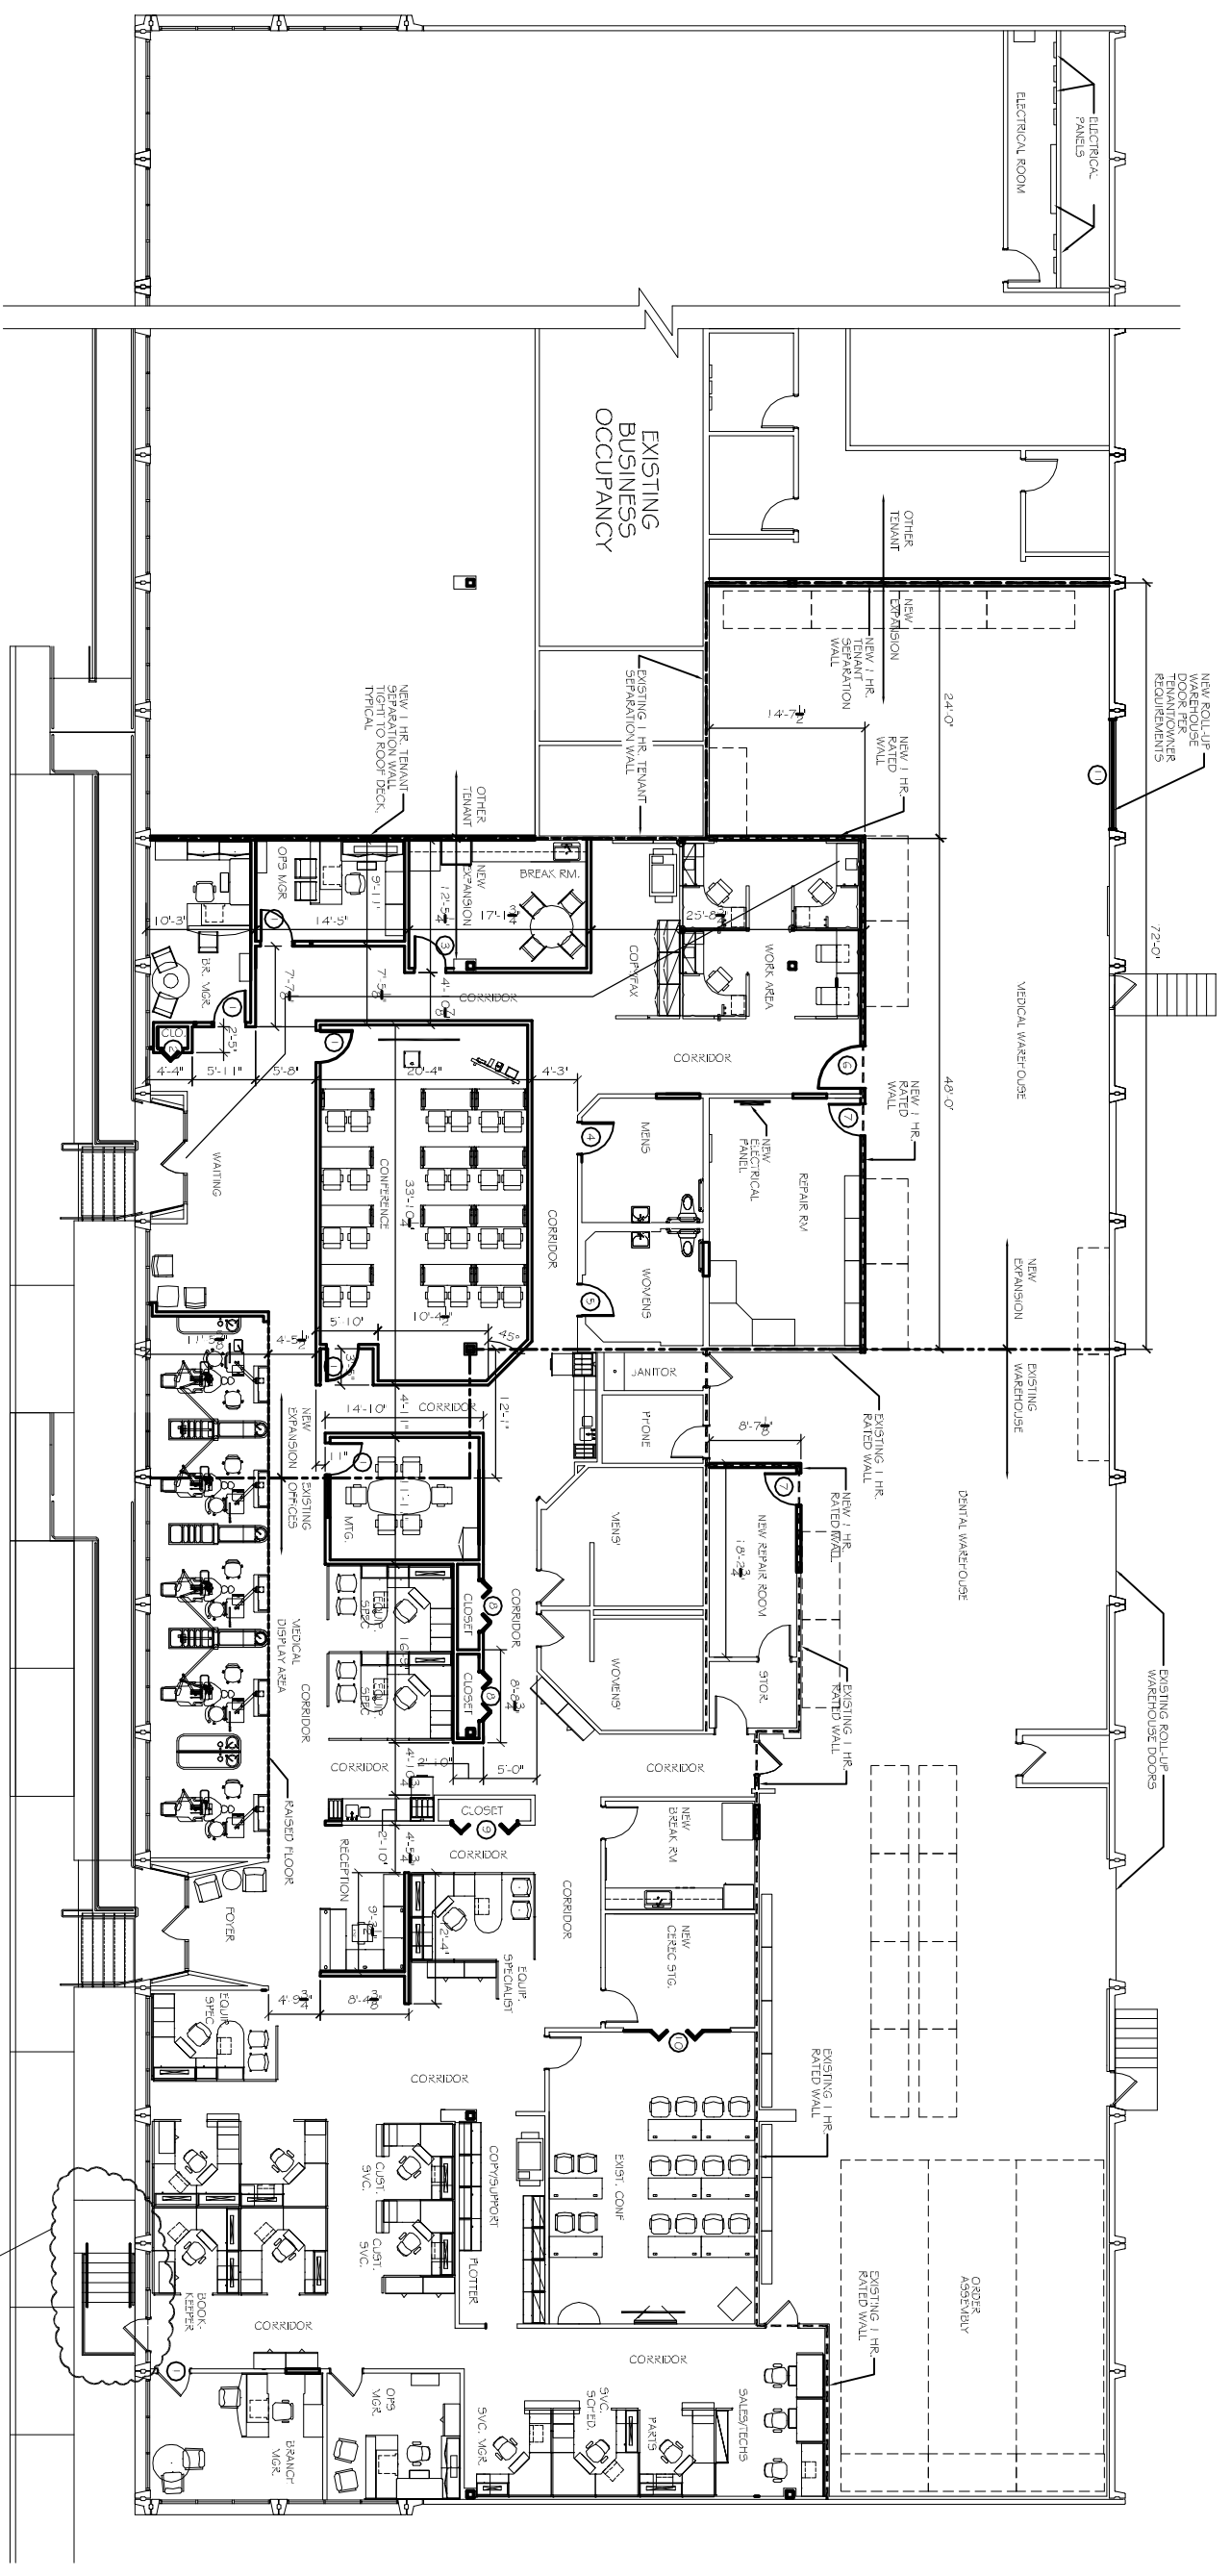

NEW FLOOR PLAN
SCALE: 1/8" = 1'-0"

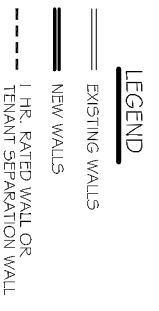

APPROX. WEIGHT: 6 PSF
FIRE TEST:
SEE WP 1200 (FM WP 45, 6-19-68);
OSU T-1770, 8-61; ULC 791484, 791500,
791497, 8-12-81; ULC DESIGN W4151

SOUND TEST:
NRCC 816-NV, 2-3-81

GA FILE NO. WP 1072 GENERIC

ONE LAYER 5/8" TYPE X GYPSUM WALLBOARD OR GYPSUM VENEER BASE APPLIED PARALLEL OR AT RIGHT ANGLES TO EACH SIDE OF 3-5/8" STEEL STUDS 24" O.C. WITH 1" TYPE S DRYWALL SCREWS 8" O.C. AT VERTICAL JOINTS AND 12" O.C. AT FLOOR AND CEILING RUNNERS AND INTERMEDIATE STUDS.

JOINTS STAGGERED 24" ON EACH SIDE AND ON OPPOSITE SIDES. SOUND TESTED WITH 3-1/2" GLASS FIBER FRICTION FIT IN STUD SPACE. (NON-LOAD BEARING)

1 HR SEPARATION DETAIL
NTS

NEW EXIT

REV:	
SCALE:	AS NOTED
JOB#:	2076
DATE:	11-05-10
SHEET:	4
	A-1
	OF 11