

THERAPY EQUIPMENT LIST

MK	EQUIPMENT
A	MATRIX
B	EXERCISE TABLE
C	WEB SLIDE WORKOUT AREA
D	E-STIM CART
E	PHYSICAL THERAPY TABLE
F	ELLIPTICAL
G	BIKE
H	NUSTEP
J	UBE
K	SHUTTLE
L	ICE PACK FREEZER
M	HOT PACKS
N	REBOUNDER
O	COUNTER FOR HOT/COLD PKGS
P	STORAGE RACK
Q	CLEAN LINEN
R	DIRTY LINEN
S	WASTE

X-RAY EQUIPMENT LIST

MK	EQUIPMENT
1	DEL MEDICAL CMB0 CONTROL CONSOLE
2	DEL MEDICAL CMB0 GENERATOR CABINET
3	DR WORKSTATION PC, MONITOR, & KEYBOARD
4	DEL FMT18M TUBE STAND
5	DEL VT300 VERTICAL WALLSTAND
6	LEAD WINDOWS
7	COUNTER TOP WITH PC SHELF BELOW
8	IDR-L FULL SPINE DETECTOR
9	MOBILE TABLE

DOOR SCHEDULE

MK	WIDTH	HT	THK	DOOR MAT	FRAME MAT	FR	REMARKS
DO1	(2) 3'-0"	6'-8"	1-3/4"	GLASS	METAL	NR	NEW AUTOMATIC FOLDING DOORS; WITH EMERGENCY EGRESS. MATCH EXISTING FINISHES
DO2	3'-0"	6'-8"	1-3/4"	METAL	METAL	40	NEW EXTERIOR DOOR WITH CLOSER; MATCH EXISTING FINISHES
DO3	3'-0"	6'-8"	1-3/4"	WOOD	METAL	NR	NEW INTERIOR DOORS; MATCH EXISTING FINISHES
DO4	3'-0"	6'-8"	1-3/4"	WOOD	METAL	NR	NEW INTERIOR DOORS WITH CLOSER; MATCH EXISTING FINISH
DO5	3'-8"	6'-8"	1-3/4"	METAL	METAL	45	NEW TENANT SEPARATION DOOR WITH THERMAL HOLD BACK DEVICE, GEZE T55000 OR EQUAL; MATCH EXISTING FINISHES
DO6	3'-0"	6'-8"	-	-	METAL	NR	CASED OPENING

WINDOW SCHEDULE

MK	WD	HT	FRAME	REMARKS
1	3'-0"	4'-0"	ALUM	MATCH EXISTING WINDOW FRAME & GLAZING; SHALL BE IMPACT RESISTANT. PROVIDE WINDOW TREATMENT IN EXAM ROOMS.
2	4'-9"	9'-0"	ALUM	3/4" GLAZING; MATCH EXISTING WINDOW FRAME; SHALL BE IMPACT RESISTANT
3	22'-8"	9'-0"	ALUM	3/4" GLAZING; MATCH EXISTING WINDOW FRAME; SHALL BE IMPACT RESISTANT


- ### GENERAL NOTES
- INSULATION AND INSULATION ASSEMBLIES SHALL MEET THE REQUIREMENTS OF IBC 2012 SECTION T11.
 - CONCEALED INSULATION SHALL HAVE A FLAME SPREAD OF 0-25 AND SMOKE DEVELOPED INDEX OF 0-450, EXCEPT THAT IN COMBUSTIBLE (WOOD FRAME) CONSTRUCTION.
 - FACING SHALL COMPLY WITH IBC 2012.
 - ALL MATERIALS SHALL BE NEW AND UL LISTED.
 - NO WORK SHALL BE CONCEALED UNTIL APPROVED BY LOCAL INSPECTORS.
 - CONSTRUCTION SHALL COMPLY WITH ALL PARISH, STATE, AND LOCAL CODES.
 - CONTRACTOR TO GUARANTEE WORK FOR ONE YEAR FROM DATE OF SUBSTANTIAL COMPLETION.
 - CONTRACTOR SHALL FURNISH WATER AND POWER FROM EXISTING SOURCES.
 - PROVIDE 5X5 LANDING, LEVEL WITH FINISHED FLOOR, OUTSIDE EXTERIOR DOORS. THRESHOLDS SHALL BE NOT MORE THAN 1/2" IN HEIGHT AND SHALL BE BEVELED IF MORE THAN 1/4".
 - EXTERIOR CAULKING SHALL BE THIKOL CAULK.
 - PAINT SHALL BE SHERWIN WILLIAMS OR EQUIVALENT AND APPROPRIATE FOR THE SUBSTRATE TO WHICH IT IS APPLIED AS RECOMMENDED BY PAINT MANUFACTURER. ALL WORK TO RECEIVE THREE COATS (ONE PRIMER COAT, TWO FINISH COATS) UNLESS OTHERWISE RECOMMENDED BY PAINT MANUFACTURER. COLORS TO BE SELECTED BY OWNER.
 - PROVIDE CLEANUP ON A REGULAR BASIS. NO TRASH SHALL BE STORED INSIDE BUILDING PREMISES.
 - ALL BATT INSULATION SHALL HAVE A CLASS "A" (0-25) FLAME SPREAD IN COMPLIANCE WITH IBC 2012.
 - USE 2X6 STUDS, OR TWO 2X4 STAGGERED STUDS WITH 2X6 SILL PLATE AT ALL WALLS WHERE 4" PIPE IS INDICATED. SEE PLUMBING RISER DIAGRAM FOR PIPE SIZE.
 - PROVIDE GALVANIZED METAL PAN WITH DRAIN AT ALL WATER HEATERS.
 - ALL FLOORING SHALL MEET OR EXCEED ADA GUIDELINES REQUIREMENTS FOR SLIP RESISTANCE.
 - INTERIOR LOCKS ON DOORS IN MEANS OF EGRESS SHALL NOT REQUIRE THE USE OF A KEY, SPECIAL KNOWLEDGE, OR SPECIAL DEVICE TO OPEN IN THE DIRECTION OF EGRESS. ALL DOORS SHALL HAVE LEVER TYPE HANDLES.
 - INTERIOR WALLS AND CEILING SHALL HAVE A FLAME SPREAD OF 0-200 AND A SMOKE DEVELOPMENT RATING OF 0-450.
 - ALL WORK SHALL COMPLY WITH THE LATEST EDITION OF ALL LOCAL, STATE, AND NATIONAL CODES GOVERNING THE TYPE OF WORK BEING PERFORMED.
 - PROVIDE PORTABLE FIRE EXTINGUISHERS IN ACCORDANCE WITH NFPA 101. SEE APPENDIX "E" OF NFPA 101 FOR DISTRIBUTION OF EXTINGUISHERS.
 - ALL FIRE WALLS SHALL EXTEND TIGHT TO ROOF DECK AND BE SEALED WITH AN APPROVED FIRE CAULK.
 - ALL ELECTRICAL, MECHANICAL, AND PLUMBING MATERIALS PENETRATING FIRE WALLS SHALL BE FIRE CAULKED. (PENETRATIONS THROUGH RATED CONSTRUCTION SHALL BE SEALED WITH A MATERIAL CAPABLE OF PREVENTING THE PASSAGE OF FLAMES AND HOT GASES WHEN TESTED IN ACCORDANCE WITH ASTM-E814.)
 - SERVICE COUNTERS SHALL HAVE AN ACCESSIBLE WRITING SURFACE IN COMPLIANCE WITH ADAAG ACCESSIBILITY GUIDELINES 2010, SECTION 902.3.

DAMMON ENGINEERING, INC.

LOUISIANA & MISSISSIPPI

Chief Engineer: Brian Mestich, PE
 554 Old Spanish Trail
 Slidell, LA 70458
 www.dammonengineering.com
 info@dammonengineering.com
 PH: 985.649.5832

NO.	DESCRIPTION	DATE
1	Added Exam Rooms 12 & 13	4/2/2022
2	Revised Exam Rm 8 X-Ray Layout	7/1/2022

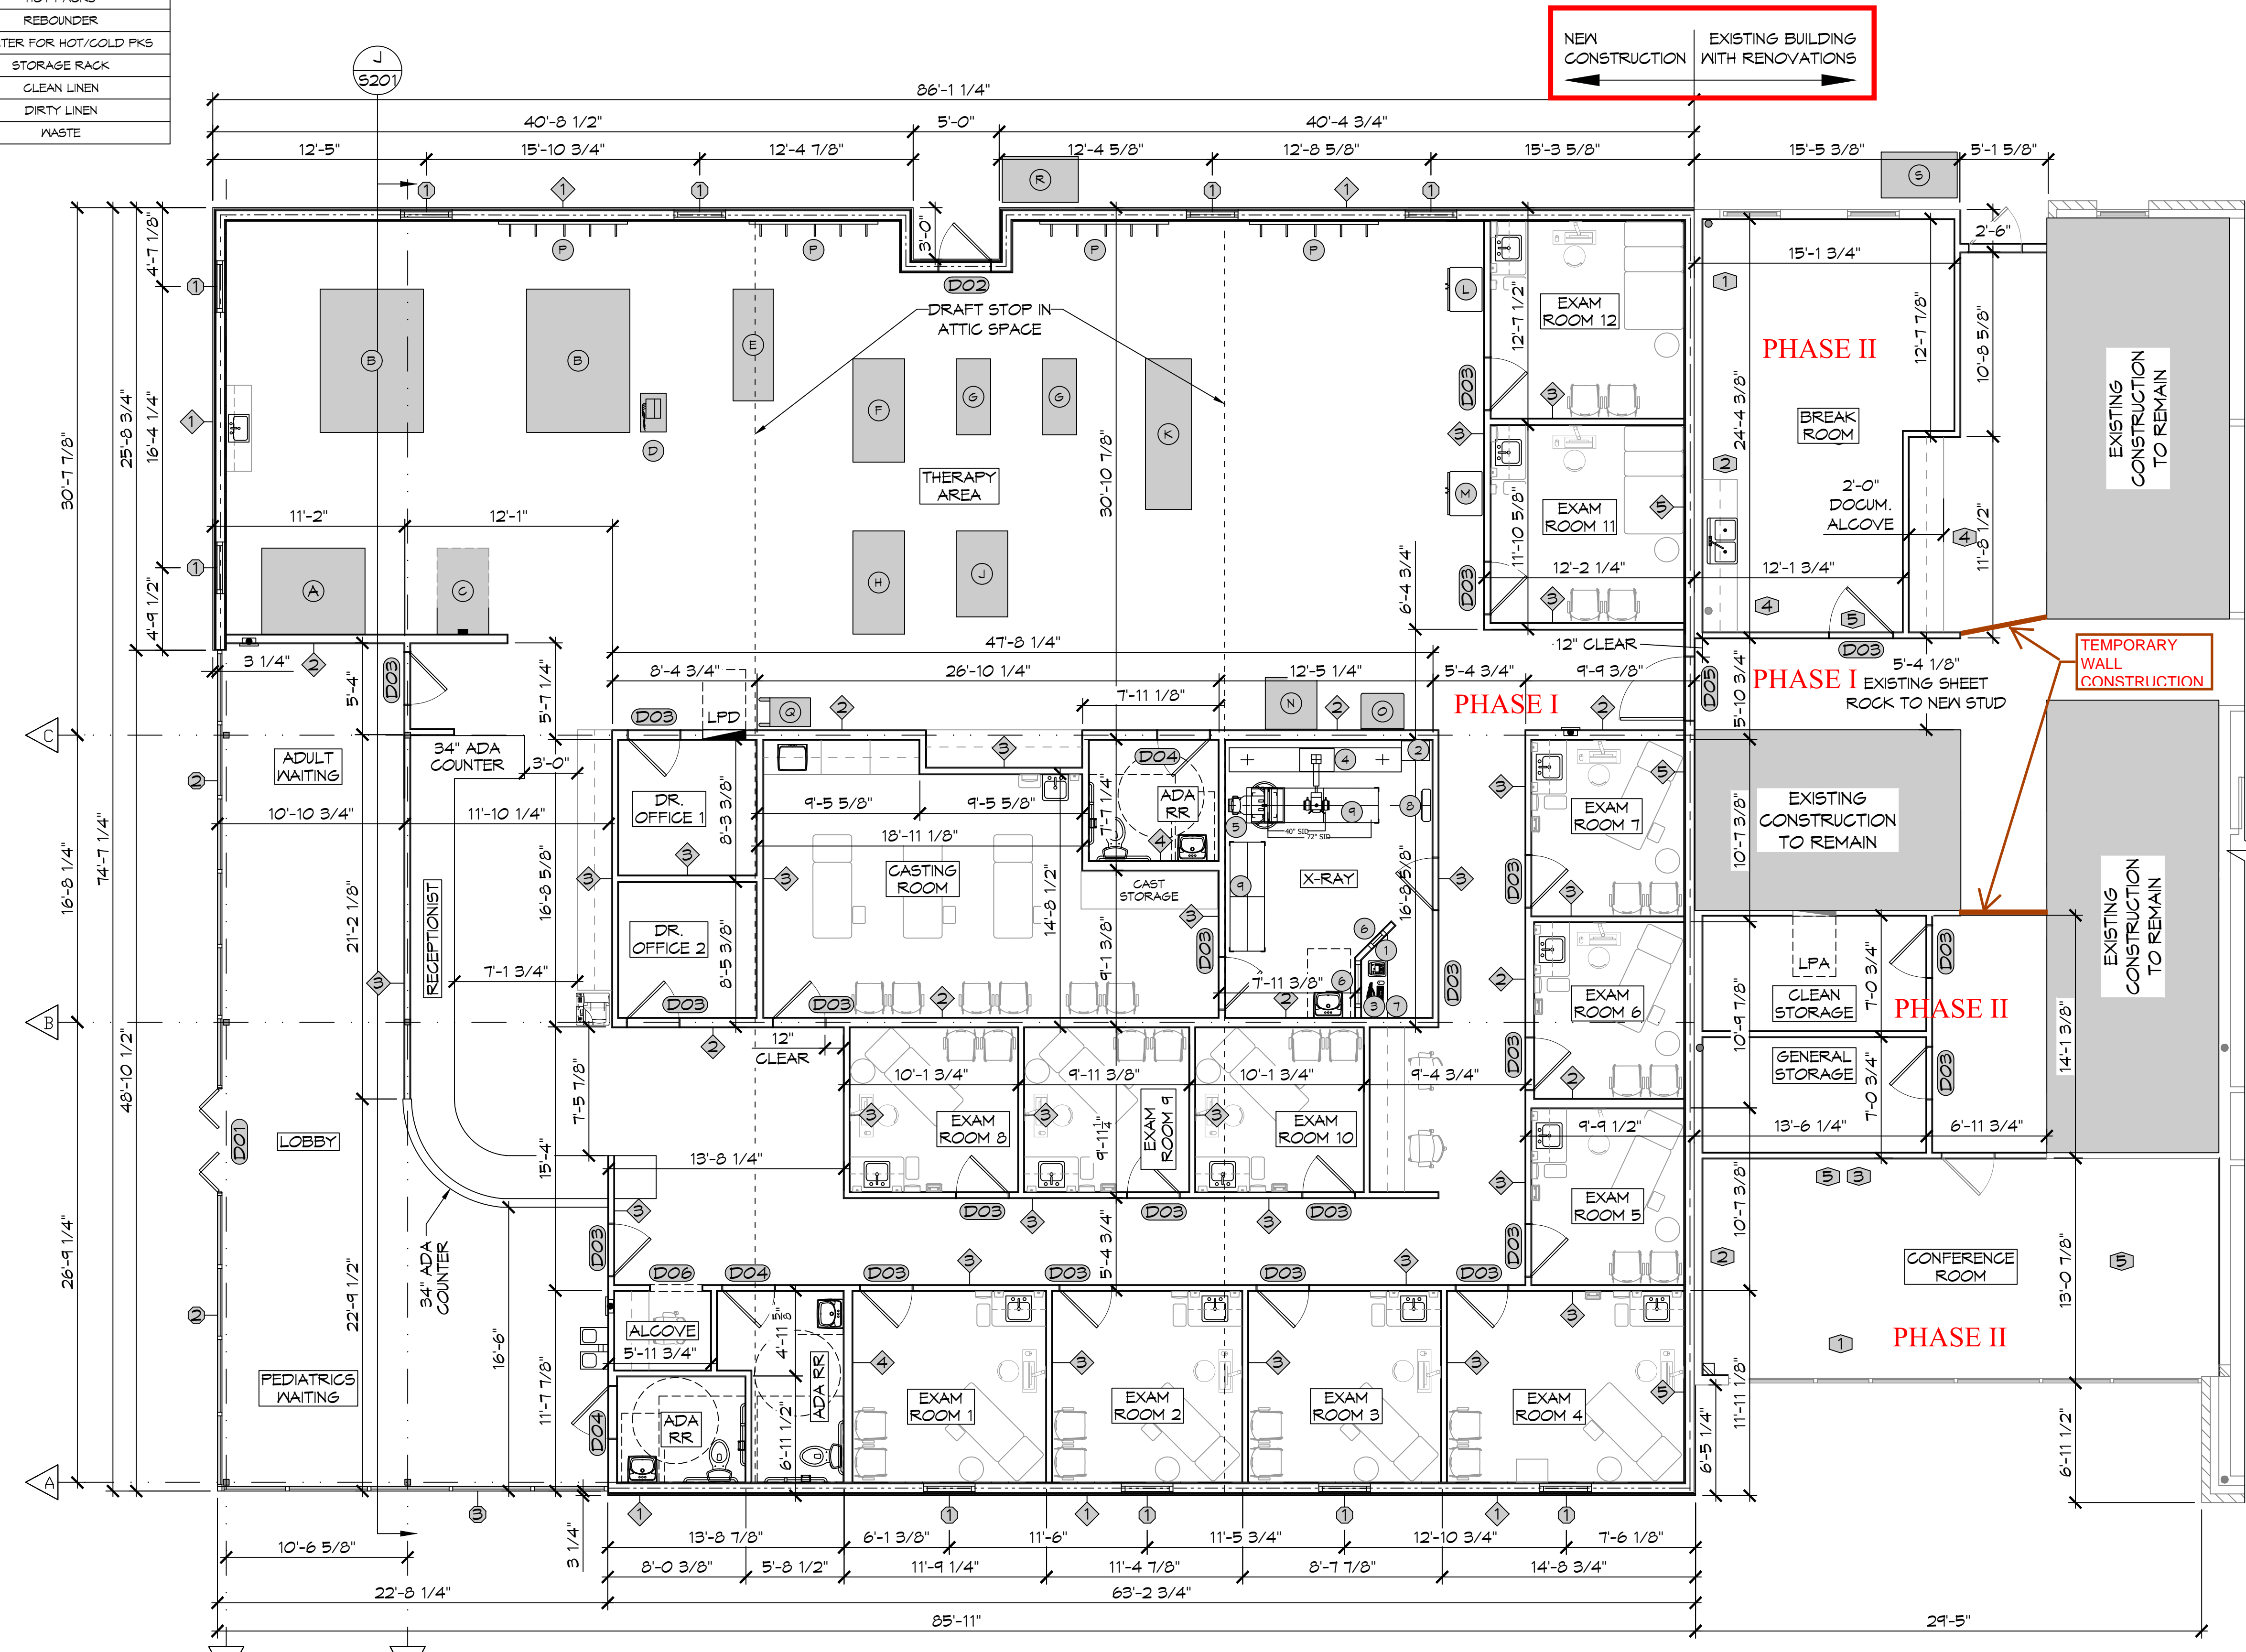

WALL LEGEND

DESCRIPTION (SEE SHEET A104)
1 6" METAL STUD, LOAD BEARING WALL, 2-HR RATED. UL425, SEE UL SPEC SHEET.
2 6" METAL STUD LOAD BEARING WALL.
3 4" METAL STUD NON-LOAD BEARING WALL.
4 6" METAL STUD NON-LOAD BEARING WALL.
5 6" METAL STUD, 1 HOUR NON-LOAD BEARING WALL, TENANT SEPARATION WALL, TIGHT TO ROOF DECK.

LEGEND

---	EXTERIOR LOAD BEARING WALLS CONSTRUCTED WITH NONCOMBUSTIBLE MATERIAL, 2HR FIRE RATING (UL 1425).
---	INTERIOR TENANT SEPARATION WALL CONSTRUCTED WITH NONCOMBUSTIBLE MATERIAL, 1HR FIRE RATING AGAINST EXISTING CONSTRUCTION (BASED ON UL 1301).
---	DRAFT STOP IN ATTIC SPACE, SMOKE RATED.

- ### RENOVATION NOTES
- REMOVE DOOR AND INFILL WALL TO MATCH EXISTING.
 - REMOVE GLAZING AND INFILL WALL TO MATCH EXISTING.
 - DEMO EXISTING FRONT DESK MILLWORK. PATCH WALLS TO REMAIN AND FLOOR.
 - CONSTRUCT MILLWORK TO MATCH EXISTING STYLE. VERIFY WITH OWNER.
 - CONSTRUCT NEW PARTITIONS TO MATCH EXISTING METAL STUD PARTITIONS, REPAIR FLOORING, MATCH EXISTING STYLES AND COLORS. VERIFY WITH OWNER.

- ### FINISH NOTES
- FLOOR, WALL, AND CEILING FINISHES TO MATCH EXISTING. ALL CORNERS TO RECEIVE CORNER GUARDS TO MATCH EXISTING. VERIFY COLORS WITH OWNER.

17 FLOOR PLAN
 SCALE: 3/16" = 1'-0"

RENOVATIONS AND NEW FLOOR PLAN

REVIEWED FOR STATE FIRE MARSHAL AS PER REVIEW LETTER BY: KENNETH NOVAK, ARCHITECT
 REVISED PLANS 8/5/2022

NEW ADDITION

H O N T A S T A N O O B

SHEET TITLE: RENOVATIONS AND NEW FLOOR PLAN

DRAWING NUMBER: A101

DATE: 6-15-2022
 CHECKED BY: CJD
 DRAWN BY: DPD

TITLE: LA HWY 21 70453
 COASTON, LA
 JOB NO: 2443
 SHEET No: 14 of 22