## PANEL "LA"

120/208V, 3ø, 4W, 200A MAINS, M.L.O., S/N, SURFACE MTD., 42,000 A.I.C

| TYPE LOAD | CKT NO. | BRKR | BUS A | BUS B | BUS C | BRKR | CKT NO. | TYPE LOAD |
|---|---|---|---|---|---|---|---|---|
| LIGHTING | 1 | 20/1 | | | | 20/1 | 2 | LIGHTING |
| LIGHTING | 3 | 20/1 | | | | 20/1 | 4 | LIGHTING |
| LIGHTING | 5 | 20/1 | | | | 20/1 | 6 | SPARE |
| RECEPTACLES | 7 | 20/1 | | | | 20/1 | 8 | RECEPTACLES |
| RECEPTACLES | 9 | 20/1 | | | | 20/1 | 10 | RECEPTACLES |
| RECEPTACLES | 11 | 20/1 | | | | 20/1 | 12 | RECEPTACLES |
| RECEPTACLES | 13 | 20/1 | | | | 20/1 | 14 | RECEPTACLES |
| RECEPTACLES | 15 | 20/1 | | | | 20/1 | 16 | RECEPTACLES |
| RECEPTACLES | 17 | 20/1 | | | | 20/1 | 18 | RECEPTACLES |
| CU-1 | 19 | 40/3 | | | | 60/3 | 20 | AHU-1 |
| | 21 | | | | | | 22 | |
| | 23 | | | | | | 24 | |
| SPARE | 25 | 20/1 | | | | 20/1 | 26 | SPARE |
| SPARE | 27 | 20/1 | | | | 20/1 | 28 | SPARE |
| SPARE | 29 | 20/1 | | | | 20/1 | 30 | SPARE |
| SPARE | 31 | 20/1 | | | | 20/1 | 32 | SPARE |
| SPARE | 33 | 20/1 | | | | 20/1 | 34 | SPARE |
| SPARE | 35 | 20/1 | | | | 20/1 | 36 | SPARE |
| SPARE | 37 | 20/1 | | | | 20/1 | 38 | SPARE |
| SPARE | 39 | 20/1 | | | | 20/1 | 40 | SPARE |
| SPARE | 41 | 20/1 | | | | 20/1 | 42 | SPARE |

LOADS: LIGHTING – 6KVA
RECEPTACLES – 11.2KVA
HVAC (HEATING MODE) – 15KVA
IFC LOAD – 89A

## PANEL "LB"

120/208V, 3ø, 4W, 200A MAINS, M.L.O., S/N, SURFACE MTD., 42,000 A.I.C

| TYPE LOAD | CKT NO. | BRKR | BUS A | BUS B | BUS C | BRKR | CKT NO. | TYPE LOAD |
|---|---|---|---|---|---|---|---|---|
| LIGHTING | 1 | 20/1 | | | | 20/1 | 2 | LIGHTING |
| LIGHTING | 3 | 20/1 | | | | 20/1 | 4 | LIGHTING |
| RECEPTACLES | 5 | 20/1 | | | | 20/1 | 6 | RECEPTACLES |
| RECEPTACLES | 7 | 20/1 | | | | 20/1 | 8 | RECEPTACLES |
| RECEPTACLES | 9 | 20/1 | | | | 20/1 | 10 | RECEPTACLES |
| RECEPTACLES | 11 | 20/1 | | | | 20/1 | 12 | RECEPTACLES |
| RECEPTACLES | 13 | 20/1 | | | | 20/1 | 14 | RECEPTACLES |
| RECEPTACLES | 15 | 20/1 | | | | 20/1 | 16 | RECEPTACLES |
| RECEPTACLES | 17 | 20/1 | | | | 20/1 | 18 | RECEPTACLES |
| CU-2 | 19 | 40/3 | | | | 60/3 | 20 | AHU-2 |
| | 21 | | | | | | 22 | |
| | 23 | | | | | | 24 | |
| SPARE | 25 | 20/1 | | | | 20/1 | 26 | SPARE |
| SPARE | 27 | 20/1 | | | | 20/1 | 28 | SPARE |
| SPARE | 29 | 20/1 | | | | 20/1 | 30 | SPARE |
| SPARE | 31 | 20/1 | | | | 20/1 | 32 | SPARE |
| SPARE | 33 | 20/1 | | | | 20/1 | 34 | SPARE |
| SPARE | 35 | 20/1 | | | | 20/1 | 36 | SPARE |
| SPARE | 37 | 20/1 | | | | 20/1 | 38 | SPARE |
| SPARE | 39 | 20/1 | | | | 20/1 | 40 | SPARE |
| SPARE | 41 | 20/1 | | | | 20/1 | 42 | SPARE |

LOADS: LIGHTING – 6.2KVA
RECEPTACLES – 10.6KVA
HVAC (HEATING MODE) – 15KVA
IFC LOAD – 89A

## PANEL "LC"

120/208V, 3ø, 4W, 200A MAINS, M.L.O., S/N, SURFACE MTD., 42,000 A.I.C

| TYPE LOAD | CKT NO. | BRKR | BUS A | BUS B | BUS C | BRKR | CKT NO. | TYPE LOAD |
|---|---|---|---|---|---|---|---|---|
| LIGHTING | 1 | 20/1 | | | | 20/1 | 2 | LIGHTING |
| LIGHTING | 3 | 20/1 | | | | 20/1 | 4 | LIGHTING |
| RECEPTACLES | 5 | 20/1 | | | | 20/1 | 6 | RECEPTACLES |
| RECEPTACLES | 7 | 20/1 | | | | 20/1 | 8 | RECEPTACLES |
| RECEPTACLES | 9 | 20/1 | | | | 20/1 | 10 | RECEPTACLES |
| RECEPTACLES | 11 | 20/1 | | | | 20/1 | 12 | RECEPTACLES |
| RECEPTACLES | 13 | 20/1 | | | | 20/1 | 14 | RECEPTACLES |
| RECEPTACLES | 15 | 20/1 | | | | 20/1 | 16 | RECEPTACLES |
| RECEPTACLES | 17 | 20/1 | | | | 20/1 | 18 | RECEPTACLES |
| SPARE | 19 | 20/1 | | | | 60/3 | 20 | AHU-3 |
| CU-3 | 21 | 40/3 | | | | | 22 | |
| | 23 | | | | | | 24 | |
| | 25 | | | | | 20/1 | 26 | SPARE |
| SPARE | 27 | 20/1 | | | | 20/1 | 28 | SPARE |
| SPARE | 29 | 20/1 | | | | 20/1 | 30 | SPARE |
| SPARE | 31 | 20/1 | | | | 20/1 | 32 | SPARE |
| SPARE | 33 | 20/1 | | | | 20/1 | 34 | SPARE |
| SPARE | 35 | 20/1 | | | | 20/1 | 36 | SPARE |
| SPARE | 37 | 20/1 | | | | 20/1 | 38 | SPARE |
| SPARE | 39 | 20/1 | | | | 20/1 | 40 | SPARE |
| SPARE | 41 | 20/1 | | | | 20/1 | 42 | SPARE |

LOADS: LIGHTING – 5.8KVA
RECEPTACLES – 12.3KVA
HVAC (HEATING MODE) – 15KVA
IFC LOAD – 92A

## PANEL "LD"

120/208V, 3ø, 4W, 200A MAINS, M.C.B., S/N, SURFACE MTD., 42,000 A.I.C

| TYPE LOAD | CKT NO. | BRKR | BUS A | BUS B | BUS C | BRKR | CKT NO. | TYPE LOAD |
|---|---|---|---|---|---|---|---|---|
| LIGHTING | 1 | 20/1 | | | | 20/1 | 2 | LIGHTING |
| LIGHTING | 3 | 20/1 | | | | 20/1 | 4 | LIGHTING |
| LIGHTING | 5 | 20/1 | | | | 20/1 | 6 | SPARE |
| RECEPTACLES | 7 | 20/1 | | | | 20/1 | 8 | RECEPTACLES |
| RECEPTACLES | 9 | 20/1 | | | | 20/1 | 10 | RECEPTACLES |
| RECEPTACLES | 11 | 20/1 | | | | 20/1 | 12 | RECEPTACLES |
| RECEPTACLES | 13 | 20/1 | | | | 20/1 | 14 | RECEPTACLES |
| RECEPTACLES | 15 | 20/1 | | | | 20/1 | 16 | RECEPTACLES |
| RECEPTACLES | 17 | 20/1 | | | | 20/1 | 18 | RECEPTACLES |
| RECEPTACLES | 19 | 20/1 | | | | 20/1 | 20 | RECEPTACLES |
| RECEPTACLES | 21 | 20/1 | | | | 20/1 | 22 | RECEPTACLES |
| RECEPTACLES | 23 | 20/1 | | | | 20/1 | 24 | RECEPTACLES |
| RECEPTACLES | 25 | 20/1 | | | | 20/1 | 26 | RECEPTACLES |
| CU-4 | 27 | 40/3 | | | | 60/3 | 28 | AHU-4 |
| | 29 | | | | | | 30 | |
| | 31 | | | | | | 32 | |
| SPARE | 33 | 20/1 | | | | 20/1 | 34 | SPARE |
| SPARE | 35 | 20/1 | | | | 20/1 | 36 | SPARE |
| SPARE | 37 | 20/1 | | | | 20/1 | 38 | SPARE |
| SPARE | 39 | 20/1 | | | | 20/1 | 40 | SPARE |
| SPARE | 41 | 20/1 | | | | 20/1 | 42 | SPARE |

LOADS: LIGHTING – 6KVA
RECEPTACLES – 15.2KVA
HVAC (HEATING MODE) – 20KVA
IFC LOAD – 114A

## PANEL "LE"

120/208V, 3ø, 4W, 200A MAINS, M.C.B., S/N, SURFACE MTD., 42,000 A.I.C

| TYPE LOAD | CKT NO. | BRKR | BUS A | BUS B | BUS C | BRKR | CKT NO. | TYPE LOAD |
|---|---|---|---|---|---|---|---|---|
| LIGHTING | 1 | 20/1 | | | | 20/1 | 2 | LIGHTING |
| LIGHTING | 3 | 20/1 | | | | 20/1 | 4 | LIGHTING |
| LIGHTING | 5 | 20/1 | | | | 20/1 | 6 | LIGHTING |
| LIGHTING | 7 | 20/1 | | | | 20/1 | 8 | SPARE |
| RECEPTACLES | 9 | 20/1 | | | | 20/1 | 10 | RECEPTACLES |
| RECEPTACLES | 11 | 20/1 | | | | 20/1 | 12 | RECEPTACLES |
| RECEPTACLES | 13 | 20/1 | | | | 20/1 | 14 | RECEPTACLES |
| RECEPTACLES | 15 | 20/1 | | | | 20/1 | 16 | RECEPTACLES |
| RECEPTACLES | 17 | 20/1 | | | | 20/1 | 18 | RECEPTACLES |
| RECEPTACLES | 19 | 20/1 | | | | 20/1 | 20 | RECEPTACLES |
| RECEPTACLES | 21 | 20/1 | | | | 20/1 | 22 | RECEPTACLES |
| RECEPTACLES | 23 | 20/1 | | | | 20/1 | 24 | RECEPTACLES |
| RECEPTACLES | 25 | 20/1 | | | | 20/1 | 26 | RECEPTACLES |
| CU-5 | 27 | 40/3 | | | | 60/3 | 28 | AHU-5 |
| | 29 | | | | | | 30 | |
| | 31 | | | | | | 32 | |
| SPARE | 33 | 20/1 | | | | 20/1 | 34 | SPARE |
| SPARE | 35 | 20/1 | | | | 20/1 | 36 | SPARE |
| SPARE | 37 | 20/1 | | | | 20/1 | 38 | SPARE |
| SPARE | 39 | 20/1 | | | | 20/1 | 40 | SPARE |
| SPARE | 41 | 20/1 | | | | 20/1 | 42 | SPARE |

LOADS: LIGHTING – 6.8KVA
RECEPTACLES – 12.6KVA
HVAC (HEATING MODE) – 20KVA
IFC LOAD – 109A

## PANEL "HP"

120/208V, 3ø, 4W, 200A MAINS, M.L.O., S/N, SURFACE MTD., 42,000 A.I.C

| TYPE LOAD | CKT NO. | BRKR | BUS A | BUS B | BUS C | BRKR | CKT NO. | TYPE LOAD |
|---|---|---|---|---|---|---|---|---|
| LIGHTING | 1 | 20/1 | | | | 20/1 | 2 | LIGHTING |
| LIGHTING | 3 | 20/1 | | | | 20/1 | 4 | SPARE |
| SPARE | 5 | 20/1 | | | | 20/1 | 6 | SPARE |
| SPARE | 7 | 20/1 | | | | 20/1 | 8 | SPARE |
| SPARE | 9 | 20/1 | | | | 20/1 | 10 | SPARE |
| SPARE | 11 | 20/1 | | | | 20/1 | 12 | SPARE |

LOADS: LIGHTING – 3KVA
IFC LOAD – 8.5A

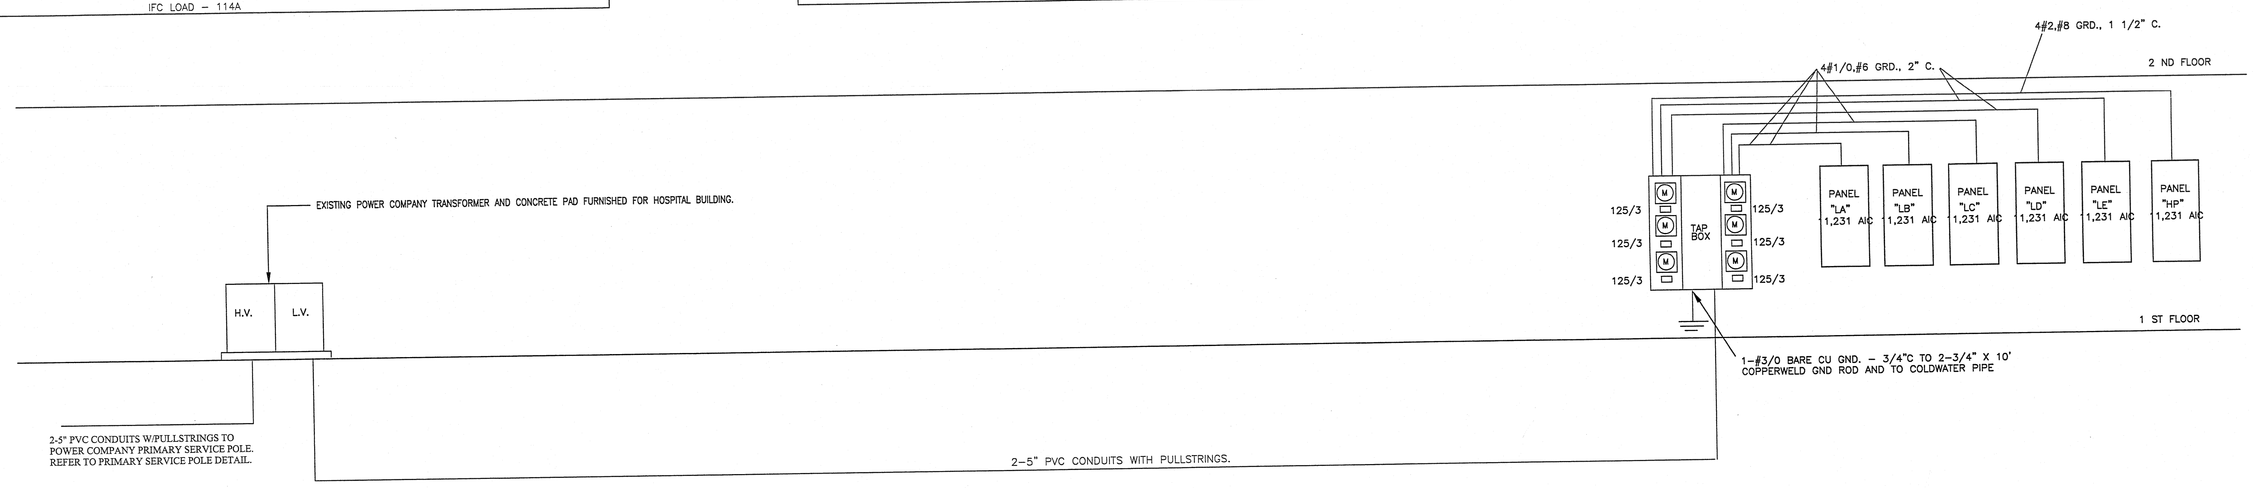


1 / E.2 POWER RISER DIAGRAM
NO SCALE

Date: APRIL 24, 2002
Drawn By: MC
Checked By: SJ
Revisions:

Project Number: 01134

This drawing is the property of ROZAS•WARD/a.i.a. architects, and is not to be reproduced or copied in whole or in part. It is only to be used for the project and site specifically identified herein.

Scales as stated hereon are valid on the original drawing only.

ROZAS • WARD \ a.i.a. architects
a professional corporation
1010 Common Street . Suite 2760 . New Orleans . Louisiana 70112 . (504)524-4375

Medical Office Building
Slidell, Louisiana

As Builts
4-11-03
JACK'S ELECTRIC SERVICE, INC.
LICENSED ELECTRICAL CONTRACTOR
537 BARONNE STREET
NEW ORLEANS, LOUISIANA 70130
(540) 581-4408

E.2
drawing
set no.