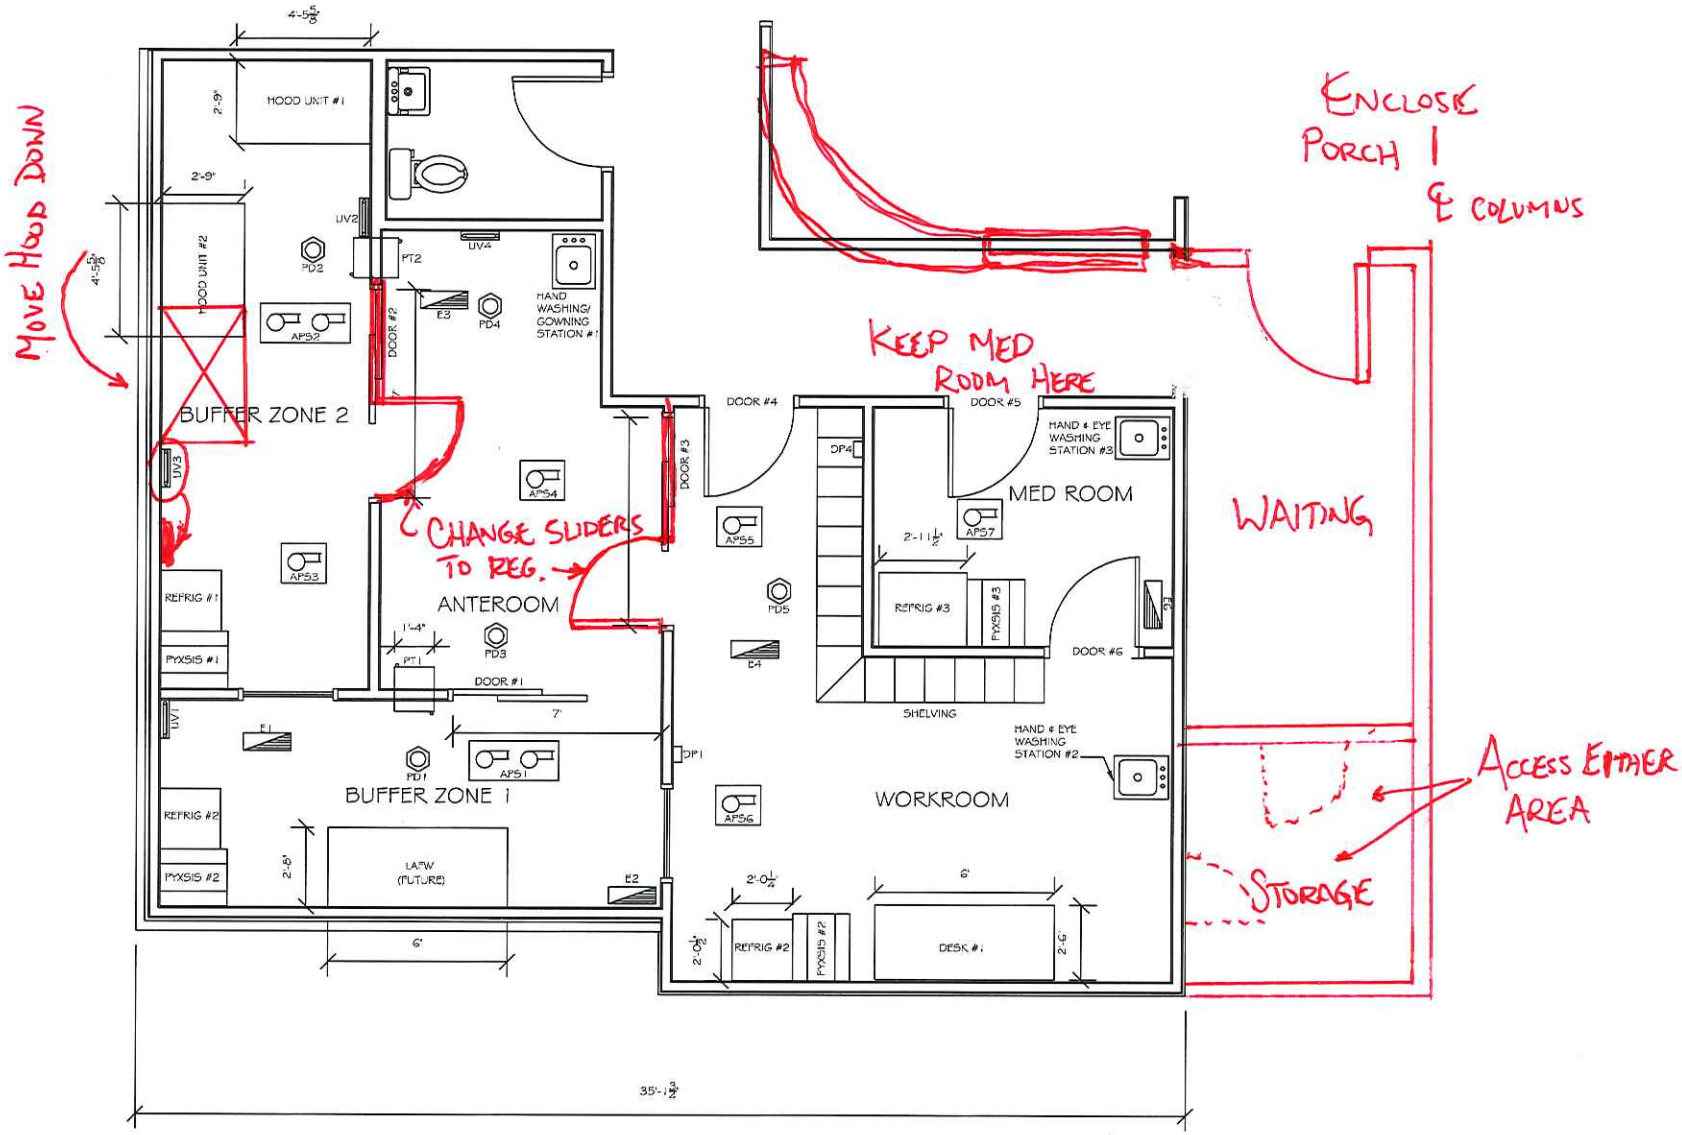
MOVE HOOD DOWN
HOOD UNIT #1
HOOD UNIT #2
BUFFER ZONE 2
UV2
UV3
UV4
UV1
PD2
PT2
DOOR #2
E3
PD4
HAND WASHING/ GOWNING STATION #1
AP52
AP53
AP54
REFRIG #1
PYXSIS #1
ANTEROOM
PD3
PT1
DOOR #1
E1
PD1
AP51
BUFFER ZONE 1
REFRIG #2
PYXSIS #2
LAFW (FUTURE)
E2
DOOR #3
DOOR #4
AP55
PD5
E4
DP1
AP56
WORKROOM
DP4
SHELVING
DOOR #5
HAND & EYE WASHING STATION #3
MED ROOM
AP57
REFRIG #3
PYXSIS #3
DOOR #6
HAND & EYE WASHING STATION #2
REFRIG #2
PYXSIS #2
DESK #1
KEEP MED ROOM HERE
CHANGE SLIDERS TO REG.
ENCLOSE PORCH & COLUMNS
WAITING
STORAGE
35'-1 3/2"