



01 DIMENSION FLOOR PLAN

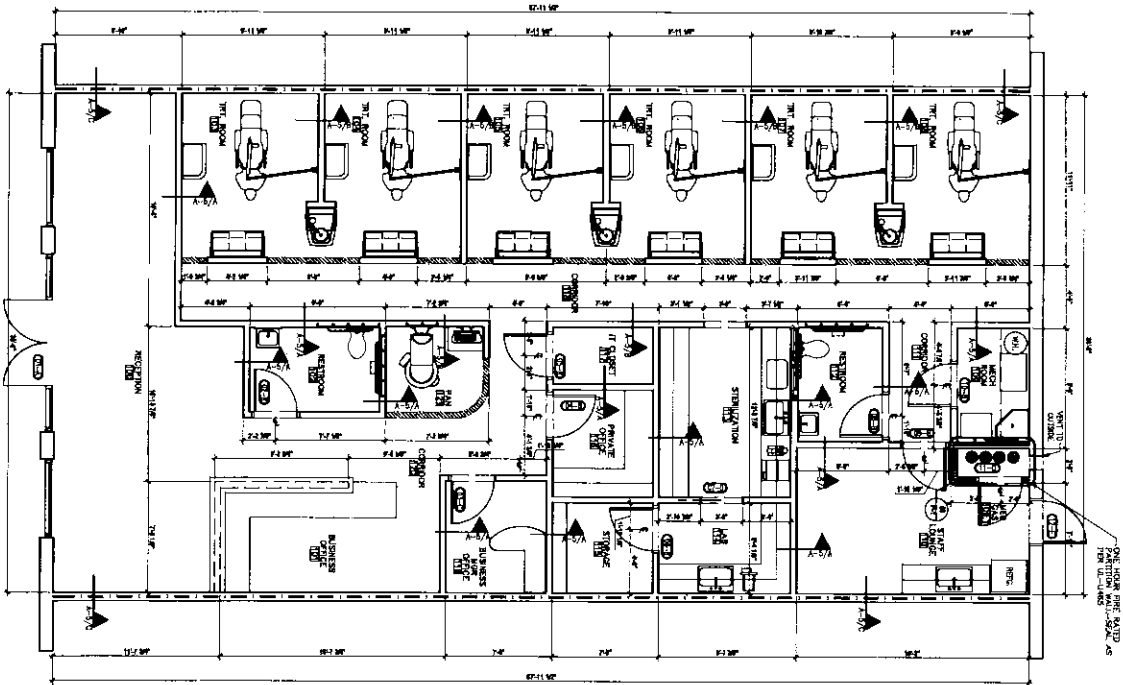

ONE HOUR FIRE RATED FROM THIS WALL AS SHOWN

02 TYPICAL WALL BACKING DETAIL

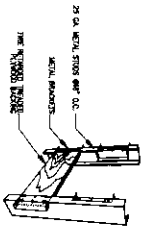

2x4 WOOD STUD @ 16" O.C.

METAL ANCHORS

1/2" GYPSUM BOARD

WALL LEGEND	
	EXISTING EXTERIOR WALL
	1-HOUR FIRE RATED DEMISING WALL
	PARTITION WALL
	NEW 1-HR FIRE RATED PARTITION WALL
	WALL BLOOMING - RE-A-1/02
	HEADER - 7'-0" A.F.F.


NOTE: EXISTING CEILING SHALL BE REFINISHED TO MATCH THE NEW CEILING. ALL NEW WALLS SHALL BE FINISHED TO MATCH THE EXISTING FINISH. 

NOTE: SEE SHEET R-4 FOR CEILING HEIGHTS


	MINT DENTISTRY - TERRELL 250 America Way, Suite 200 TERRELL, TEXAS 75146	REVISIONS:	DENTAL CONSTRUCTION SPECIALIST 8664 N. CENTRAL EXPY, SUITE 406 DALLAS, TEXAS PHONE: 214-796-8888 FAX: 214-272-8918 www.MINTdentistry.com		
	DATE: 08/11/02 DRAWN BY: [blank] CHECKED BY: [blank] SCALE: 1/4" = 1'-0"	SHEET TITLE: DIMENSION FLOOR PLAN			

01 FINISH FLOOR PLAN

SCALE

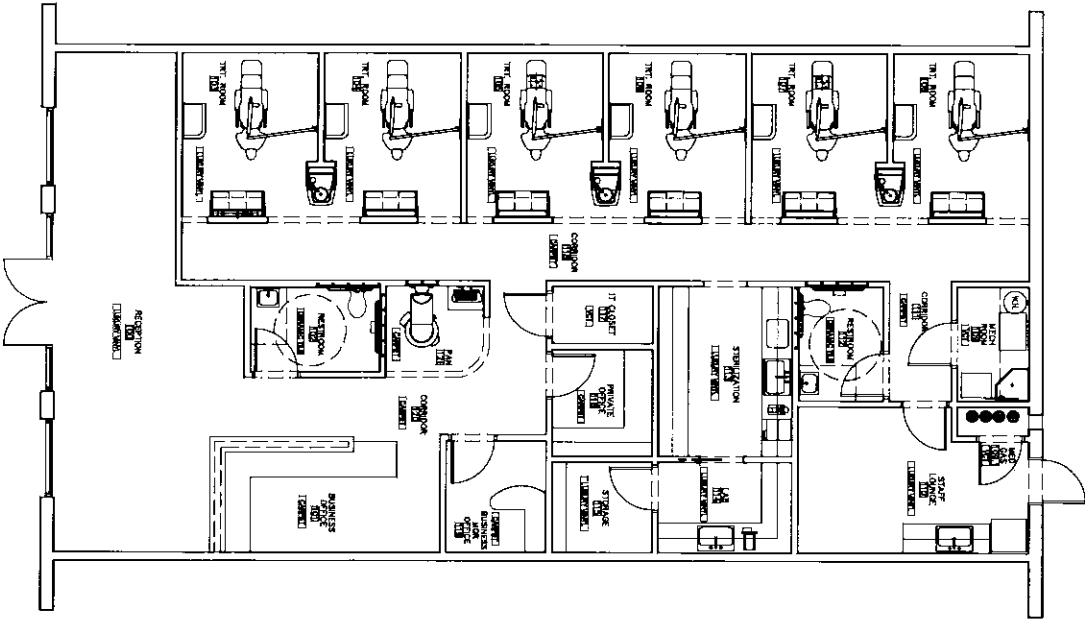

	DATE: 08/08/10 DRAWN BY: J. J. J. CHECKED BY: J. J. J. SCALE: 1/8" = 1'-0"	MINT DENTISTRY - TERRELL 800 America Way, Suite 200 TERRELL, TEXAS 75119	DENTAL CONSTRUCTION SPECIALIST 6866 N. CENTRAL EXPY, SUITE 400 DALLAS, TEXAS PHONE: 214-736-8888 FAX: 214-272-8818 www.MINTdentistry.com		
	SHEET TITLE: FINISH FLOOR PLAN	SHEET NO.: A-3			

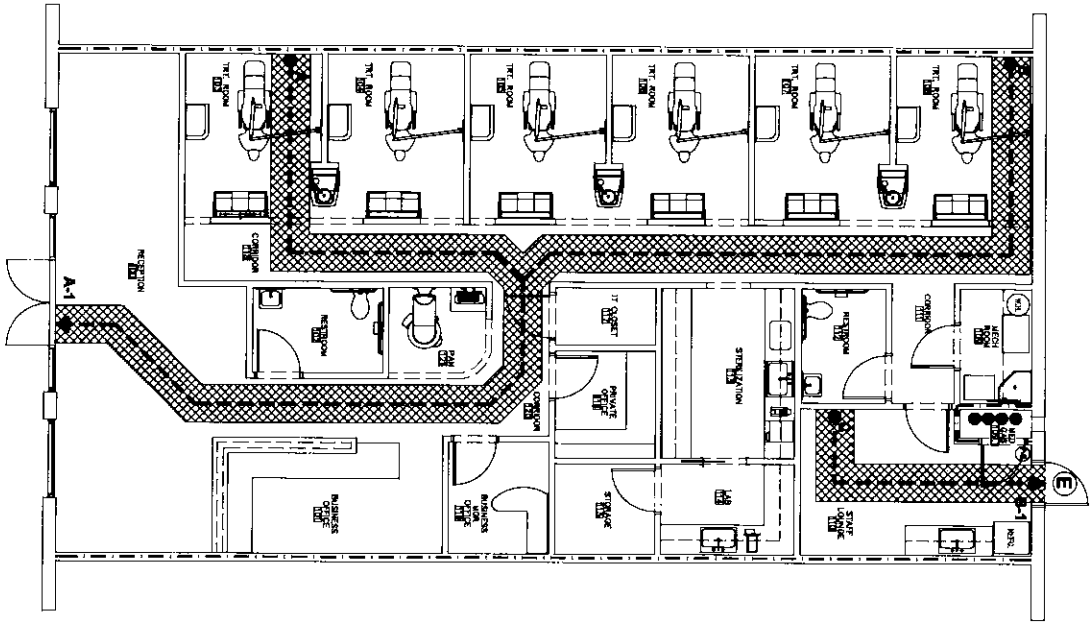

01 LIFE SAFETY PLAN





TRAVEL DISTANCE	
TRAVEL DISTANCE FROM POINT A TO A-1-B-2-C-2	TRAVEL DISTANCE FROM POINT B TO B-1-B-2-C-2
TRAVEL DISTANCE FROM POINT A TO A-1-B-2-C-2	TRAVEL DISTANCE FROM POINT B TO B-1-B-2-C-2






LIFE SAFETY LEGEND	
	ONE FROM FIRE WALL
	TRAVEL DISTANCE
	TRAVEL PLAN
	EXIT
	FIRE EXTINGUISHER

	<p>MINT DENTISTRY - TERRELL 606 America Way suite 200 TERRELL, TEXAS 75148</p>	<p>REVISIONS:</p>	<p>DENTAL CONSTRUCTION SPECIALIST 5664 N. CENTRAL EXPY., SUITE 400 DALLAS, TEXAS PHONE: 214-726-4868 FAX: 214-272-8816 www.MINTdentistry.com</p>
<p>DATE: 10/10/11 DRAWN BY: [Name] CHECKED BY: [Name] SCALE: 1/8" = 1'-0"</p>	<p>SHEET TITLE: LIFE SAFETY PLAN</p>		


PARTITION TYPES

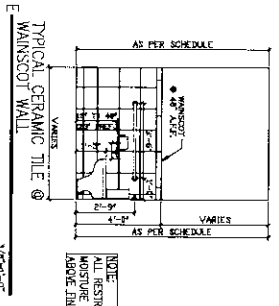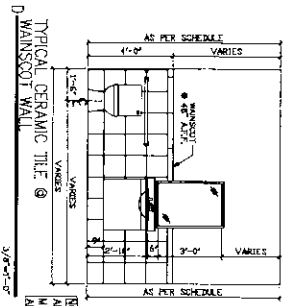


MOUNTING HEIGHTS

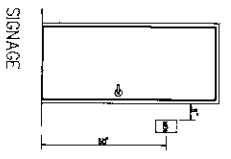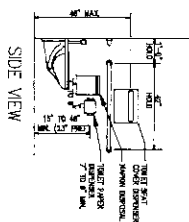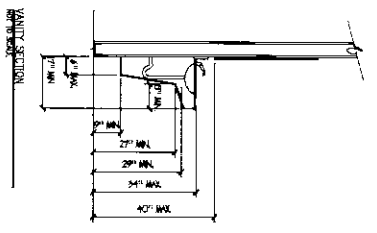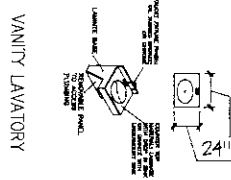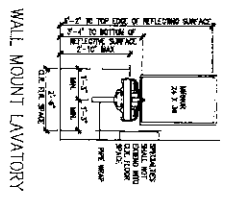


DOOR INSTALLATION GUIDELINES

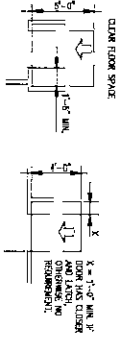

FORWARD APPROACH

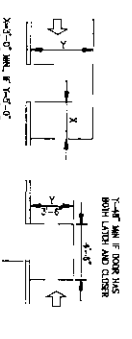

SIDE APPROACH - HINGE

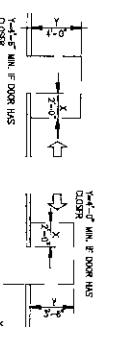


SIDE APPROACH - LATCH



	MINT DENTISTRY - TERRELL 606 America Way Suite 200 TERRELL, TEXAS 78168	DENTAL CONSTRUCTION SPECIALIST 6666 N. CENTRAL EXPY, SUITE 406 DALLAS, TEXAS PHONE: 214-776-4888 FAX: 214-772-8815 www.MINTdentistry.com
	SHEET TITLE: PARTITION WALL TYPES AND DETAILS	SHEET: 1 OF 1

01 MECHANICAL PLAN

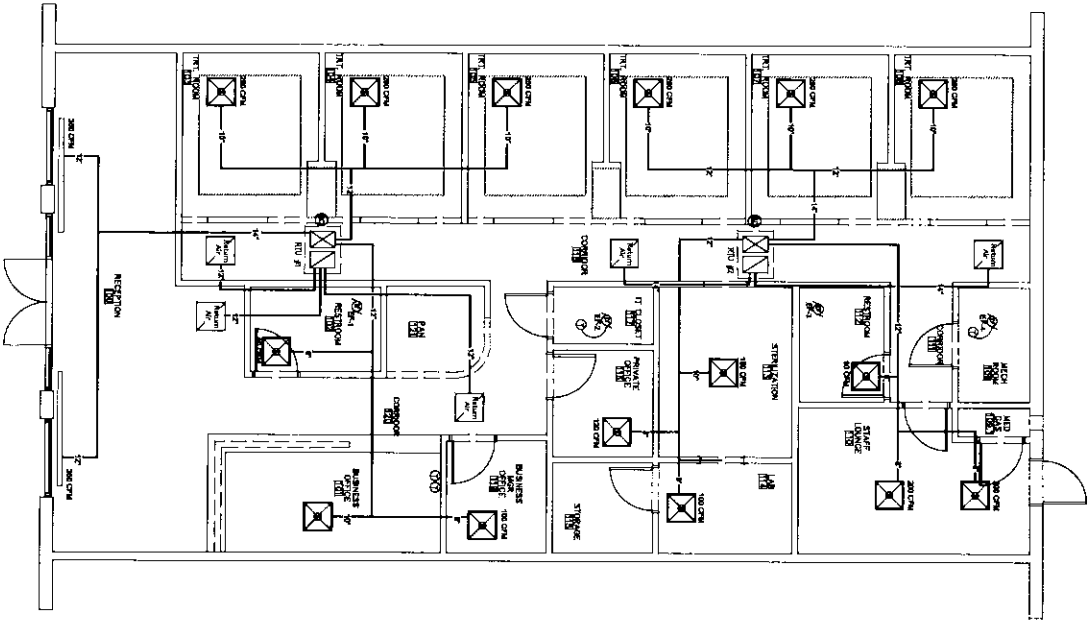


R.T.U. AND EXHAUST FANS INFORMATION

SYMBOL LEGEND


	ZONE SUPPLY AIR CIRCUIT
	ZONE RETURN AIR INTAKE
	EXHAUST FAN
	EXHAUST FAN RETURN TO OUTSIDE
	E-SW
	EXHAUST FAN TEST LIGHT



	MINT DENTISTRY - TERRELL 606 America Way suite 200 TERRELL, TEXAS 75169	DENTAL CONSTRUCTION SPECIALIST 6864 N. CENTRAL EXPY., SUITE 406 DALLAS, TEXAS PHONE: 214-736-4886 FAX: 214-272-8816 www.MINTdentistry.com		M. E. N. P. ENGINEERS - REGISTRATION F-12249 144 NORTH SPRING CREEK DRIVE RICHARDSON, TEXAS EMAIL: KOHSHI1@AOL.COM
	SHEET TITLE: MECHANICAL PLAN	SHEET NO.: 01	DATE: 01/11/01	DRAWN BY: J. COOPER

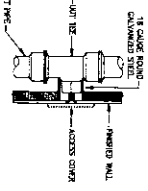


04 WALL CLEAN-OUT DETAIL
N.T.S.

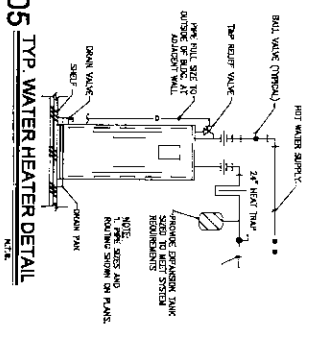


05 TYP WATER HEATER DETAIL
N.T.S.

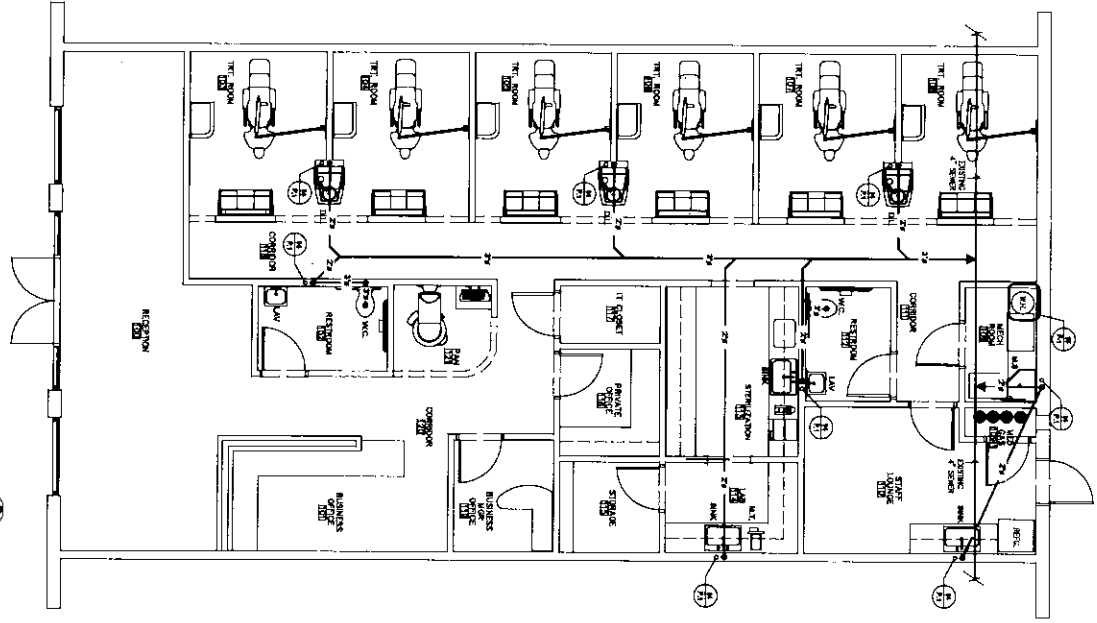

01 PLUMBING PIPING PLAN
N.T.S.

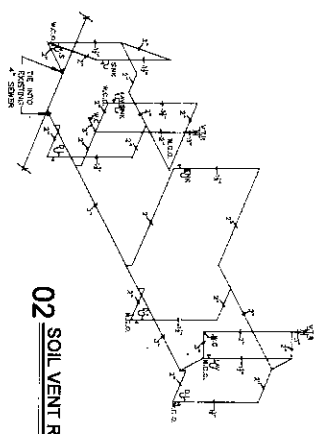

02 SOIL VENT RISER
N.T.S.

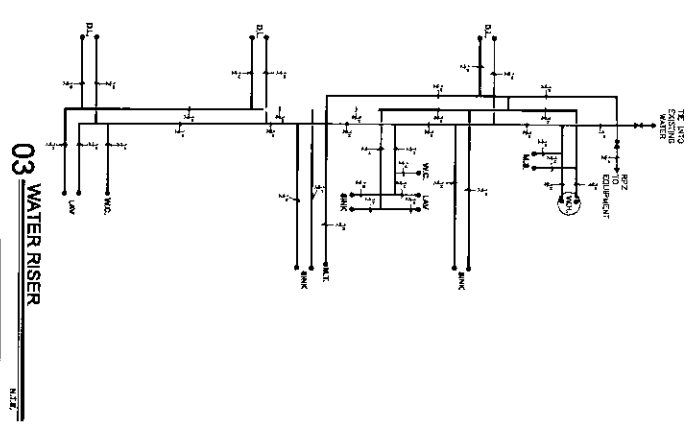

03 WATER RISER
N.T.S.

PLUMBING PIPING LEGEND	
—	HOT WATER
—	COLD WATER
—	SEWAGE/STACK
—	VENT

PLUMBING PIPING LEGEND	
—	SOIL VENT
—	VENT
—	DRY DRAIN
—	WET DRAIN
—	WATER HEATER
—	WATER HEATER

P.1

MINI dentistry

MINI DENTISTRY - TERRELL
806 America Way suite 200
TERRELL, TEXAS 75169



REVISIONS:

SHEET TITLE: **PLUMBING PLAN**

DENTAL CONSTRUCTION SPECIALIST
5884 N. CENTRAL EXPY., SUITE 406
DALLAS, TEXAS
PHONE: 214-726-4888
FAX: 214-722-8816
www.MINIDentistry.com



M. E. N. P. ENGINEERS
REGISTRATION F-12248
124 NORTH SPRING CREEK DRIVE
RICHLANDS, TEXAS
EMAIL: KCHSHITI@AOL.COM

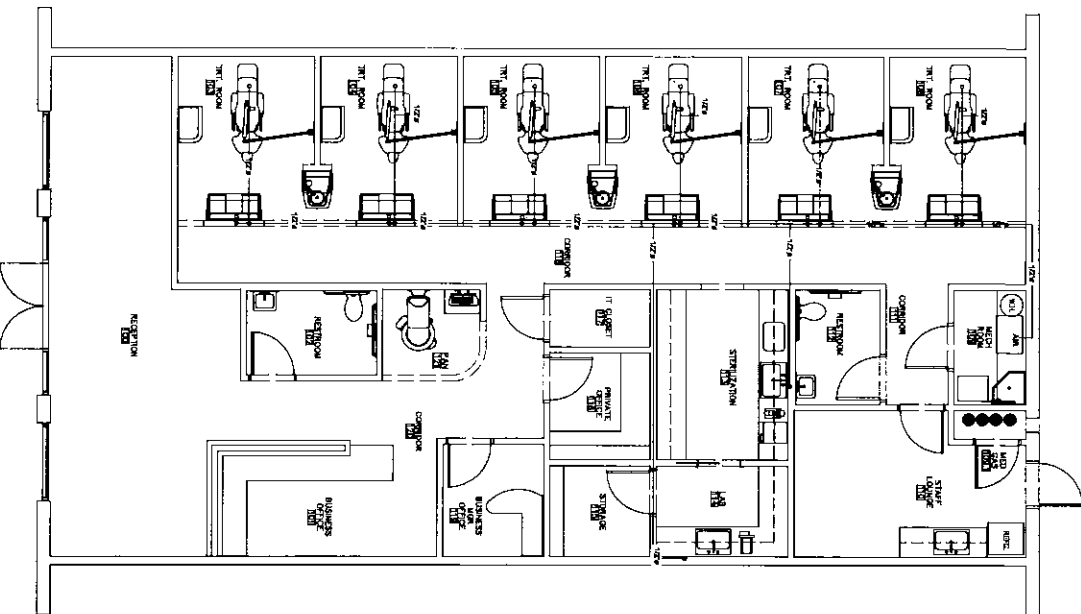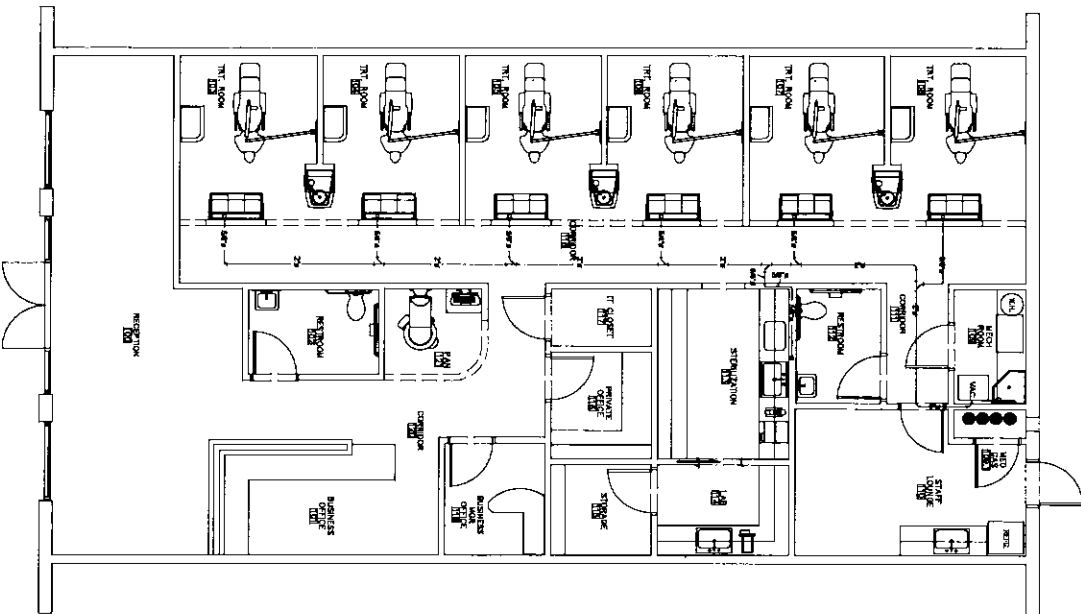

PLUMBING PIPING LEGEND

NOTE: ALL VACUUM PIPING INSTALLATION SHALL COMPLY WITH THE 2010 IBC IN TEXAS.

VACUUM PIPING: VACUUM, AIR LINE, HYDROBULB AS SHOWN, COPPER (TYPE-L)

P.1.1

DATE: 08/08/10
 DRAWN: J. B. BROWN
 CHECKED: J. B. BROWN
 SCALE: 1/8" = 1'-0"

MINT dentistry

REVISIONS:



SHEET TITLE: AIR & VACUUM PIPING PLAN

DENTAL CONSTRUCTION SPECIALIST
 1666 N. CENTRAL EXPY., SUITE 400
 DALLAS, TEXAS
 PHONE: 214-736-6998
 FAX: 214-272-8816
 www.MINTdentistry.com



M. E. N. P. ENGINEERS
 REGISTRATION F-12249
 124 NORTH SPRING CREEK DRIVE
 RICHARDSON, TEXAS
 EMAIL: KCHISHTI@AOL.COM


Mint Terrell LIGHTING

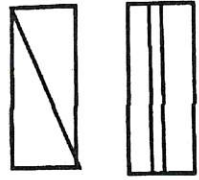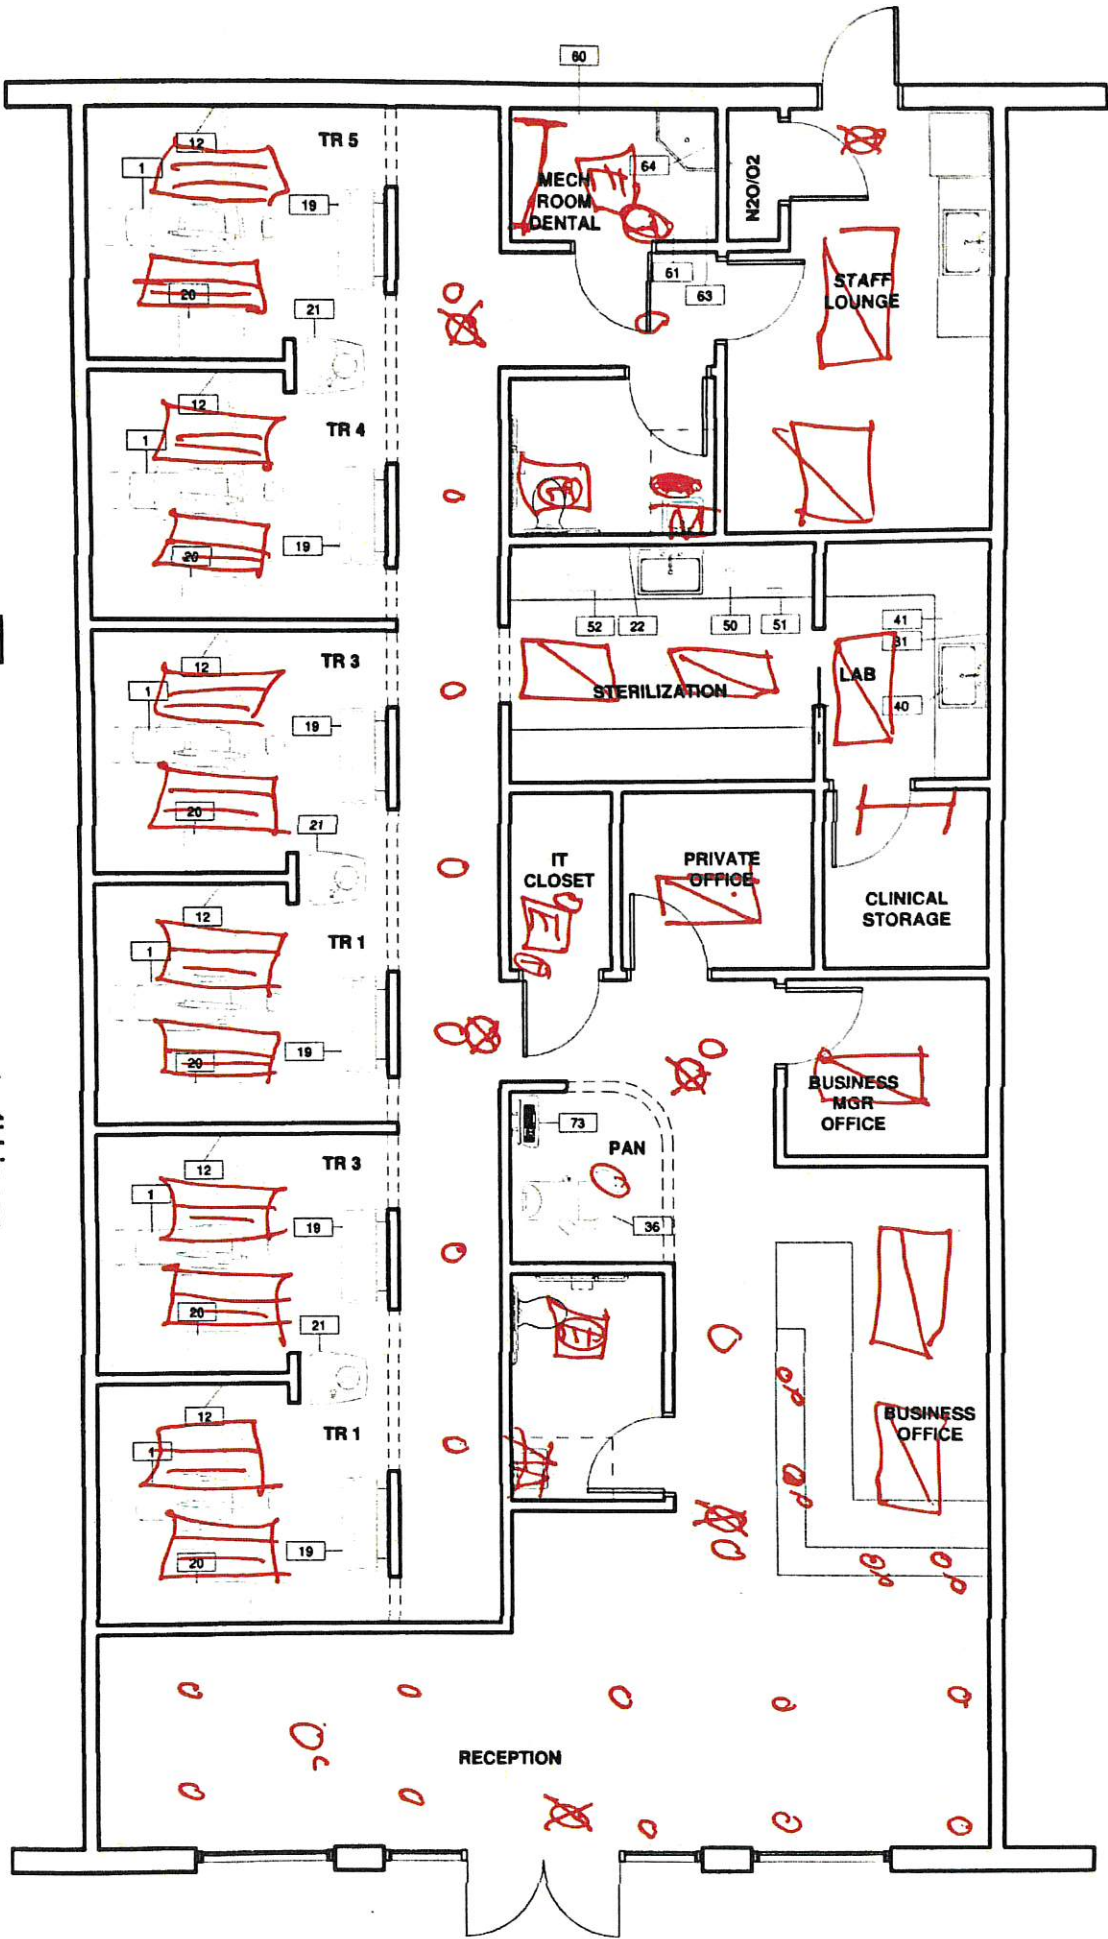

2x4 3 Bulb Ovation
2x4 3 Bulb Linear Fluorescent



Exhaust
Thermostat
Pendant

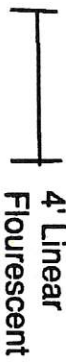

4' Linear Fluorescent



Vanity Lights




Illuminated EXIT Light




6" Can Light

Emergency Fixtures as Required

Channel

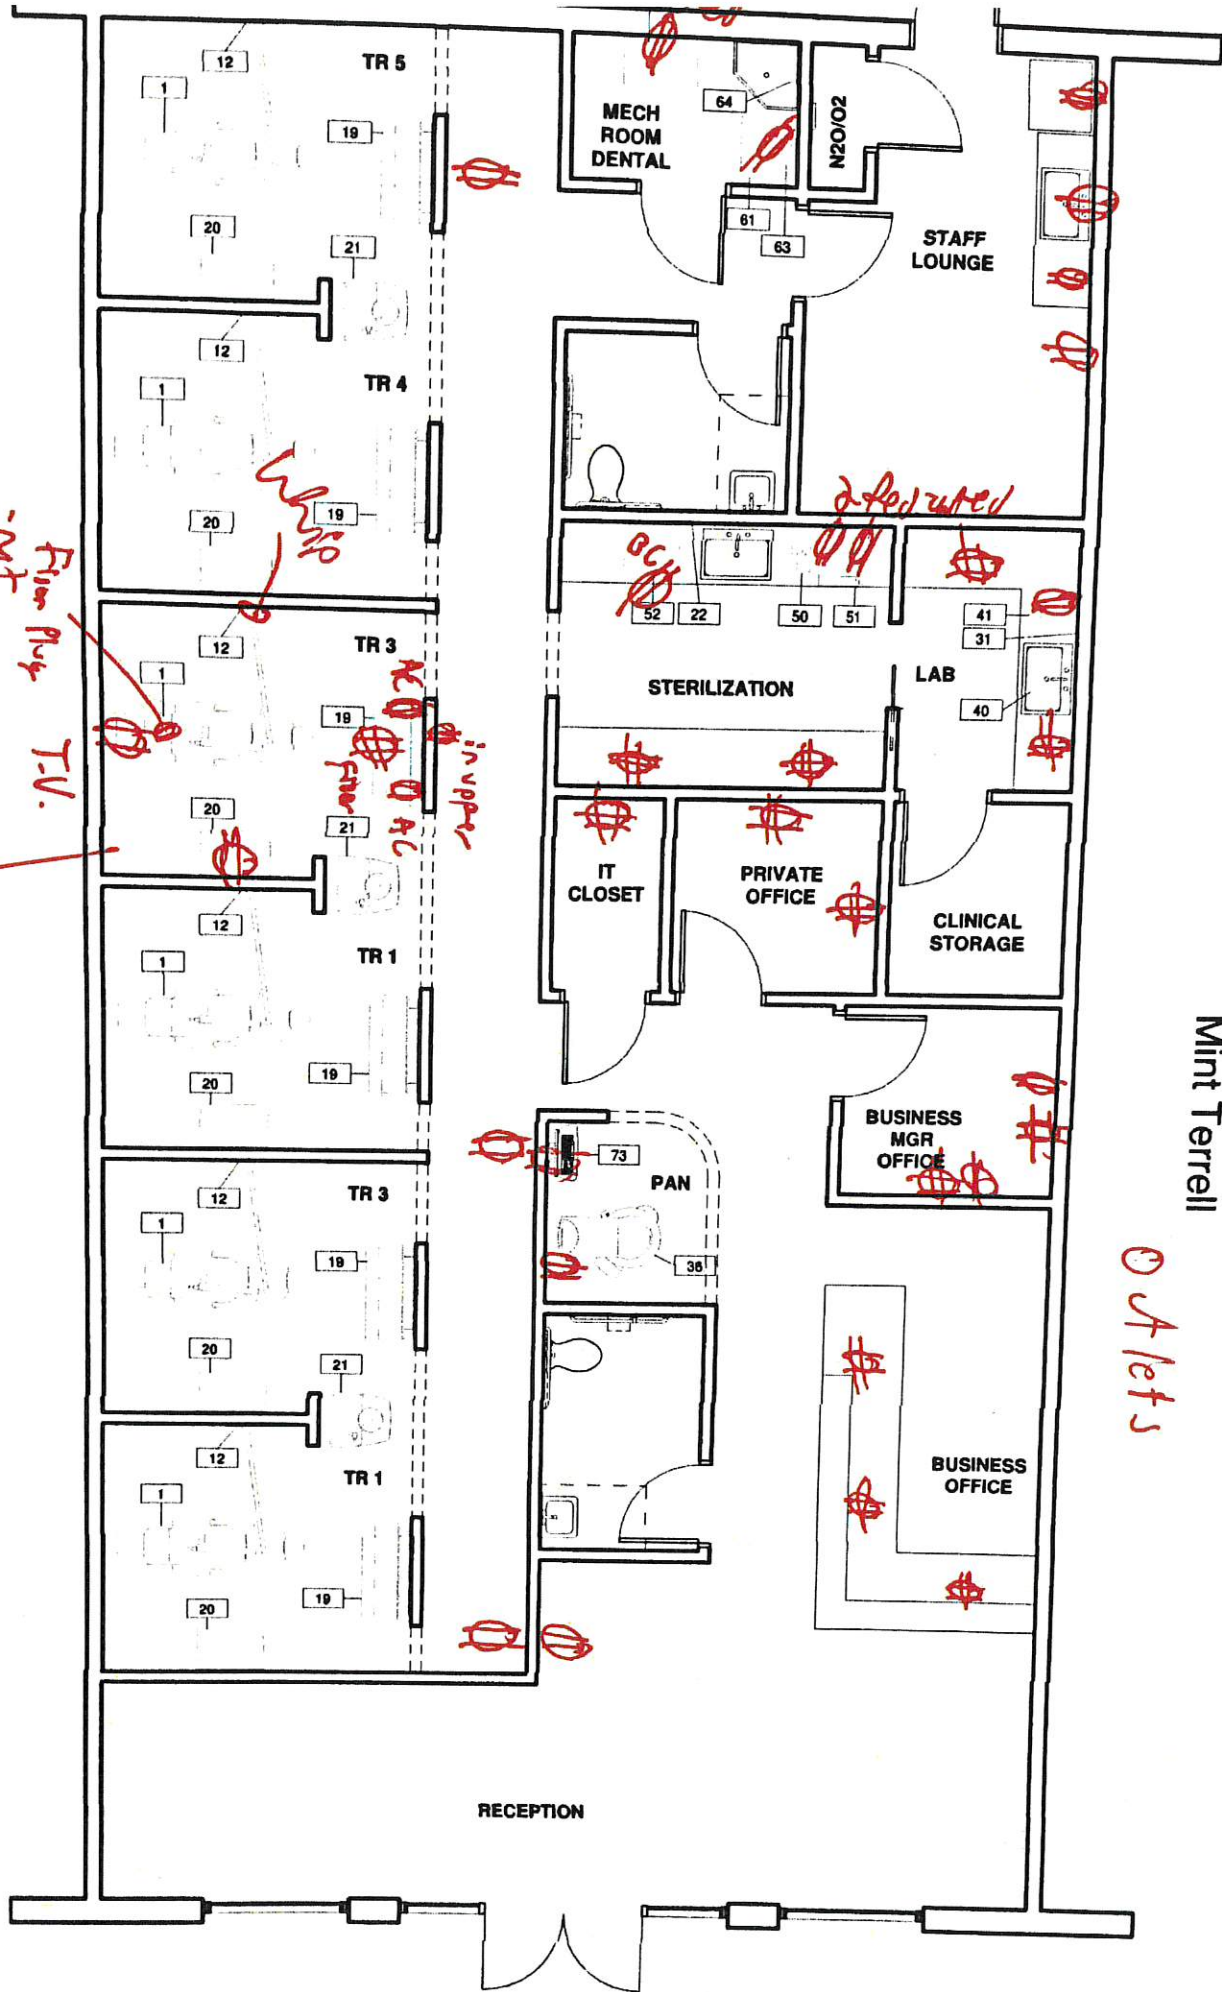

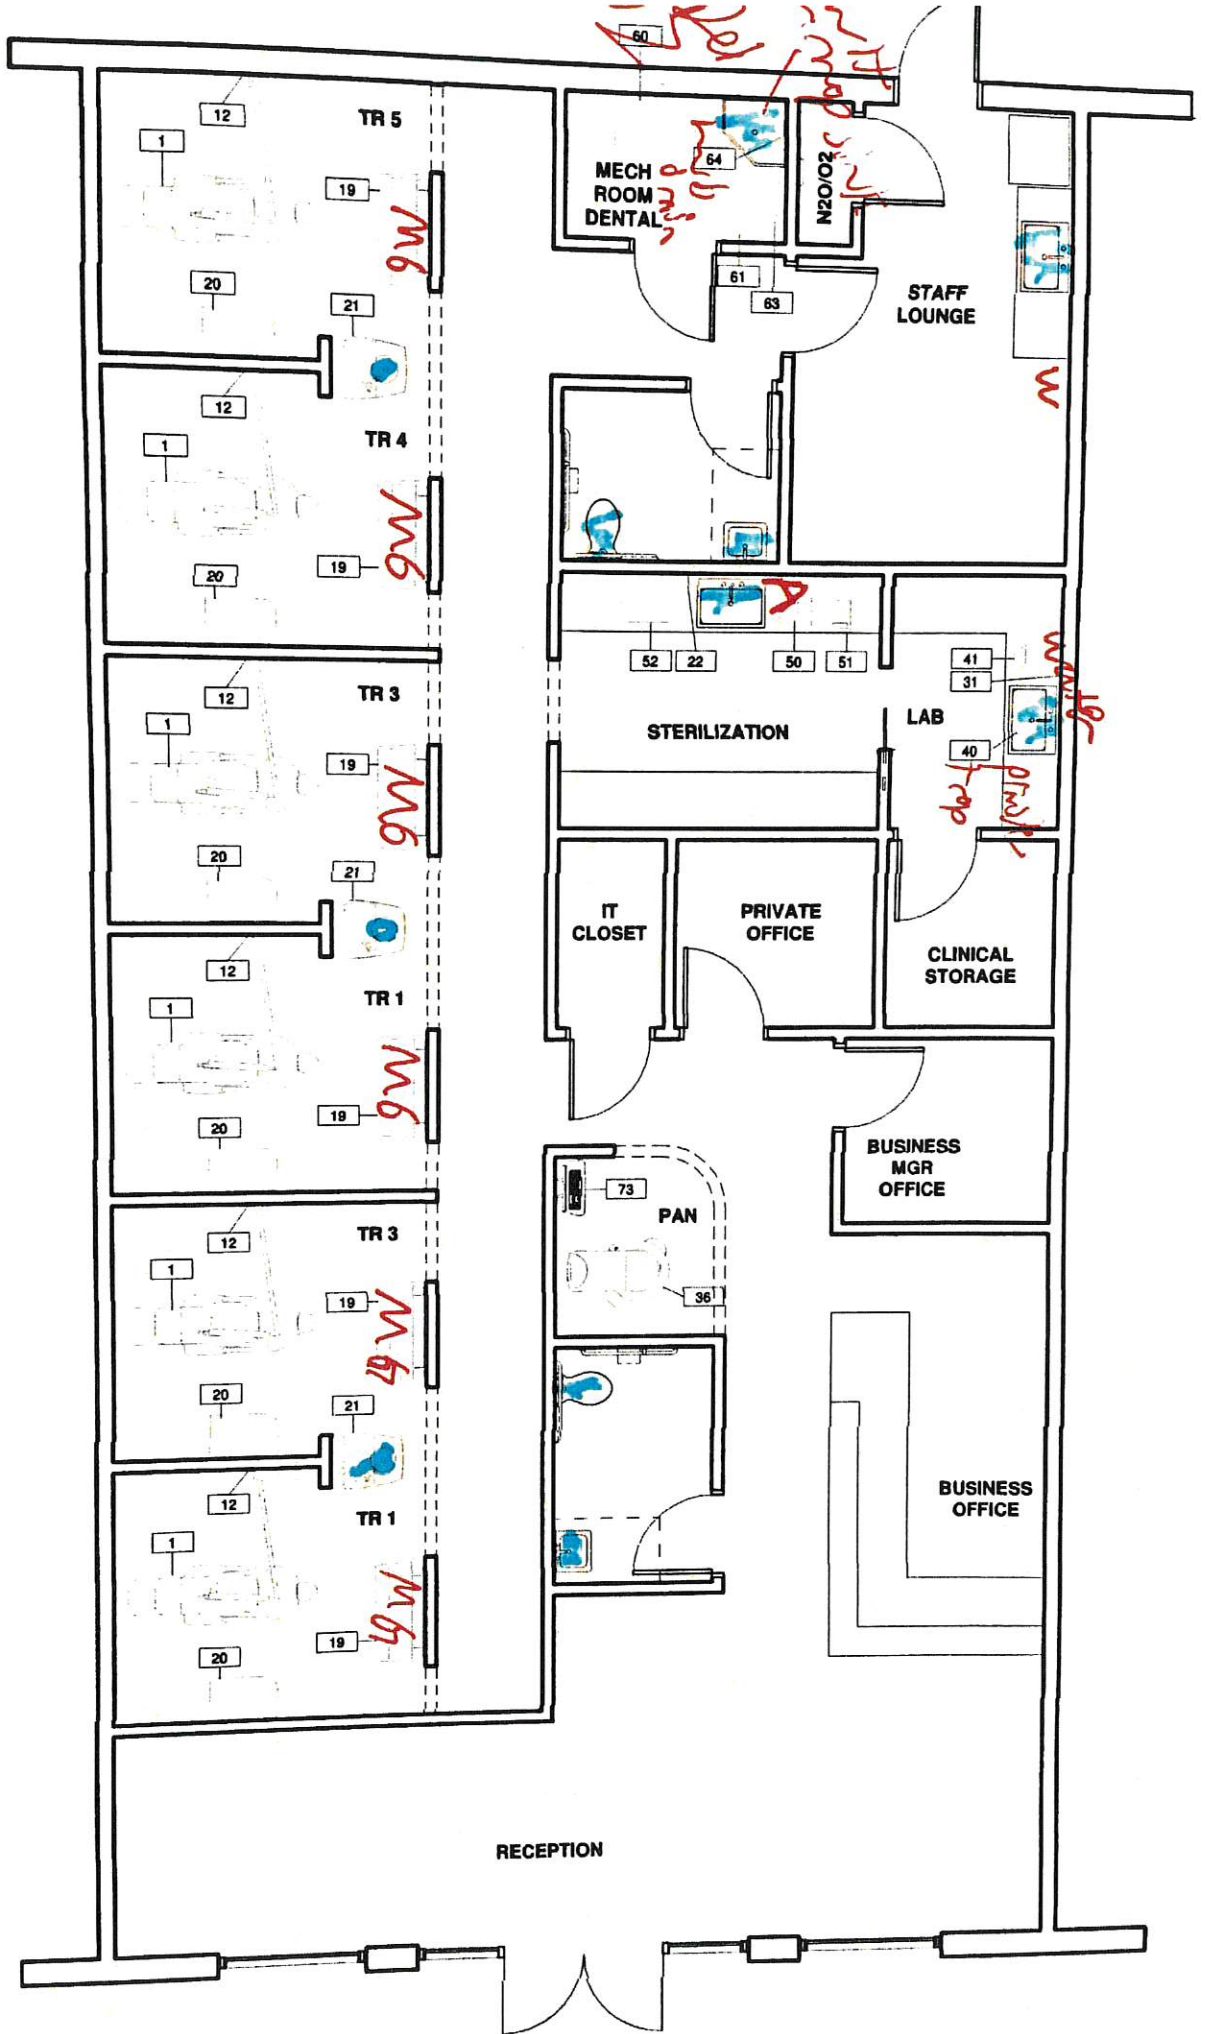

MG = NO2, O2, Vacuum and Compressed air

A = Air

V = Vacuum

W = water line

PLUMBING



GABRIEL BUILDING SUPPLY

AMITE

900 West Oak St.

Amite, LA 70422

PHONE: (985) 748-3525

Receipt REQUIRED for Return or Exchange
Returns Subject to 20% Service Charge

SOLD TO:

K B KAUFMANN & CO INC
3173 TERRACE AVE EAST
SLIDELL
(985) 849-7381
LA 70458

CUSTOMER NO: 482

TERMS: NET 10TH

DATE / TIME: 7/28/21 7:30

CLERK / TERM: BLA

SALESPERSON: BRENDA ANDRESS

TAX CODE: A

CITY OF AMITE

SHIP TO:

JOB NO: 000
DUE DATE: 8/10/21

INVOICE: 70244 / 2

QUANTITY	UM	ITEM	DESCRIPTION	UNITS	LOCATION	PRICE	PER	EXTENSION
2	EA	16116	2" x .099 Bright Screw Coil Nail	2	06N02	52.99	EA	105.98
			** AMOUNT CHARGED TO STORE ACCOUNT **	117.05				
			TAXABLE					105.98
			NON-TAXABLE					0.00
			SUB-TOTAL					105.98
			TAX AMOUNT					11.07
			TOTAL AMOUNT					117.05

X.M. [Signature]

Received By

(GEORGE MCCLENDON)

^ b

482000 70244