


Mint Terrell

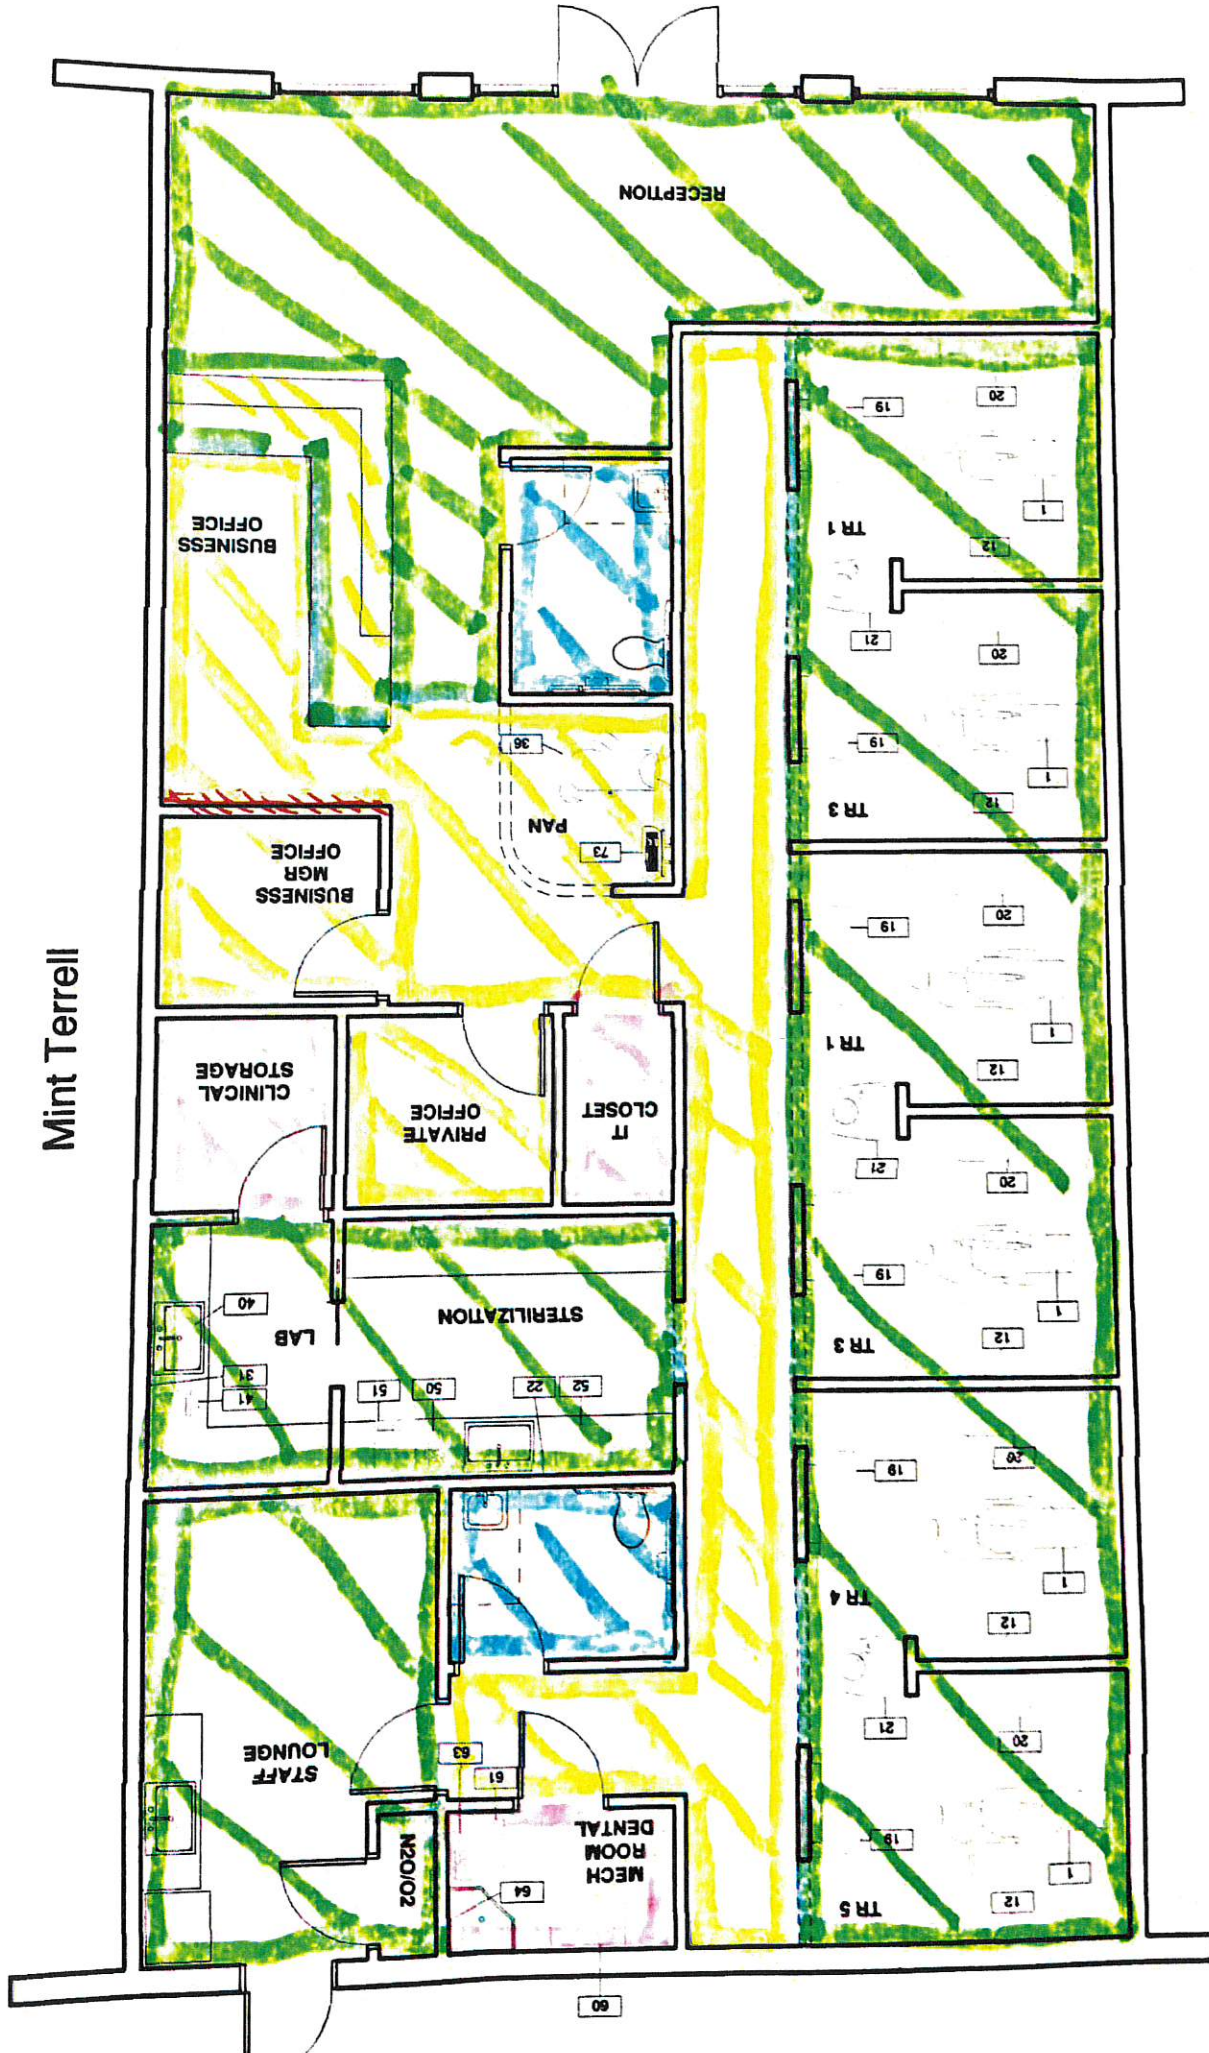

ACCENT WALL



CARPET

TILE

VCT

LVT

FLOORING